

TEMPORARY AND DURABLE 100mm YELLOW LINE

STA. 3+760.0 TO STA. 3+822.2 SOLID LT. AND RT.
 (WITH CENTERLINE BREAK FOR SIDE ROADS)
 STA. 3+822.2 TO STA. 3+918.8 SOLID LT. AND DASHED RT.
 STA. 3+918.8 TO STA. 4+023.4 DASHED
 STA. 4+023.4 TO STA. 4+248.7 DASHED LT. AND SOLID RT.
 STA. 4+248.7 TO STA. 4+460.0 SOLID LT. AND RT.
 STA. 3+780.4 LT. (OLD U.S. ROUTE 7)
 STA. 3+780.4 RT. (OLD U.S. ROUTE 7)

TEMPORARY AND DURABLE 100mm WHITE LINE

STA. 3+760.0 TO STA. 4+460.0 SOLID LT. AND RT. (EDGE LINE)
 (WITH EDGE LINE BREAK FOR SIDE ROADS)

TEMPORARY AND DURABLE 600mm STOP BAR

STA. 3+780.4 LT. (OLD U.S. ROUTE 7)
 STA. 3+780.4 RT. (OLD U.S. ROUTE 7)

TEMPORARY AND DURABLE LETTER OR SYMBOL

STA. 3+780.4 LT. - "STOP" (OLD U.S. ROUTE 7)
 STA. 3+780.4 RT. - "STOP" (OLD U.S. ROUTE 7)

ANCHOR FOR STEEL BEAM RAIL
 3+780 LT.
 3+775 LT.

MANUFACTURED TERMINAL SECTION (FLARED)

STA. 3+787.0 LT. TO STA. 3+798.4 LT.
 STA. 3+818.0 RT. TO STA. 3+829.4 RT.
 STA. 4+053.6 LT. TO STA. 4+065.0 LT.
 STA. 4+072.6 RT. TO STA. 4+084.0 RT.
 STA. 4+253.0 LT. TO STA. 4+264.4 LT.

REMOVAL AND DISPOSAL OF GUARD RAIL

STA. 3+787.0 LT. TO STA. 4+065.0 LT.
 STA. 3+818.0 RT. TO STA. 3+829.4 RT.
 STA. 4+072.6 RT. TO STA. 4+084.0 RT.
 STA. 4+253.0 LT. TO STA. 4+264.4 LT.

NEW STEEL BEAM GUARDRAIL
 STA. 3+798.4 LT. TO STA. 4+053 LT.

SHOULDER BERM REMOVAL


STA. 3+798 LT. TO STA. 4+054 LT.
 STA. 3+829 RT. TO STA. 4+073 RT.
 STA. 4+264 LT. TO STA. 4+460 LT.

REMOVING SIGNS

57 -- AS SHOWN

DURABLE 100mm YELLOW LINE (THERMO-PLASTIC)
 STA. 4+250 TO STA. 4+460 +/- (LT. & RT.)

DURABLE 100mm WHITE LINE (POLYUREA)
 STA. 4+250 TO STA. 4+460 +/- (EDGE LINE)

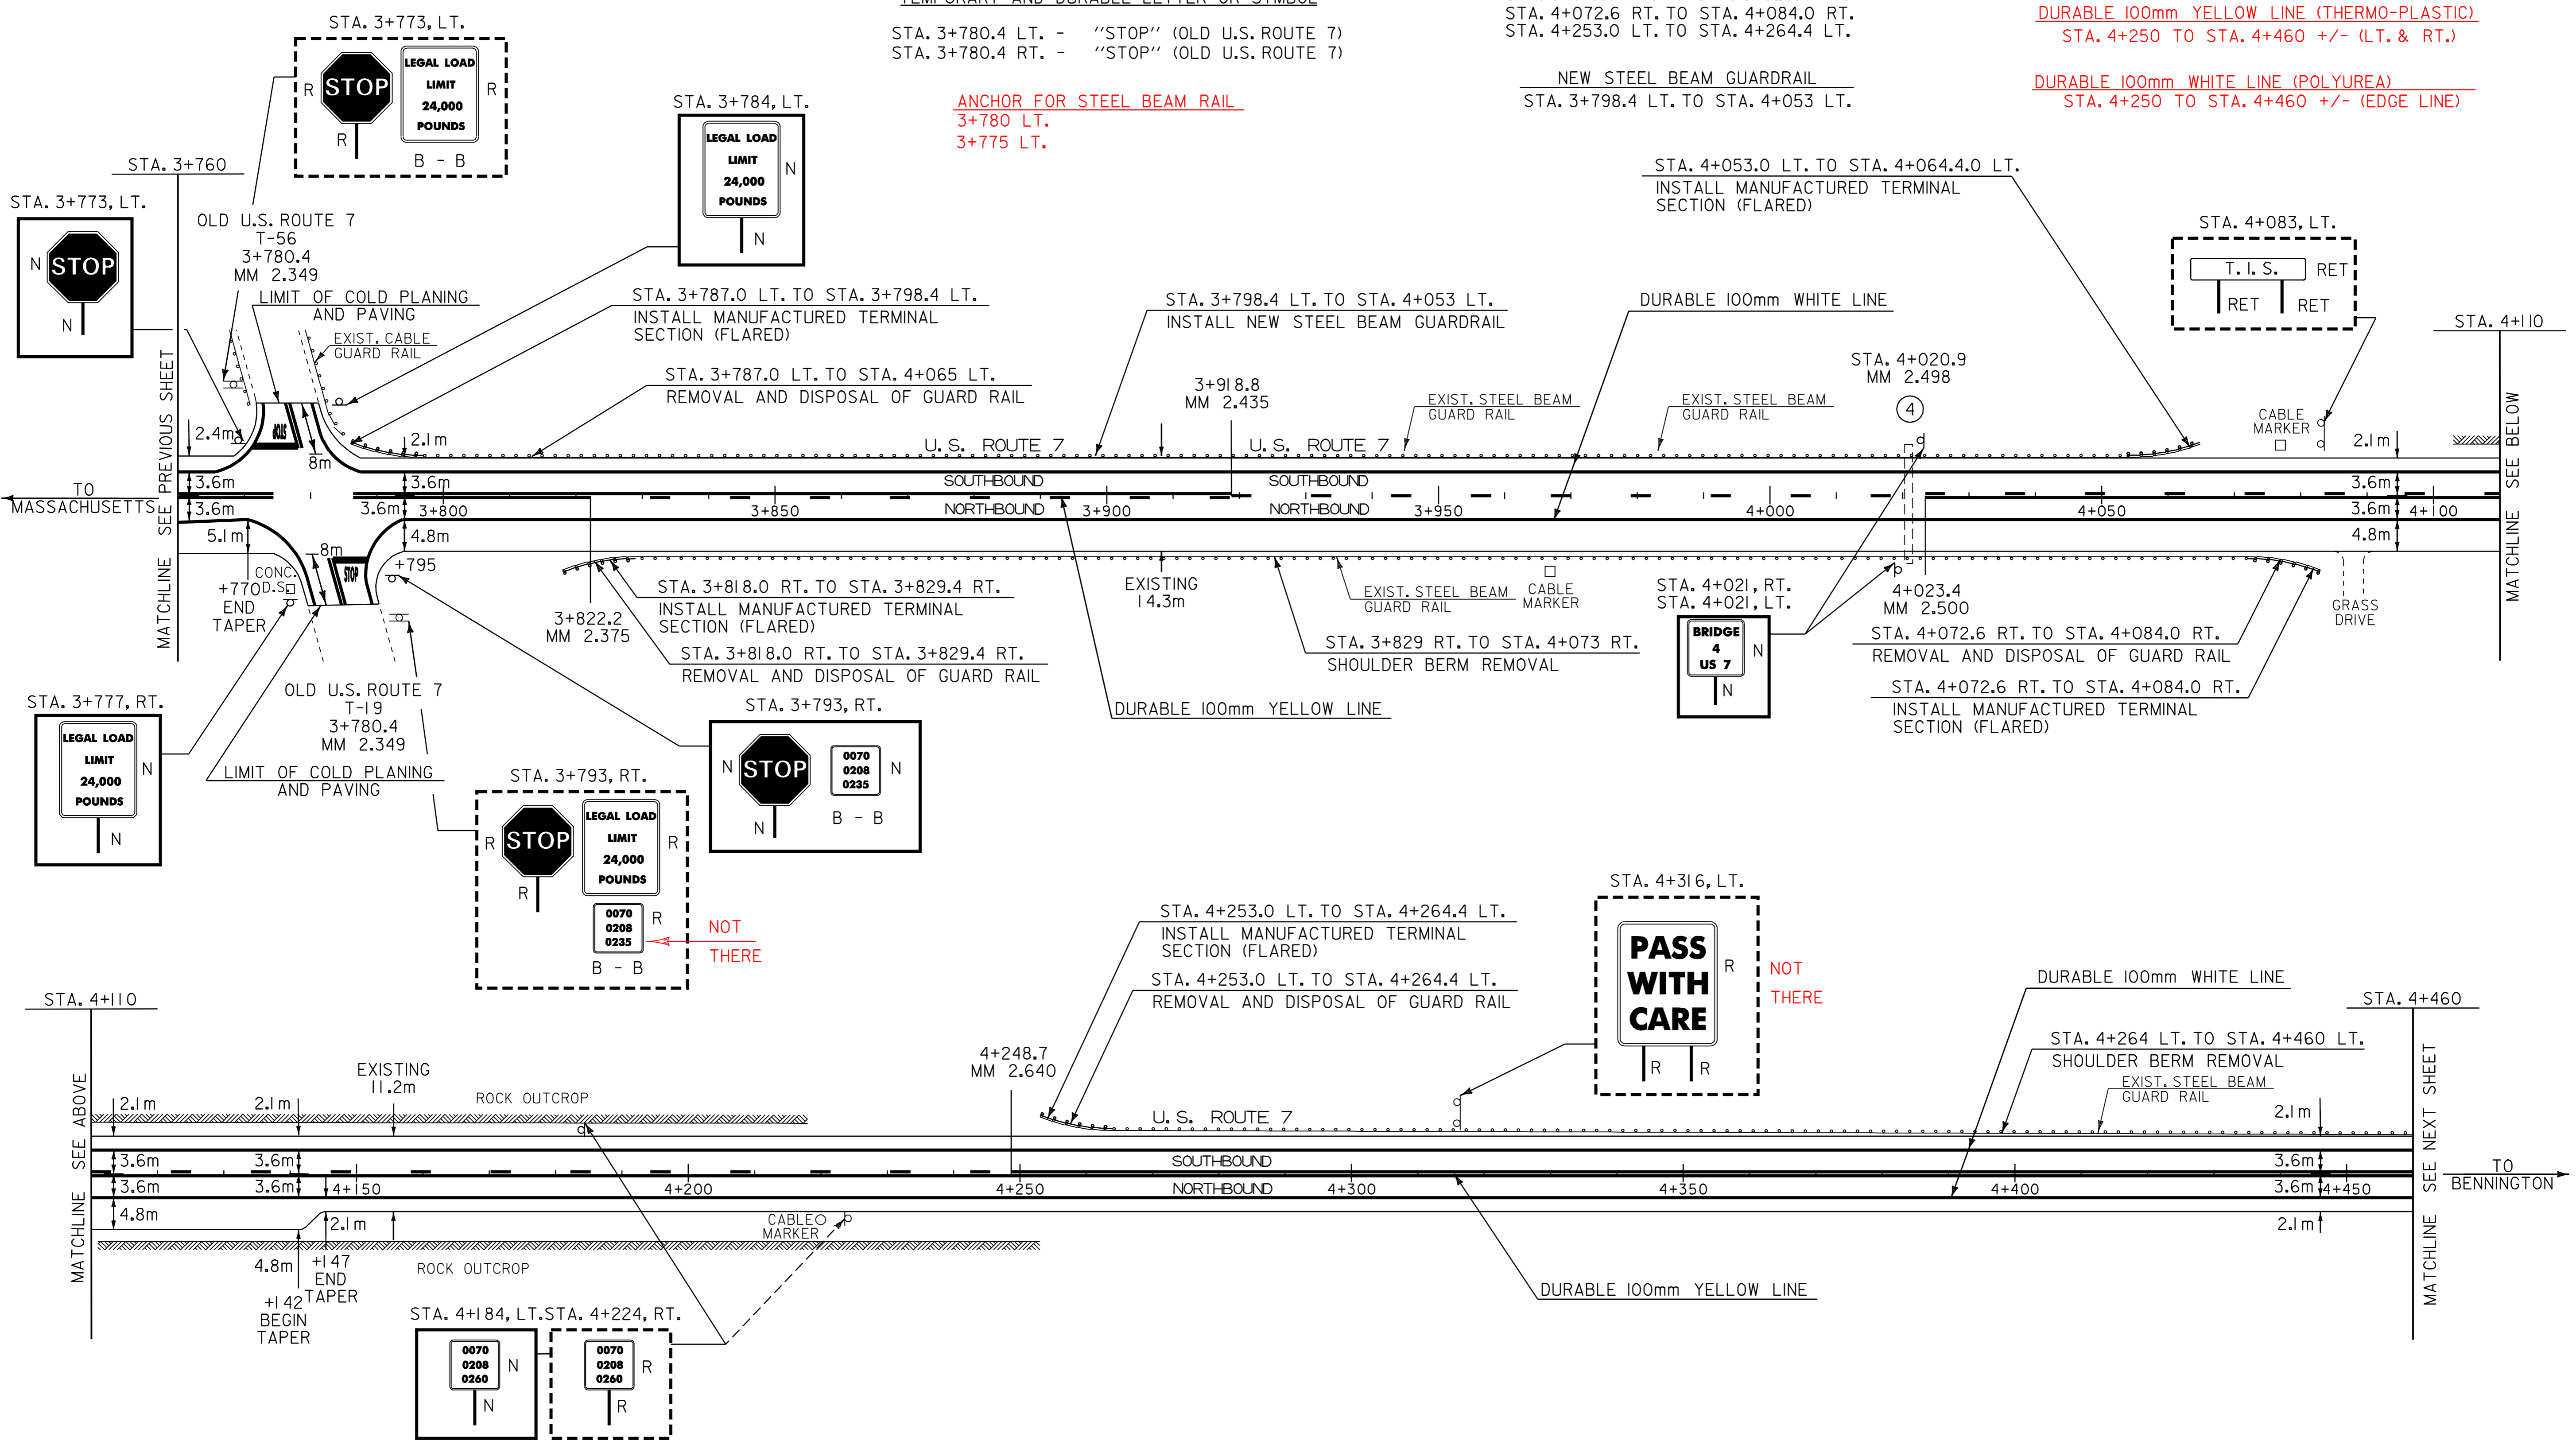

LEGEND

- N = NEW
- R = REMOVE
- R & S = REMOVE AND SALVAGE
- S = SALVAGE SIGN
- RET = RETAIN
- B - B = BACK TO BACK

PAVING PROJECT LAYOUT #11	PROJECT: POWNAL-BENNINGTON	PROJECT NO.: NH 2118(I)S
	DESIGN FILE NAME: /pave/98bl68/pbl68.dgn	PLOT DATE: 17-JAN-2006 14
	IPARM FILE NAME: pbl68III.I	SURVEY DATE:
	SURVEYED BY: ACT, SJL, RAL	SQUAD LEADER: JAV
		DRAWN BY: ACT
		SHEET: 19 OF 65

DATUM
 VERTICAL N/A
 HORIZONTAL N/A