

TEMPORARY AND DURABLE 100mm YELLOW LINE

STA. 4+460.0 TO STA. 4+490.1 SOLID LT. AND RT.
 STA. 4+490.1 TO STA. 4+755.6 SOLID LT. AND DASHED RT.
 STA. 4+755.6 TO STA. 4+795.8 DASHED
 STA. 4+795.8 TO STA. 5+021.2 DASHED LT. AND SOLID RT.
 STA. 5+021.2 TO STA. 5+160.0 SOLID LT. AND RT.

TEMPORARY AND DURABLE 100mm WHITE LINE

STA. 4+460.0 TO STA. 5+160.0 SOLID LT. AND RT. (EDGE LINE)

REHABILITATION OF DI, CB, OR MH, CLASS I

STA. 4+630 RT.
 STA. 5+010 RT.

REMOVAL AND DISPOSAL OF GUARD RAIL

STA. 4+493.4 LT. TO STA. 4+618.8 LT.
~~STA. 4+991.3 LT. TO STA. 5+158.5 LT.~~

STEEL BEAM GUARD RAIL

STA. 4+493.4 LT. TO STA. 4+618.8 LT.
 STA. 4+991.3 LT. TO STA. 5+158.5 LT.

REMOVE AND RESET GUARDRAIL
 STA. 4+991 LT. TO STA. 5+180 LT.

SHOULDER BERM REMOVAL


STA. 4+460 LT. TO STA. 4+493 LT.
 STA. 4+619 LT. TO STA. 4+991 LT.

REMOVING SIGNS

0 + -- AS SHOWN

DURABLE 100mm YELLOW LINE (THERMO-PLASTIC)
 STA. 4+460 TO STA. 5+160 (LT. & RT.)

DURABLE 100mm WHITE LINE (POLYUREA)
 STA. 4+460 TO STA. 5+160 (EDGE LINE)

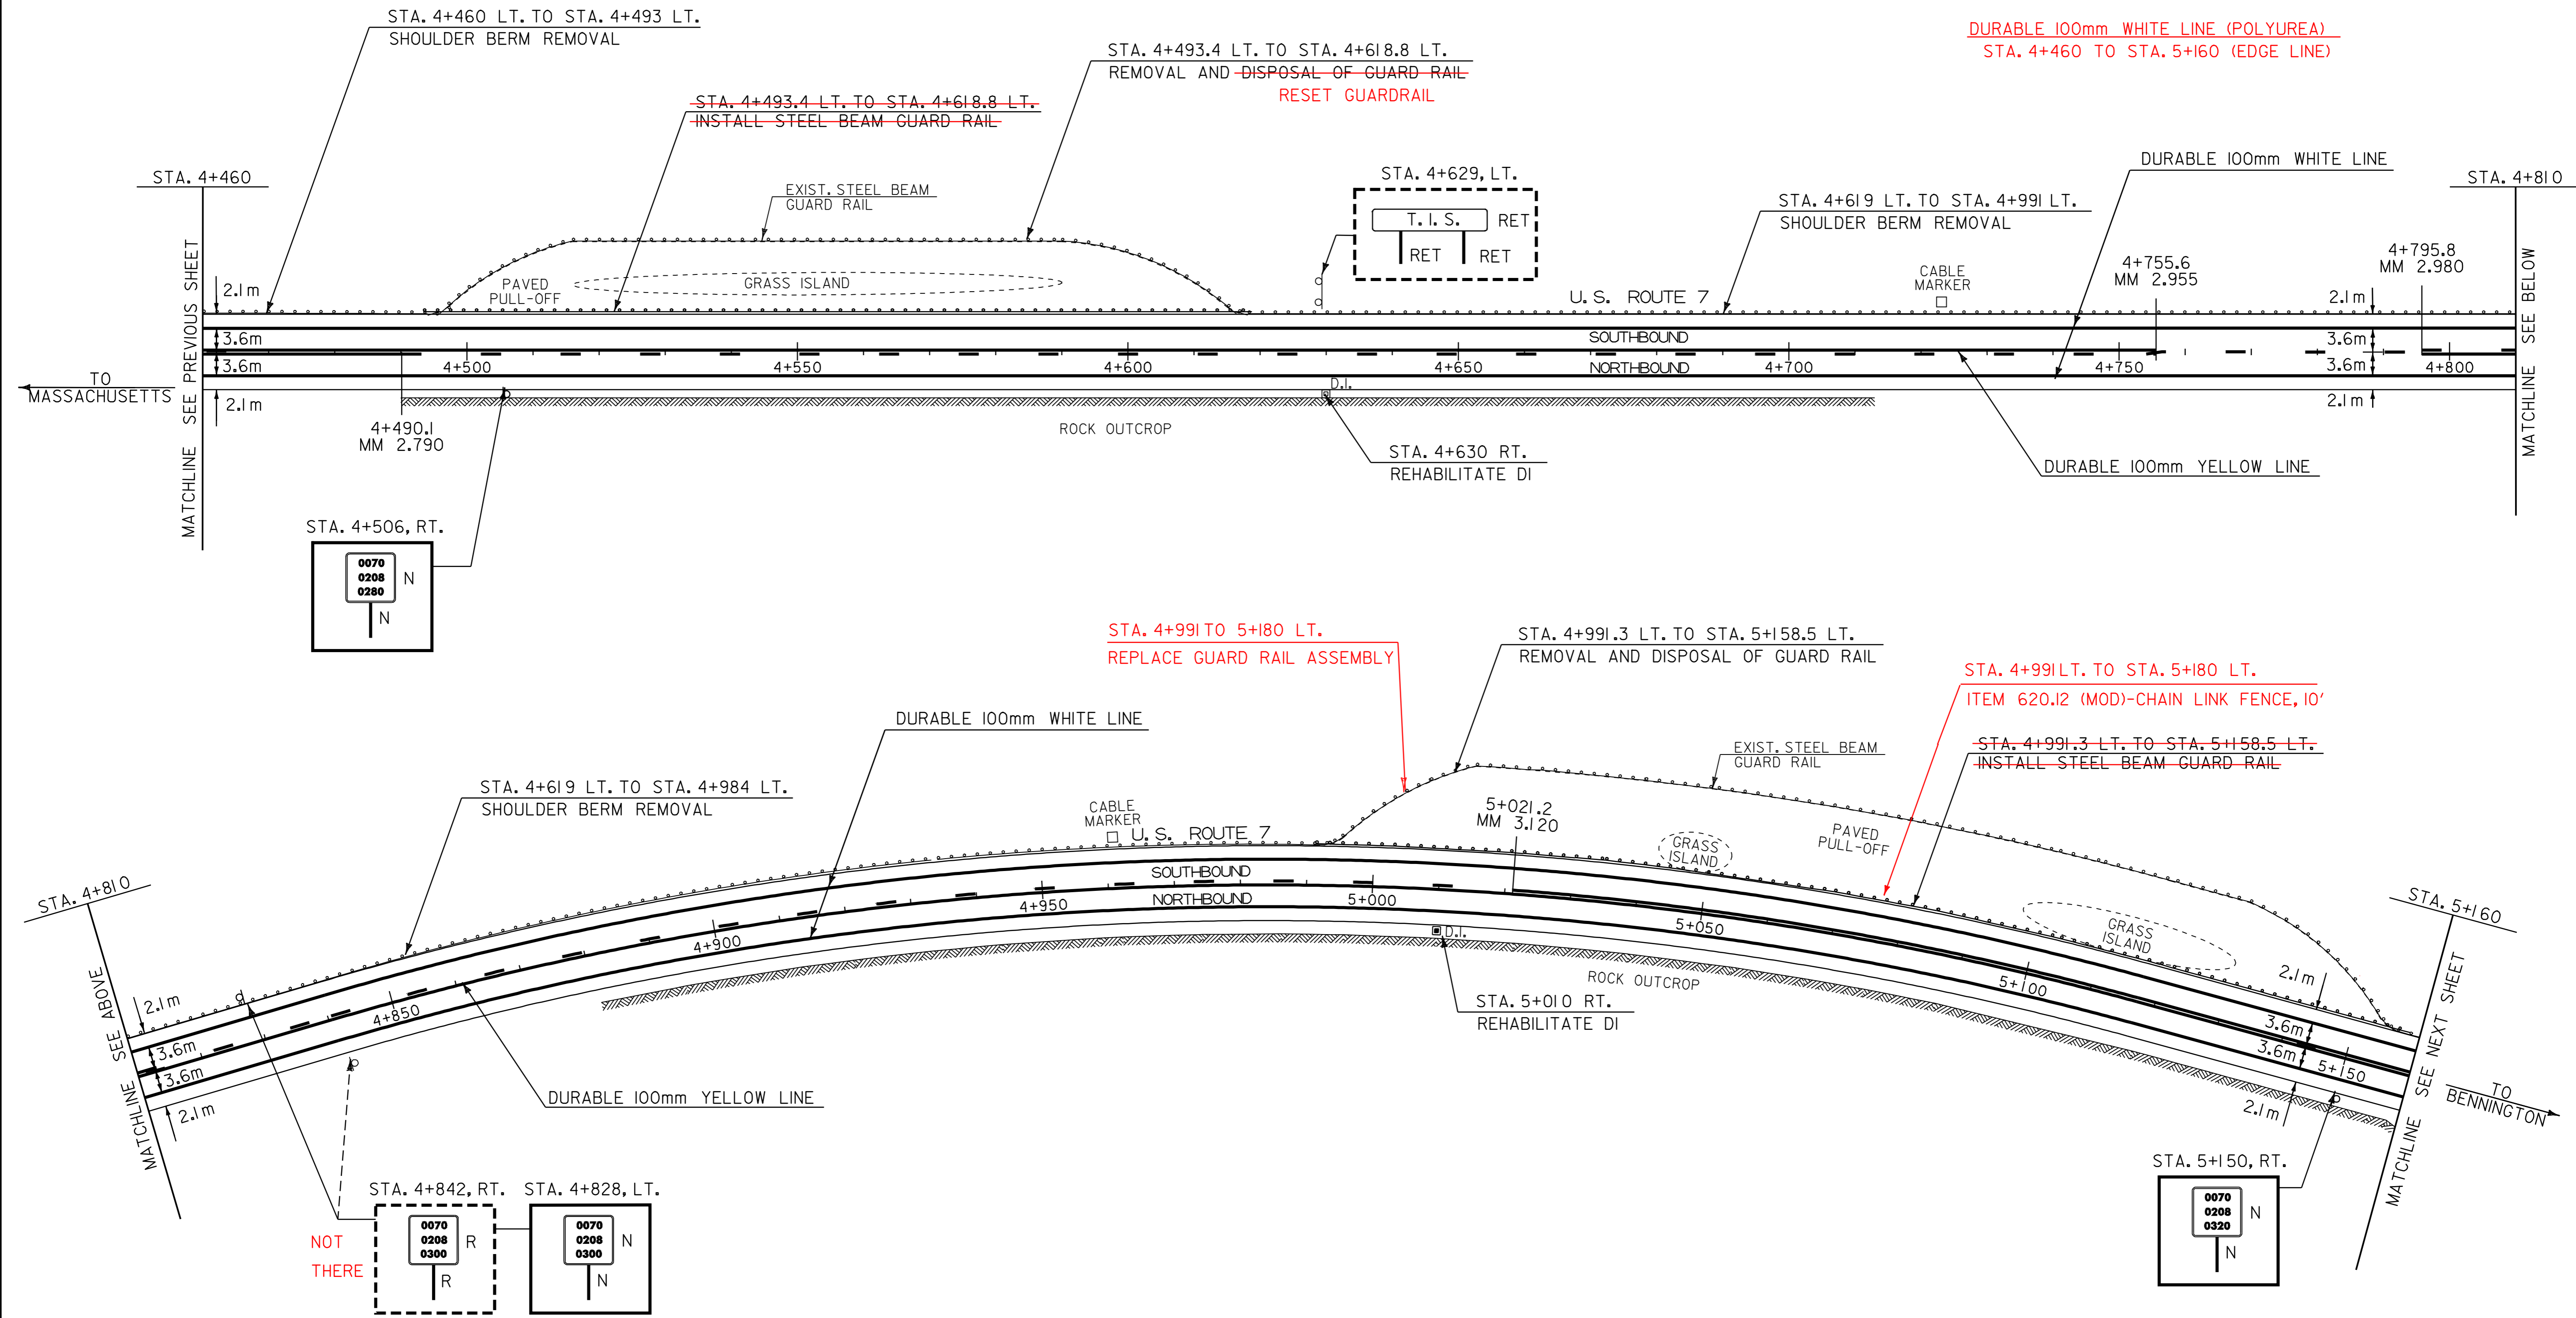

LEGEND
 N = NEW
 R = REMOVE
 R & S = REMOVE AND SALVAGE
 S = SALVAGE SIGN
 RET = RETAIN
 B - B = BACK TO BACK

PAVING PROJECT LAYOUT #12	PROJECT: POWNAL-BENNINGTON	PROJECT NO.: NH 2118(I)S
	DESIGN FILE NAME: /pave/98bl68/pbl68.dgn	PLOT DATE: 17-JAN-2006 14
	IPARM FILE NAME: pbl68I2.1	SURVEY DATE:
	SURVEYED BY: ACT, SJL, RAL	DRAWN BY: ACT
	SQUAD LEADER: JAV	SHEET: 20 OF 65

DATUM
 VERTICAL N/A
 HORIZONTAL N/A