

TEMPORARY AND DURABLE 100mm YELLOW LINE

STA. 5+160.0 TO STA. 5+166.0 SOLID LT. AND RT.
 STA. 5+166.0 TO STA. 5+407.4 SOLID LT. AND DASHED RT.
 STA. 5+407.4 TO STA. 5+439.6 DASHED
 STA. 5+439.6 TO STA. 5+672.9 DASHED LT. AND SOLID RT.
 STA. 5+672.9 TO STA. 5+860.0 SOLID LT. AND RT.

TEMPORARY AND DURABLE 100mm WHITE LINE

STA. 5+160.0 TO STA. 5+860.0 SOLID LT. AND RT. (EDGE LINE)

REMOVAL AND DISPOSAL OF GUARD RAIL

STA. 5+481.6 LT. TO STA. 5+493.0 LT.
 STA. 5+792.9 LT. TO STA. 5+804.3 LT.

STEEL BEAM GUARD RAIL

STA. 5+481.6 LT. TO STA. 5+804.6 LT.

~~REMOVAL AND DISPOSAL OF DELINEATORS~~

~~STA. 5+664 LT. TO STA. 5+785 LT.~~

DURABLE 100mm YELLOW LINE (THERMOPLASTIC)
 STA. 5+160 TO STA. 5+860 (LT. & RT.)


DURABLE 100mm WHITE LINE (POLYUREA)
 STA. 5+160 TO STA. 5+860 (EDGE LINE)

SHOULDER BERM REMOVAL

STA. 5+159 LT. TO STA. 5+482 LT.
 STA. 5+805 LT. TO STA. 5+860 LT.

REMOVING SIGNS

~~2-3~~ -- AS SHOWN

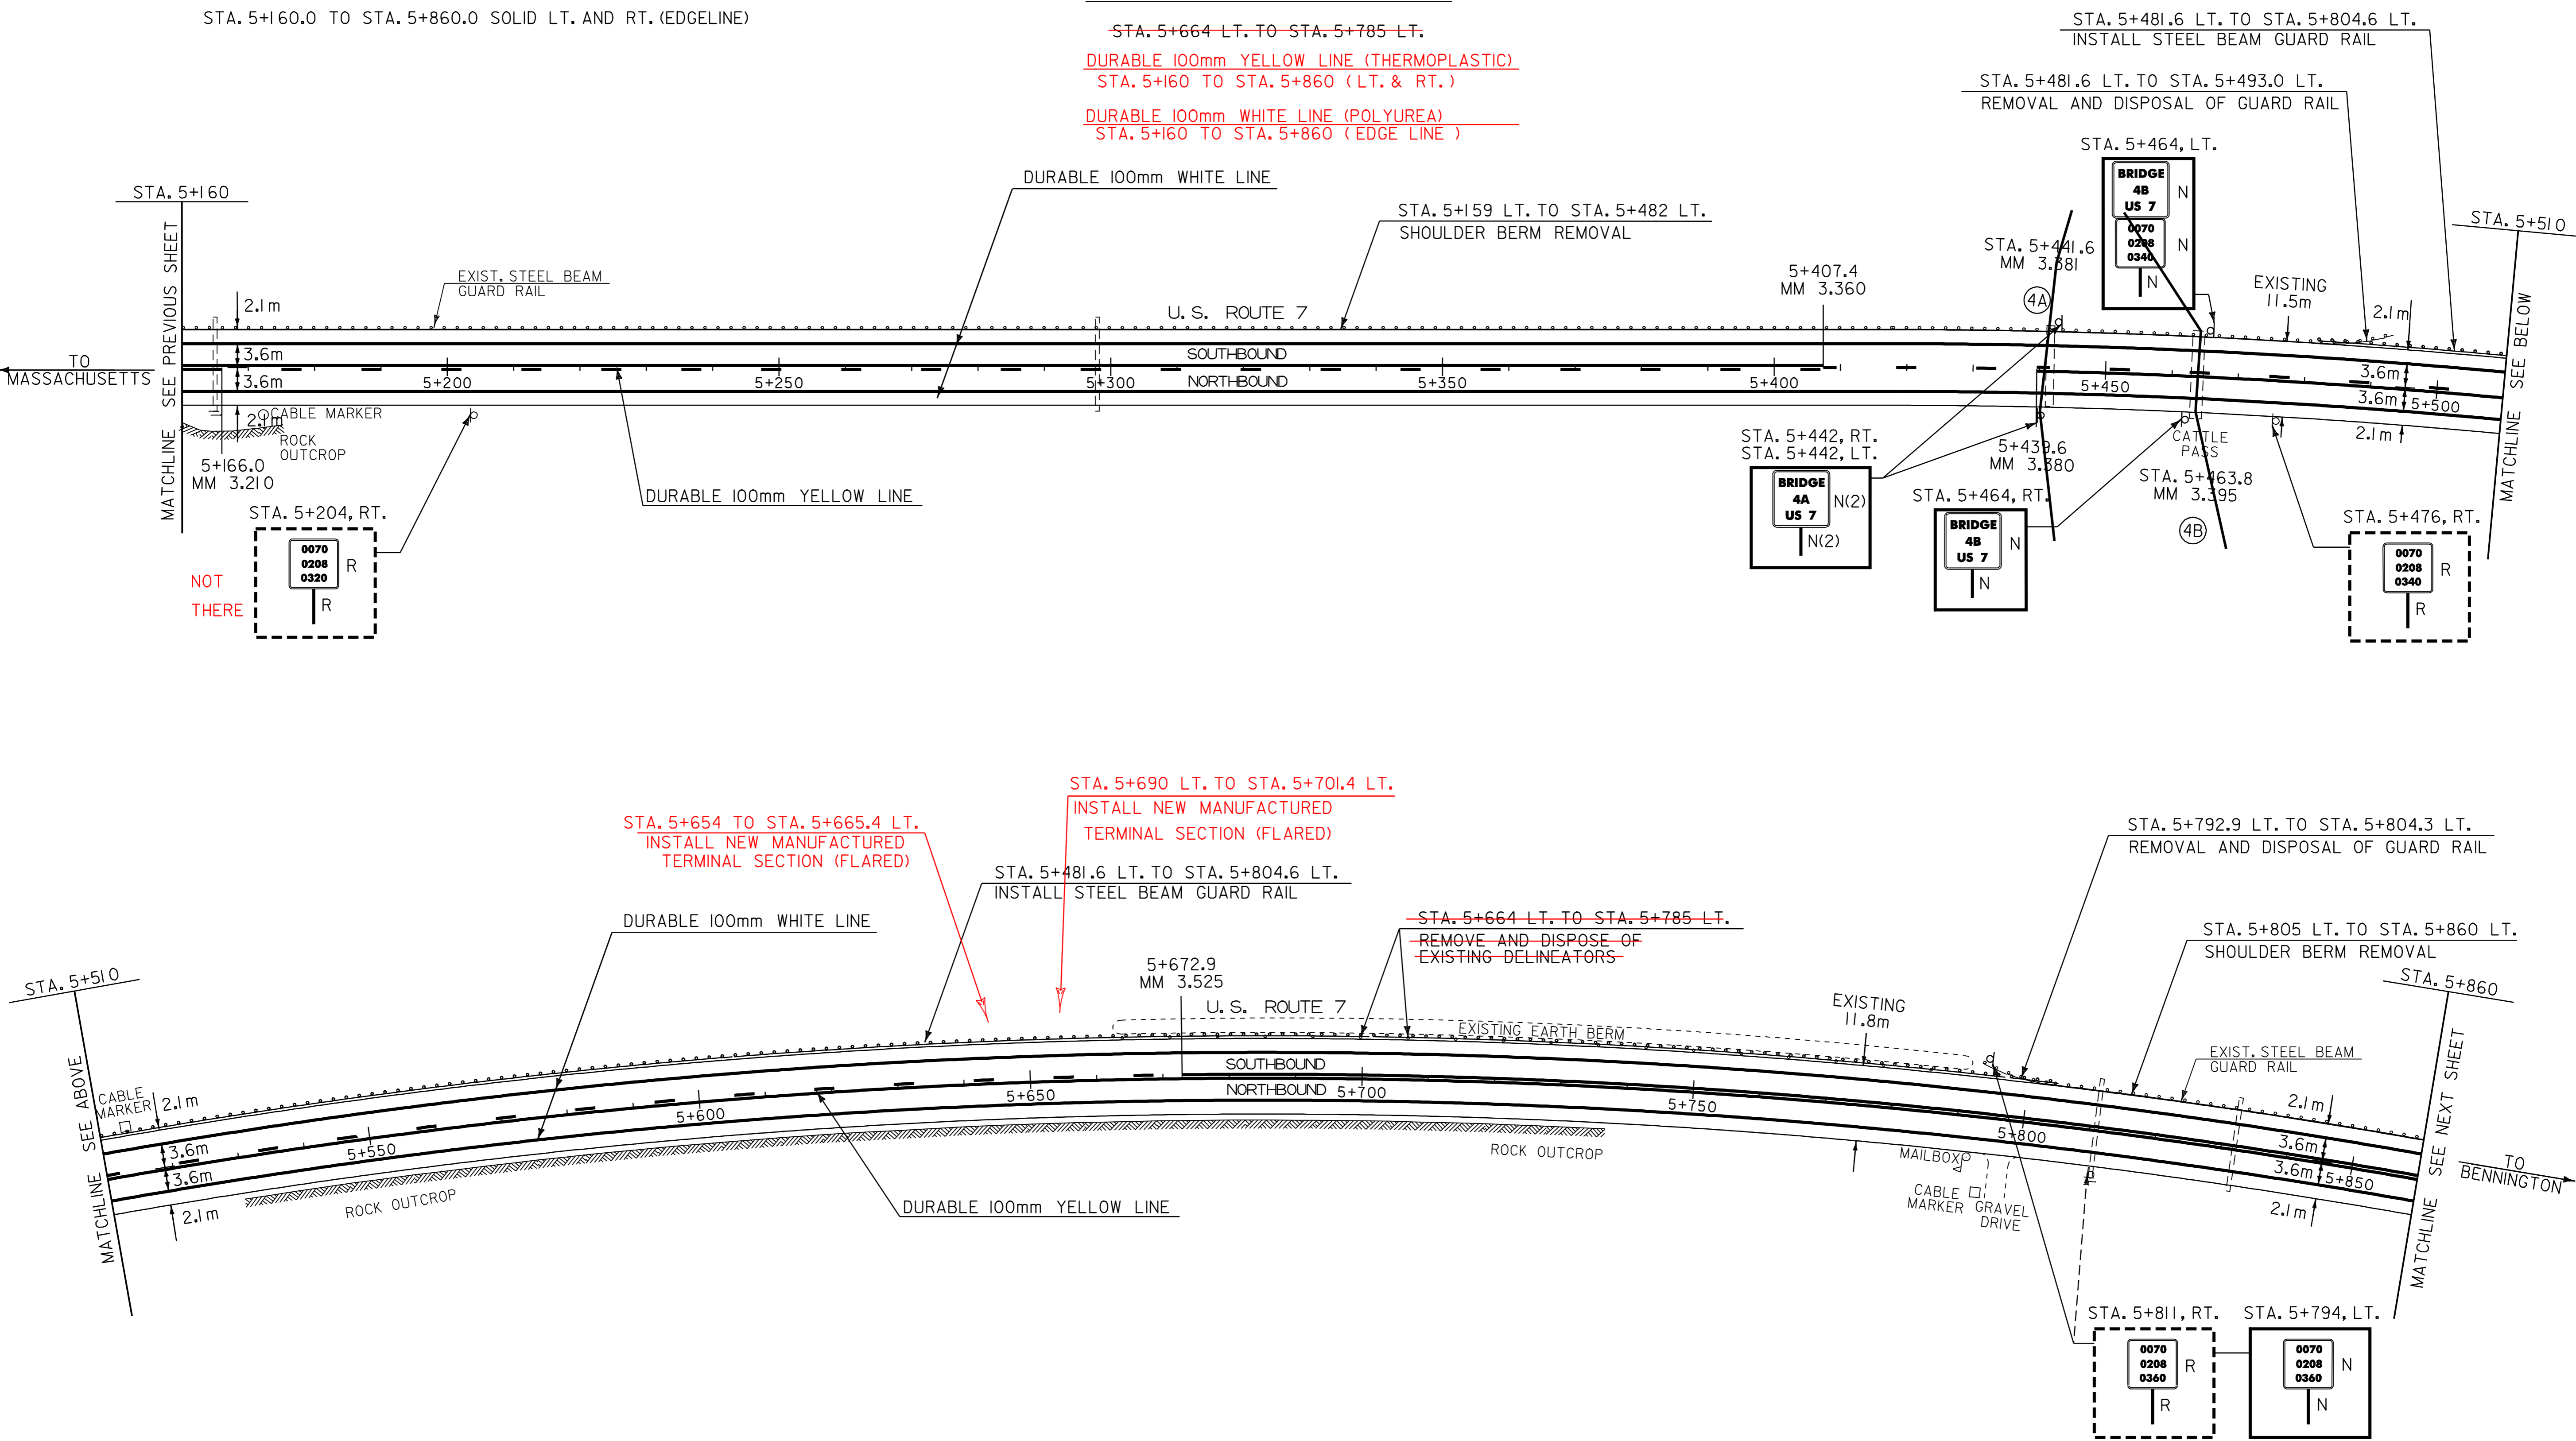

LEGEND
 N = NEW
 R = REMOVE
 R & S = REMOVE AND SALVAGE
 S = SALVAGE SIGN
 RET = RETAIN
 B - B = BACK TO BACK

PAVING PROJECT LAYOUT #13	PROJECT:	POWNAI-BENNINGTON	PROJECT NO.:	NH 2118(I)S
	DESIGN FILE NAME:	/pave/98bl68/pbl68.dgn	PLOT DATE:	17-JAN-2006 14
	IPARM FILE NAME:	pbl68I3.1	SURVEY DATE:	
	SURVEYED BY:	ACT, SJL, RAL	DRAWN BY:	ACT
	SQUAD LEADER:	JAV	SHEET:	21 OF 65

DATUM
 VERTICAL N/A
 HORIZONTAL N/A