

TEMPORARY AND DURABLE 100mm YELLOW LINE

STA. 6+560.0 TO STA. 7+260.0 SOLID LT. AND RT.  
(WITH CENTERLINE BREAKS FOR SIDE ROADS)  
STA. 7+099 RT. (OLD U.S. ROUTE 7)  
STA. 7+237 RT. (MANN HILL ROAD)

TEMPORARY AND DURABLE 100mm WHITE LINE

STA. 6+560.0 TO STA. 7+260.0 SOLID LT. AND RT. (EDGE LINE)  
(WITH EDGE LINE BREAKS FOR SIDE ROADS)  
STA. 6+560.0 TO STA. 7+260.0 DASHED RT. (PASSING LANE)

MANUFACTURED TERMINAL SECTION (FLARED)

STA. 6+603.6 RT. TO STA. 6+615.0 RT.  
STA. 6+609.6 LT. TO STA. 6+621.0 LT.  
STA. 6+723.0 LT. TO STA. 6+734.4 LT.  
STA. 6+744.0 RT. TO STA. 6+755.4 RT.  
STA. 7+048.6 RT. TO STA. 7+060.0 RT.  
STA. 7+060.6 LT. TO STA. 7+072.0 LT.

REMOVAL AND DISPOSAL OF GUARD RAIL

STA. 6+603.6 RT. TO STA. 6+615.0 RT.  
STA. 6+609.6 LT. TO STA. 6+621.0 LT.  
STA. 6+723.0 LT. TO STA. 6+734.4 LT.  
STA. 6+744.0 RT. TO STA. 6+755.4 RT.  
STA. 7+048.6 RT. TO STA. 7+060.0 RT.  
STA. 7+060.6 LT. TO STA. 7+072.0 LT.

REMOVING SIGNS

7-8 -- AS SHOWN

ERECTING SALVAGED SIGNS

2 -- AS SHOWN

REMOVE AND RESET GUARDRAIL

STA. 6+734.4 LT. TO STA. 7+060.6 LT.

TEMPORARY AND DURABLE 600mm STOP BAR

STA. 7+099 RT. (OLD U.S. ROUTE 7)  
STA. 7+237 RT. (MANN HILL ROAD)

TEMPORARY AND DURABLE LETTER OR SYMBOL

STA. 7+099 RT. - "STOP" (OLD U.S. ROUTE 7)  
STA. 7+237 RT. - "STOP" (MANN HILL ROAD)

REMOVAL OF EXISTING CURB



STA. 6+560 RT. TO STA. 6+604 RT.  
STA. 6+754 RT. TO STA. 6+812 RT.

BITUMINOUS CONCRETE CURB, TYPE B

STA. 6+560 RT. TO STA. 6+604 RT.  
STA. 6+754 RT. TO STA. 6+812 RT.

SHOULDER BERM REMOVAL

STA. 6+560 LT. TO STA. 6+610 LT.  
STA. 6+560 RT. TO STA. 6+604 RT.  
STA. 6+734 LT. TO STA. 7+061 LT.  
STA. 6+755 RT. TO STA. 7+049 RT.

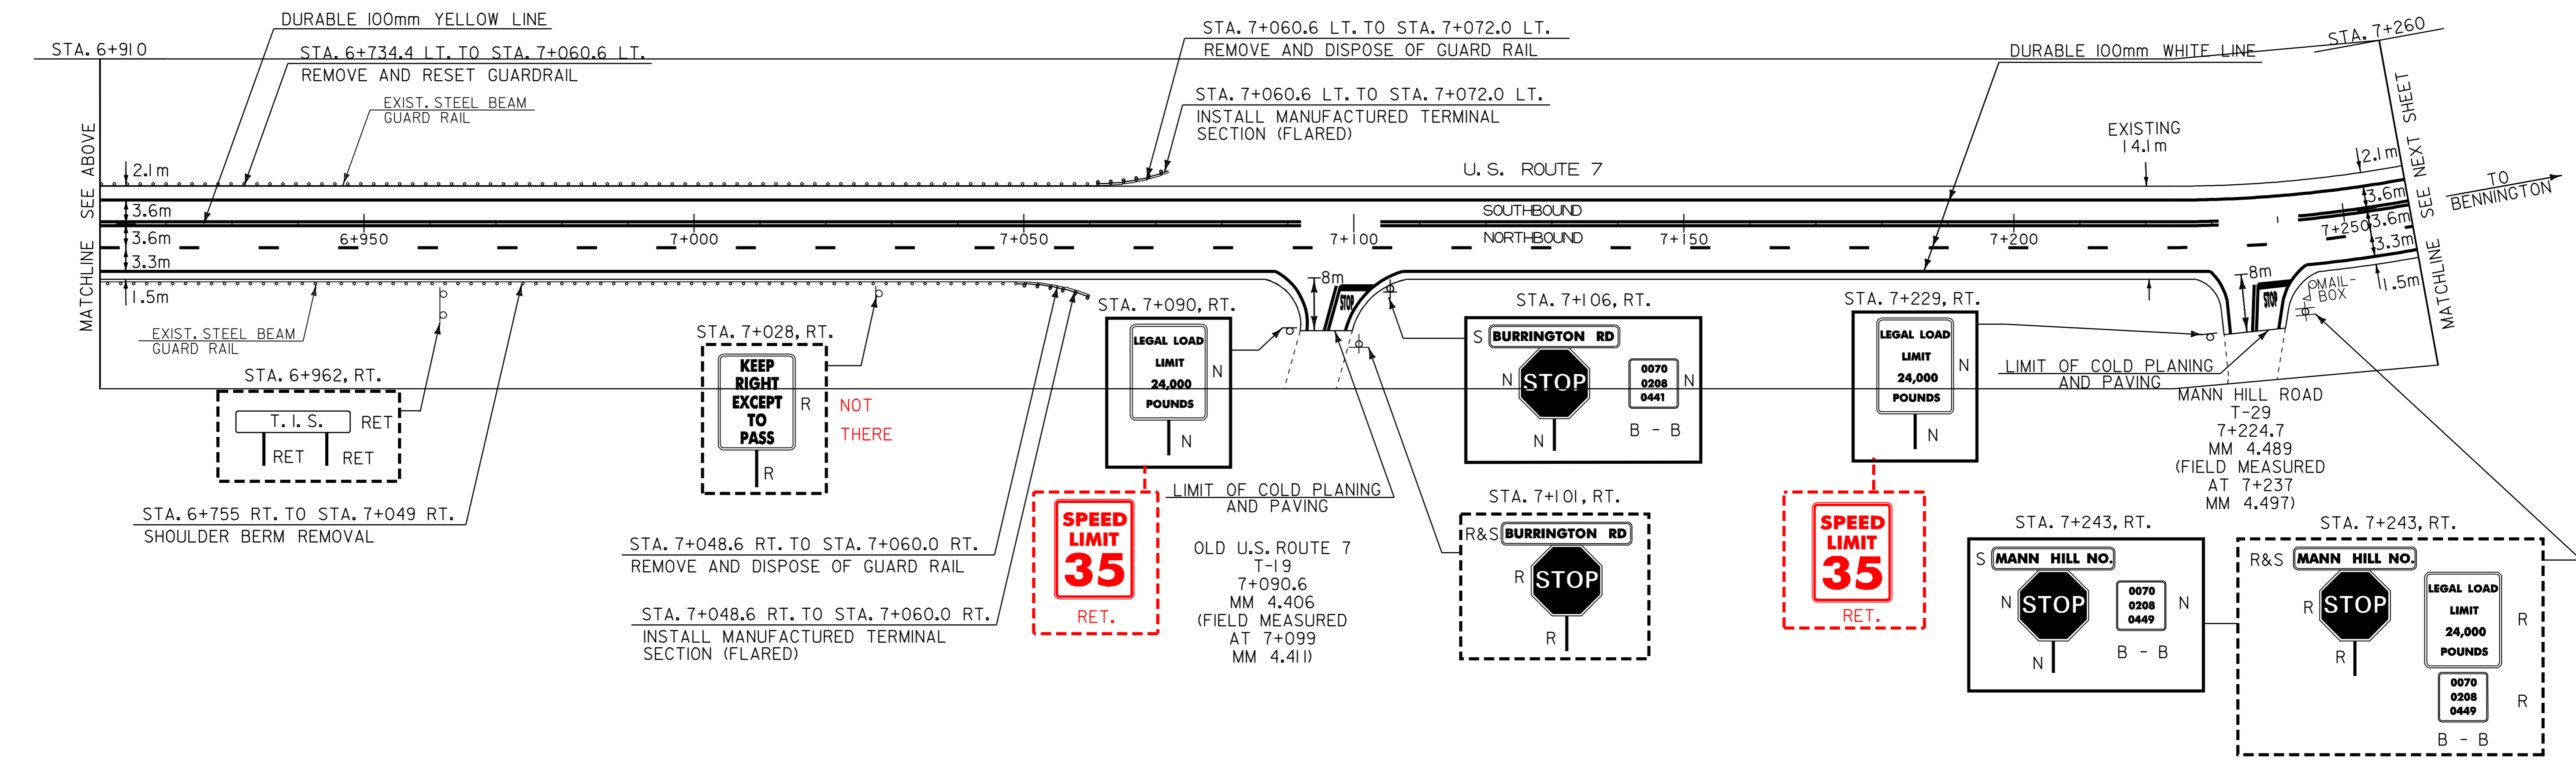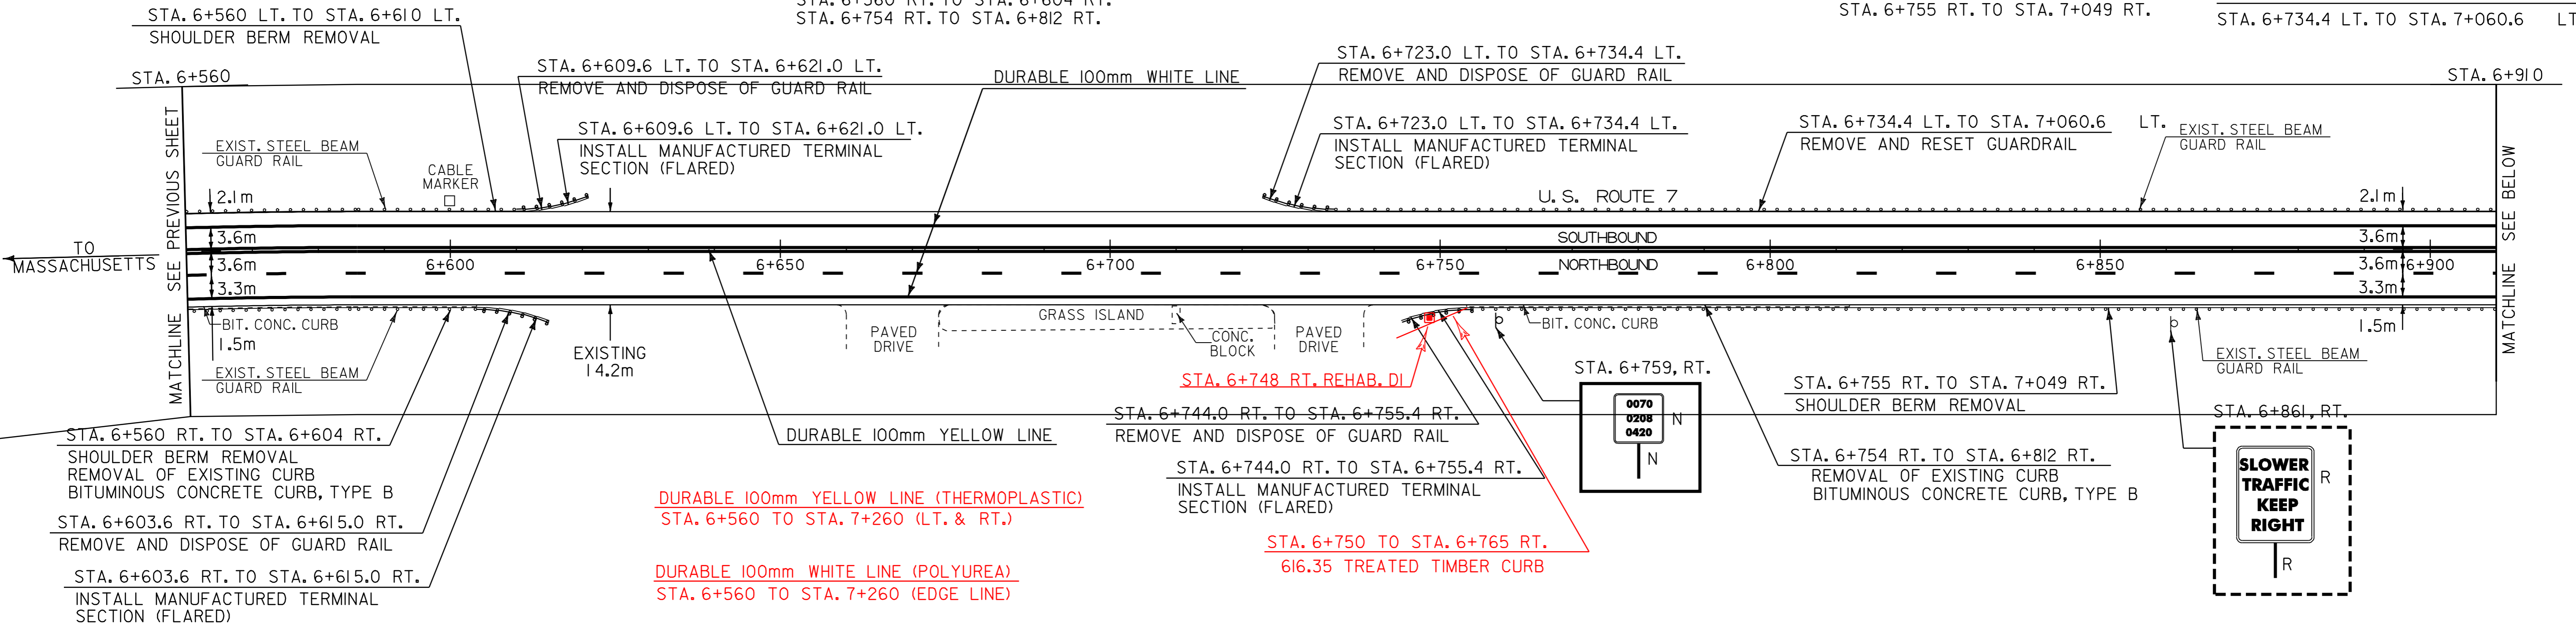

**LEGEND**  
 N = NEW  
 R = REMOVE  
 R & S = REMOVE AND SALVAGE  
 S = SALVAGE SIGN  
 RET = RETAIN  
 B - B = BACK TO BACK

**PAVING PROJECT LAYOUT #15**

PROJECT:	POWNAI-BENNINGTON	PROJECT NO.:	NH 2118(I)S
DESIGN FILE NAME:	/pave/98bl68/pbl68.dgn	PLOT DATE:	17-JAN-2006 14
IPARM FILE NAME:	pbl68i15.1	SURVEY DATE:	
SURVEYED BY:	ACT, SJL, RAL	DRAWN BY:	ACT
SQUAD LEADER:	JAV	SHEET:	23 OF 65

DATUM	
VERTICAL	N/A
HORIZONTAL	N/A