

TEMPORARY AND DURABLE 100mm YELLOW LINE

STA. 7+610.0 TO STA. 7+930.0 SOLID LT. AND RT.
(WITH CENTERLINE BREAKS FOR SIDE ROADS)
STA. 7+649 RT. (BARBER'S POND ROAD)
STA. 7+791 LT. (NORTH POWNAL ROAD)

TEMPORARY AND DURABLE 100mm WHITE LINE

STA. 7+610.0 TO STA. 7+930.0 SOLID LT. AND RT. (EDGE LINE)
(WITH EDGE LINE BREAKS FOR SIDE ROADS)
STA. 7+610.0 TO STA. 7+680.0 DASHED RT. (PASSING LANE)

TEMPORARY AND DURABLE LETTER OR SYMBOL

STA. 7+649 RT. - "STOP" (BARBER'S POND ROAD)
STA. 7+791 LT. - "STOP" (NORTH POWNAL ROAD)

TEMPORARY AND DURABLE 600mm STOP BAR


STA. 7+649 RT. (BARBER'S POND ROAD)
STA. 7+791 LT. (NORTH POWNAL ROAD)

DURABLE 100mm YELLOW LINE (THERMOPLASTIC)

STA. 7+610 TO STA. 7+930 +/- (LT. & RT.)

DURABLE 100mm WHITE LINE (POLYUREA)

STA. 7+610 TO STA. 7+930 +/- (EDGE LINE)

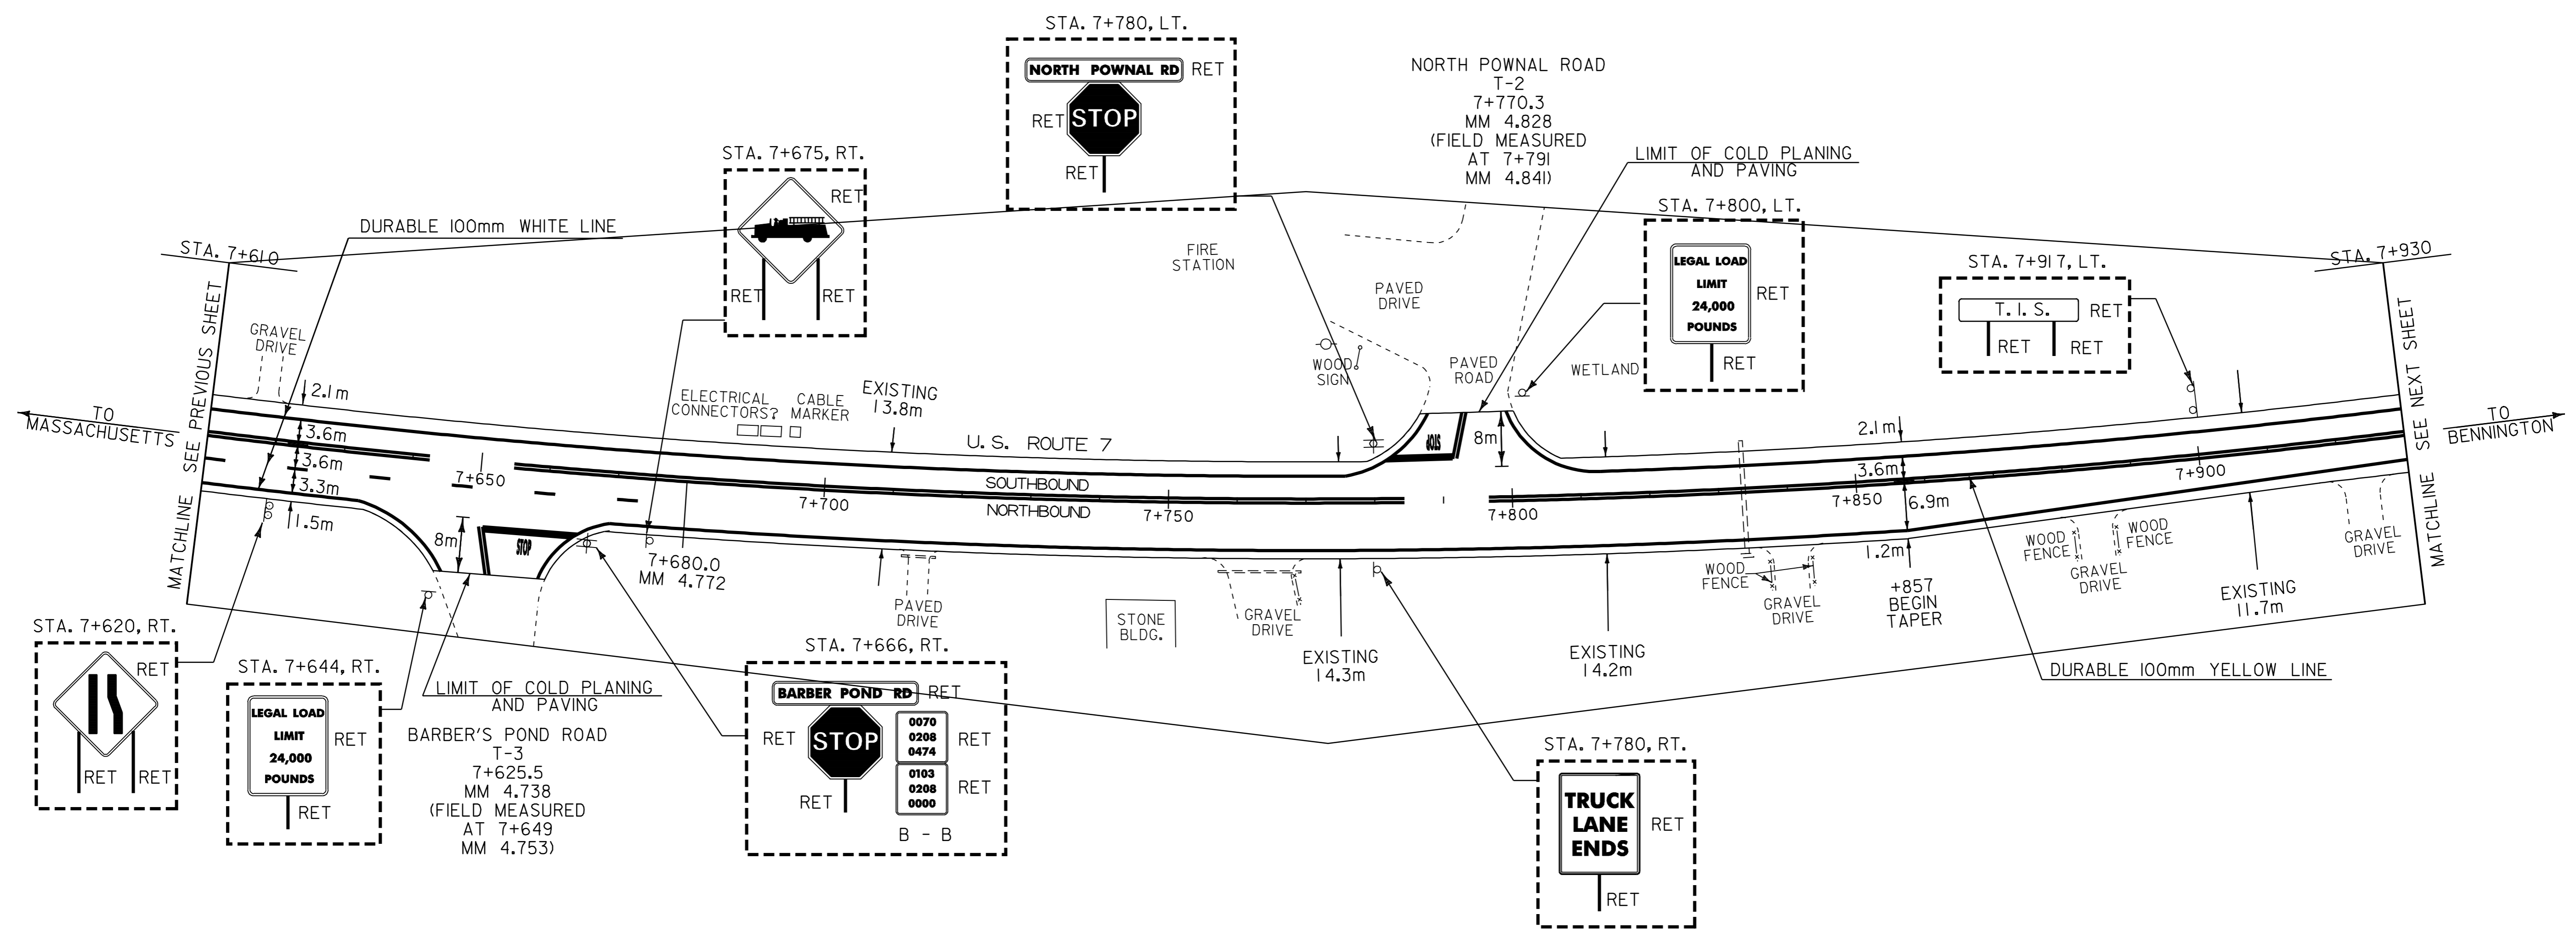

- LEGEND
- N = NEW
 - R = REMOVE
 - R & S = REMOVE AND SALVAGE
 - S = SALVAGE SIGN
 - RET = RETAIN
 - B - B = BACK TO BACK

PAVING PROJECT LAYOUT #17	PROJECT: POWNAL-BENNINGTON	PROJECT NO.: NH 2118(I)S
	DESIGN FILE NAME: /pave/98bl68/pbl68.dgn	PLOT DATE: 17-JAN-2006 14
	IPARM FILE NAME: pbl68i17.1	SURVEY DATE:
	SURVEYED BY: ACT, SJL, RAL	DRAWN BY: ACT
	SQUAD LEADER: JAV	SHEET: 25 OF 65

DATUM	
VERTICAL	N/A
HORIZONTAL	N/A