


DURABLE 100mm YELLOW LINE (THERMOPLASTIC)
 STA. 7+930 TO STA. 8+270+/- (LT. & RT.)

DURABLE 100mm WHITE LINE (POLYUREA)
 STA. 7+930 TO STA. 8+270+/- (EDGE LINE)

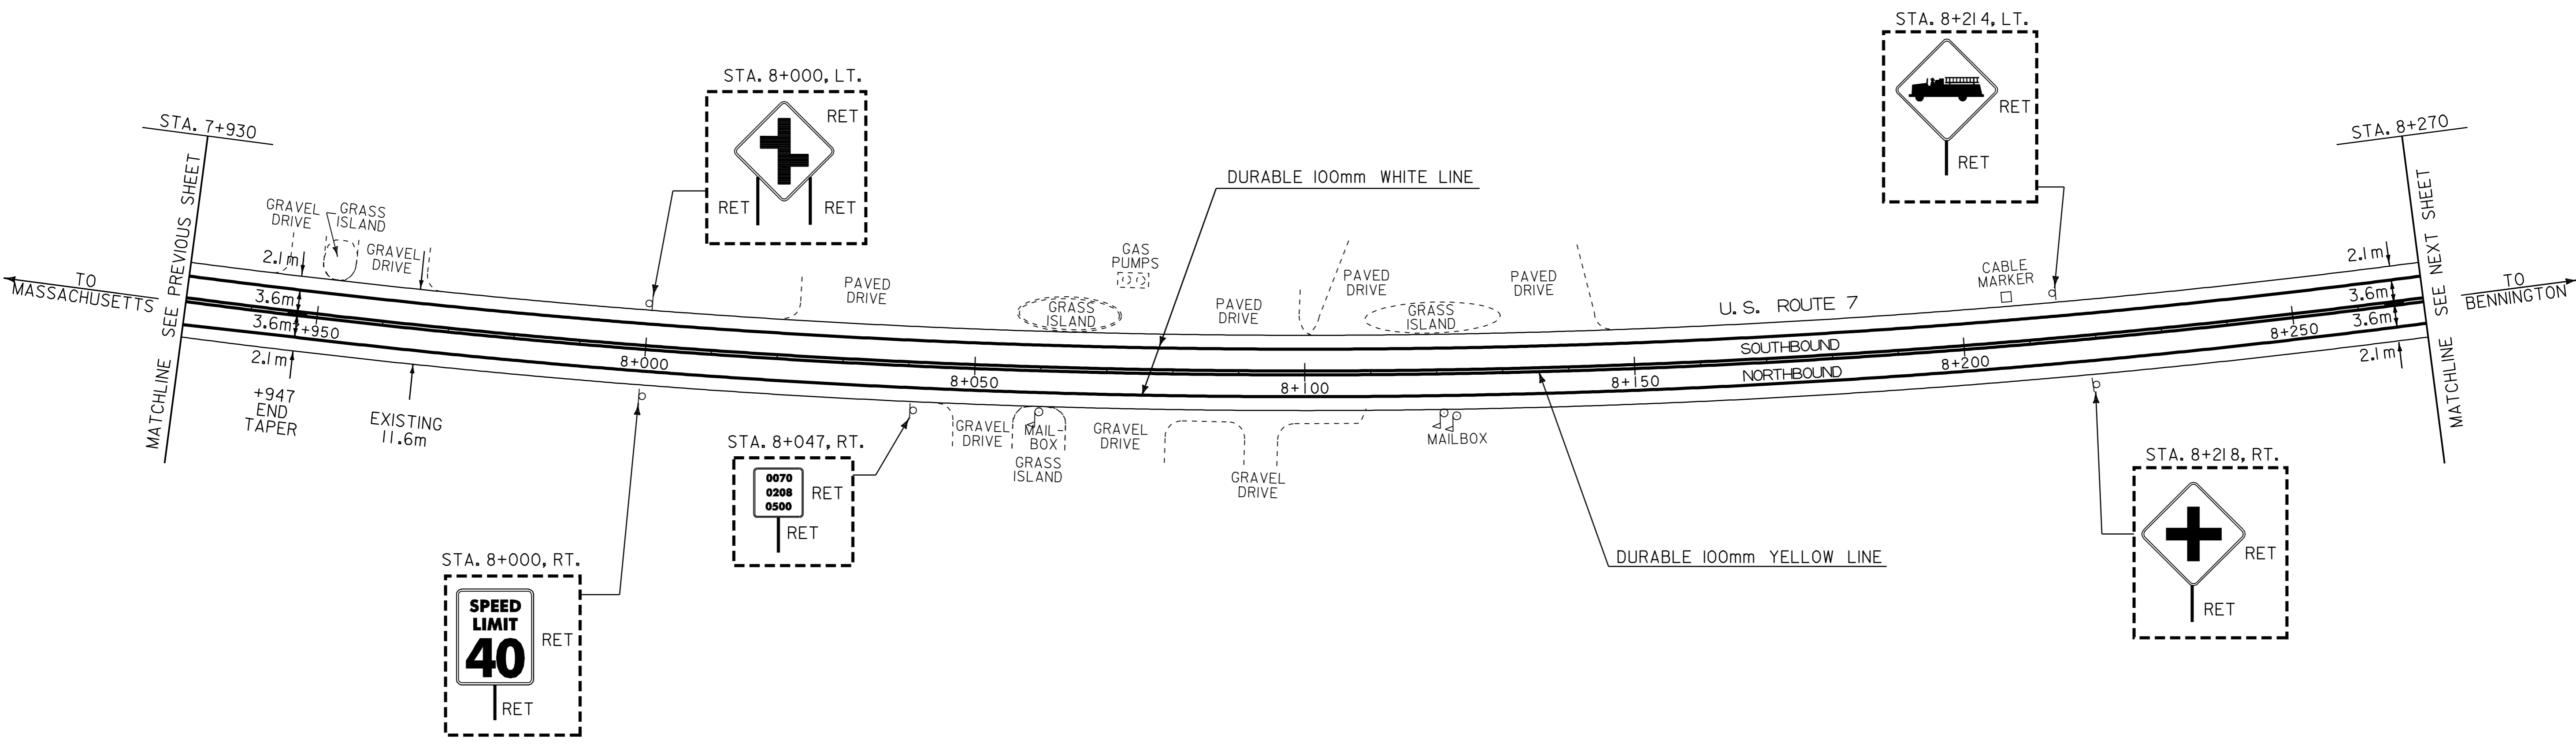

- LEGEND
- N = NEW
 - R = REMOVE
 - R & S = REMOVE AND SALVAGE
 - S = SALVAGE SIGN
 - RET = RETAIN
 - B - B = BACK TO BACK

**PAVING
 PROJECT
 LAYOUT
 #18**

| | |
|--|-----------------------------|
| PROJECT: POWNAI-BENNINGTON | PROJECT NO.: NH 2118(I)S |
| DESIGN FILE NAME: /pave/98bl68/pbl68.dgn | PLOT DATE: 17-JAN-2006 14 |
| IPARM FILE NAME: pbl68i18.1 | SURVEY DATE: |
| SURVEYED BY: ACT, SJL, RAL | DRAWN BY: ACT |
| SQUAD LEADER: JAV | SHEET: 26 OF 65 |

| | |
|------------|-----|
| DATUM | |
| VERTICAL | N/A |
| HORIZONTAL | N/A |