

TEMPORARY AND DURABLE 100mm YELLOW LINE

STA. 9+270.0 TO STA. 9+334.2 SOLID LT. AND DASHED RT.
 STA. 9+334.2 TO STA. 9+366.4 DASHED
 STA. 9+366.4 TO STA. 9+607.8 DASHED LT. AND SOLID RT.
 STA. 9+607.8 TO STA. 9+855.0 SOLID LT. AND RT.

TEMPORARY AND DURABLE 100mm WHITE LINE

STA. 9+270.0 TO STA. 9+855.0 SOLID LT. AND RT. (EDGE LINE)

SHOULDER BERM REMOVAL

~~STA. 9+745 RT. TO STA. 9+855 RT.~~



REMOVAL AND DISPOSAL OF GUARD RAIL

STA. 9+734.0 RT. TO STA. 9+855.0 RT.

REMOVING SIGNS

1-2 -- AS SHOWN

MANUFACTURED TERMINAL SECTION (FLARED)



STA. 9+734.0 RT. TO STA. 9+745.4 RT.

DURABLE 100mm YELLOW LINE (THERMO-PLASTIC)
 STA. 9+270 TO STA. 9+855 (LT. & RT.)

STEEL BEAM GUARDRAIL

STA. 9+745.4 RT. TO STA. 9+855 RT.

DURABLE 100mm YELLOW LINE (POLYUREA)
 STA. 9+270 TO STA. 9+855 (EDGE LINE)

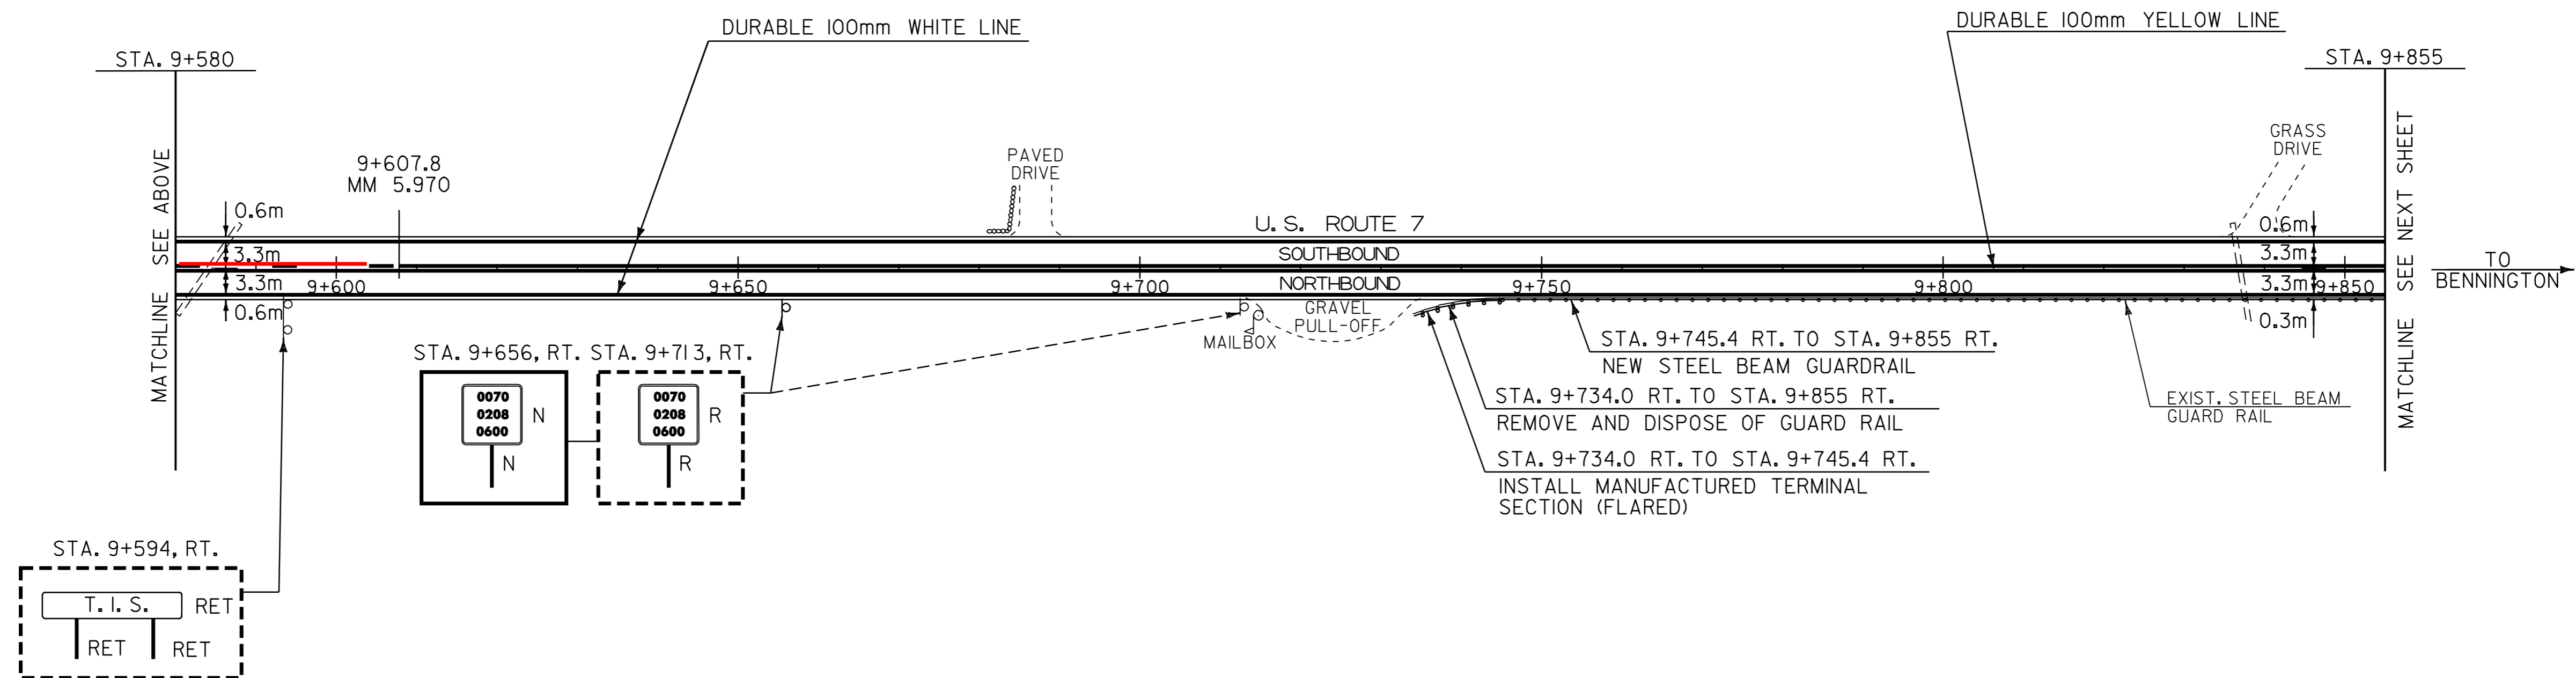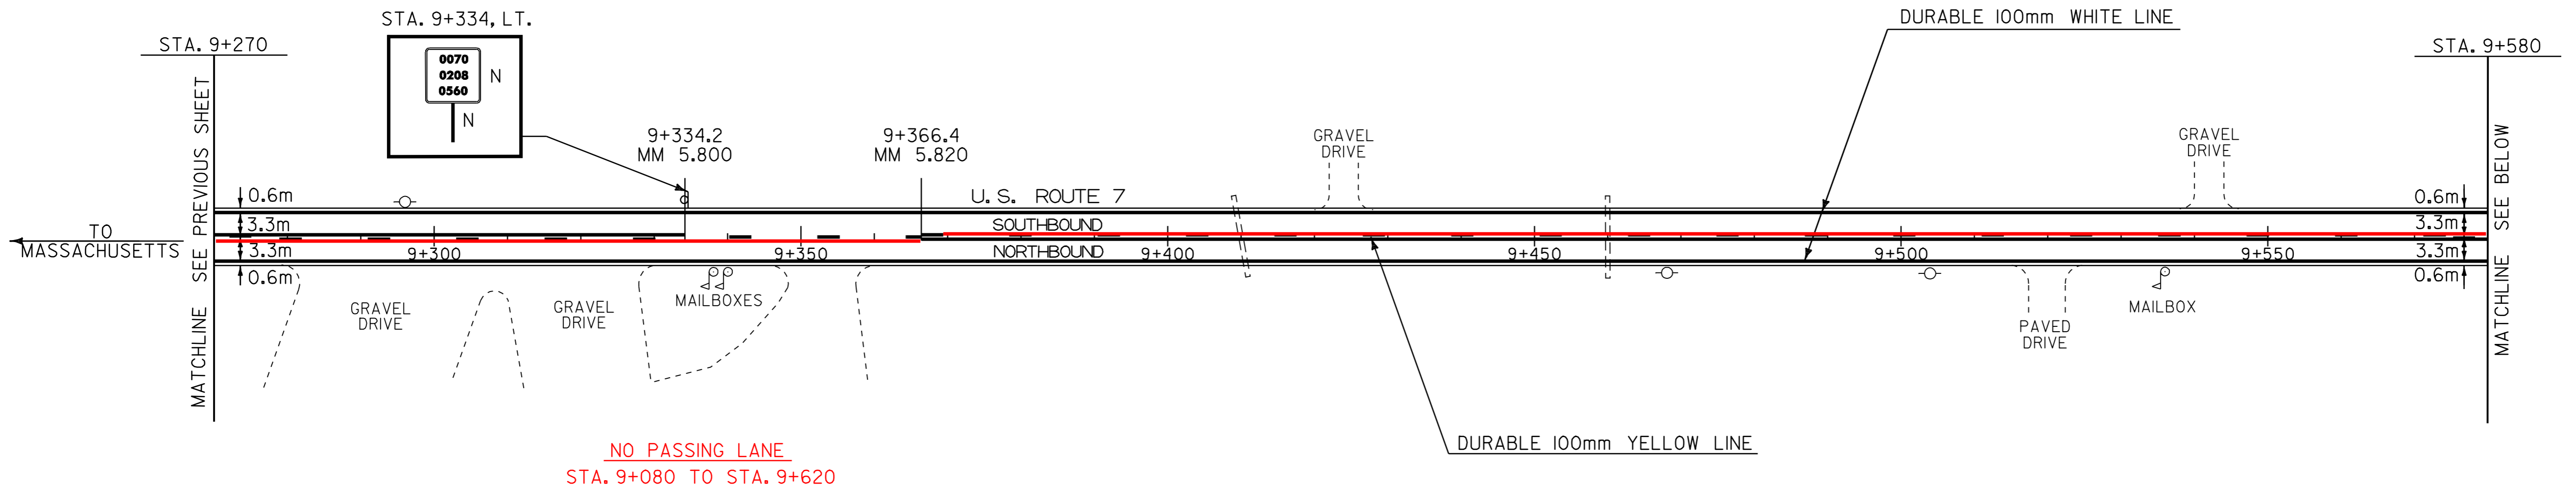

LEGEND

- N = NEW
- R = REMOVE
- R & S = REMOVE AND SALVAGE
- S = SALVAGE SIGN
- RET = RETAIN
- B - B = BACK TO BACK

PAVING PROJECT LAYOUT #21	PROJECT: POWNAL-BENNINGTON	PROJECT NO.: NH 2118(I)S
	DESIGN FILE NAME: /pave/98bl68/pbl68.dgn	PLOT DATE: 17-JAN-2006 14
	IPARM FILE NAME: pbl68i2l.i	SURVEY DATE:
	SURVEYED BY: ACT, SJL, RAL	DRAWN BY: ACT
	SQUAD LEADER: JAV	SHEET: 29 OF 65

DATUM	
VERTICAL	N/A
HORIZONTAL	N/A