


DURABLE 100MM YELLOW LINE (THERMO-PLASTIC)
 STA.10+180.0 TO STA.10+680.0 (LT. AND RT.)
 DURABLE 100MM YELLOW LINE (POLYUREA)
 STA.10+180.0 TO STA.10+680.0 EDGE LINE

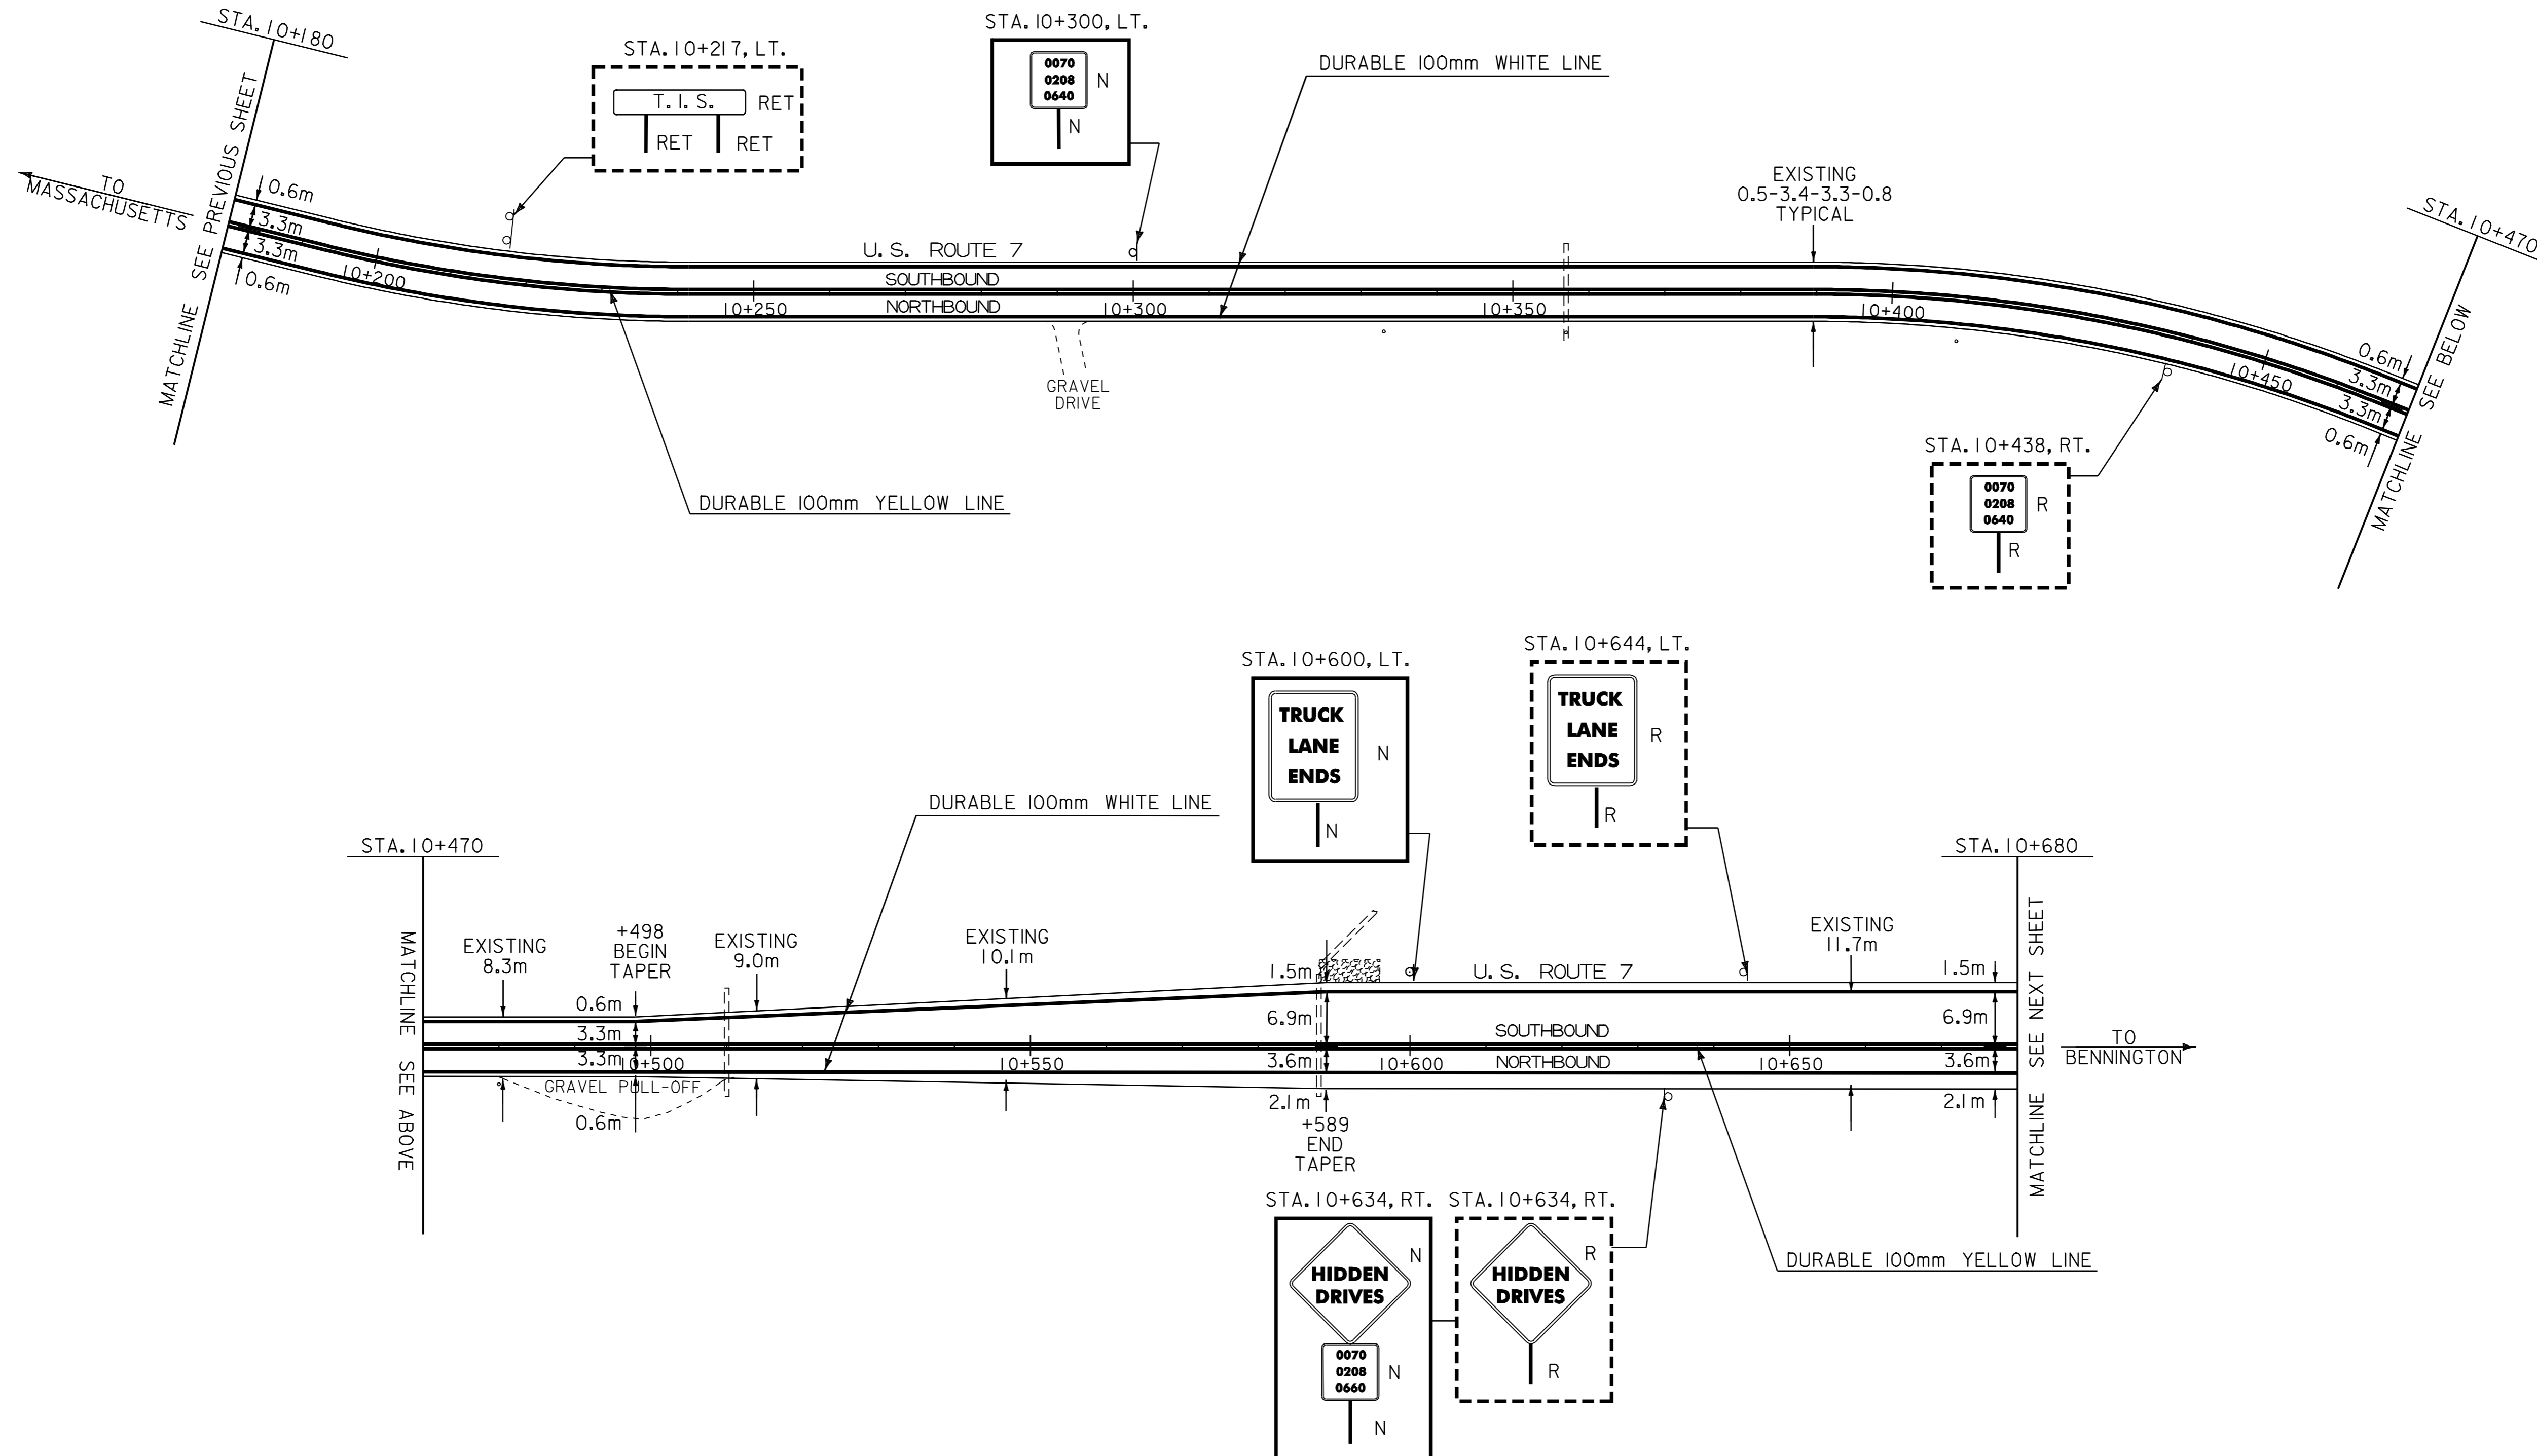

DATUM	
VERTICAL	N/A
HORIZONTAL	N/A

- LEGEND
- N = NEW
 - R = REMOVE
 - R & S = REMOVE AND SALVAGE
 - S = SALVAGE SIGN
 - RET = RETAIN
 - B - B = BACK TO BACK

PAVING PROJECT LAYOUT #23

PROJECT:	POWNAI-BENNINGTON	PROJECT NO.:	NH 2118(I)S
DESIGN FILE NAME:	/pave/98bl68/pbl68.dgn	PLOT DATE:	17-JAN-2006 14
IPARM FILE NAME:	pbl68l23.1	SURVEY DATE:	
SURVEYED BY:	ACT, SJL, RAL	DRAWN BY:	ACT
SQUAD LEADER:	JAV	SHEET:	31 OF 65