


REMOVING SIGNS

7 -- AS SHOWN

DURABLE 100MM YELLOW LINE (THERMO-PLASTIC)  
 STA. 10+680 TO STA. 11+330.0 (LT. AND RT.)

DURABLE 100MM YELLOW LINE (POLYUREA)  
 STA. 10+680 TO STA. 11+330.0 (EDGE LINE.)

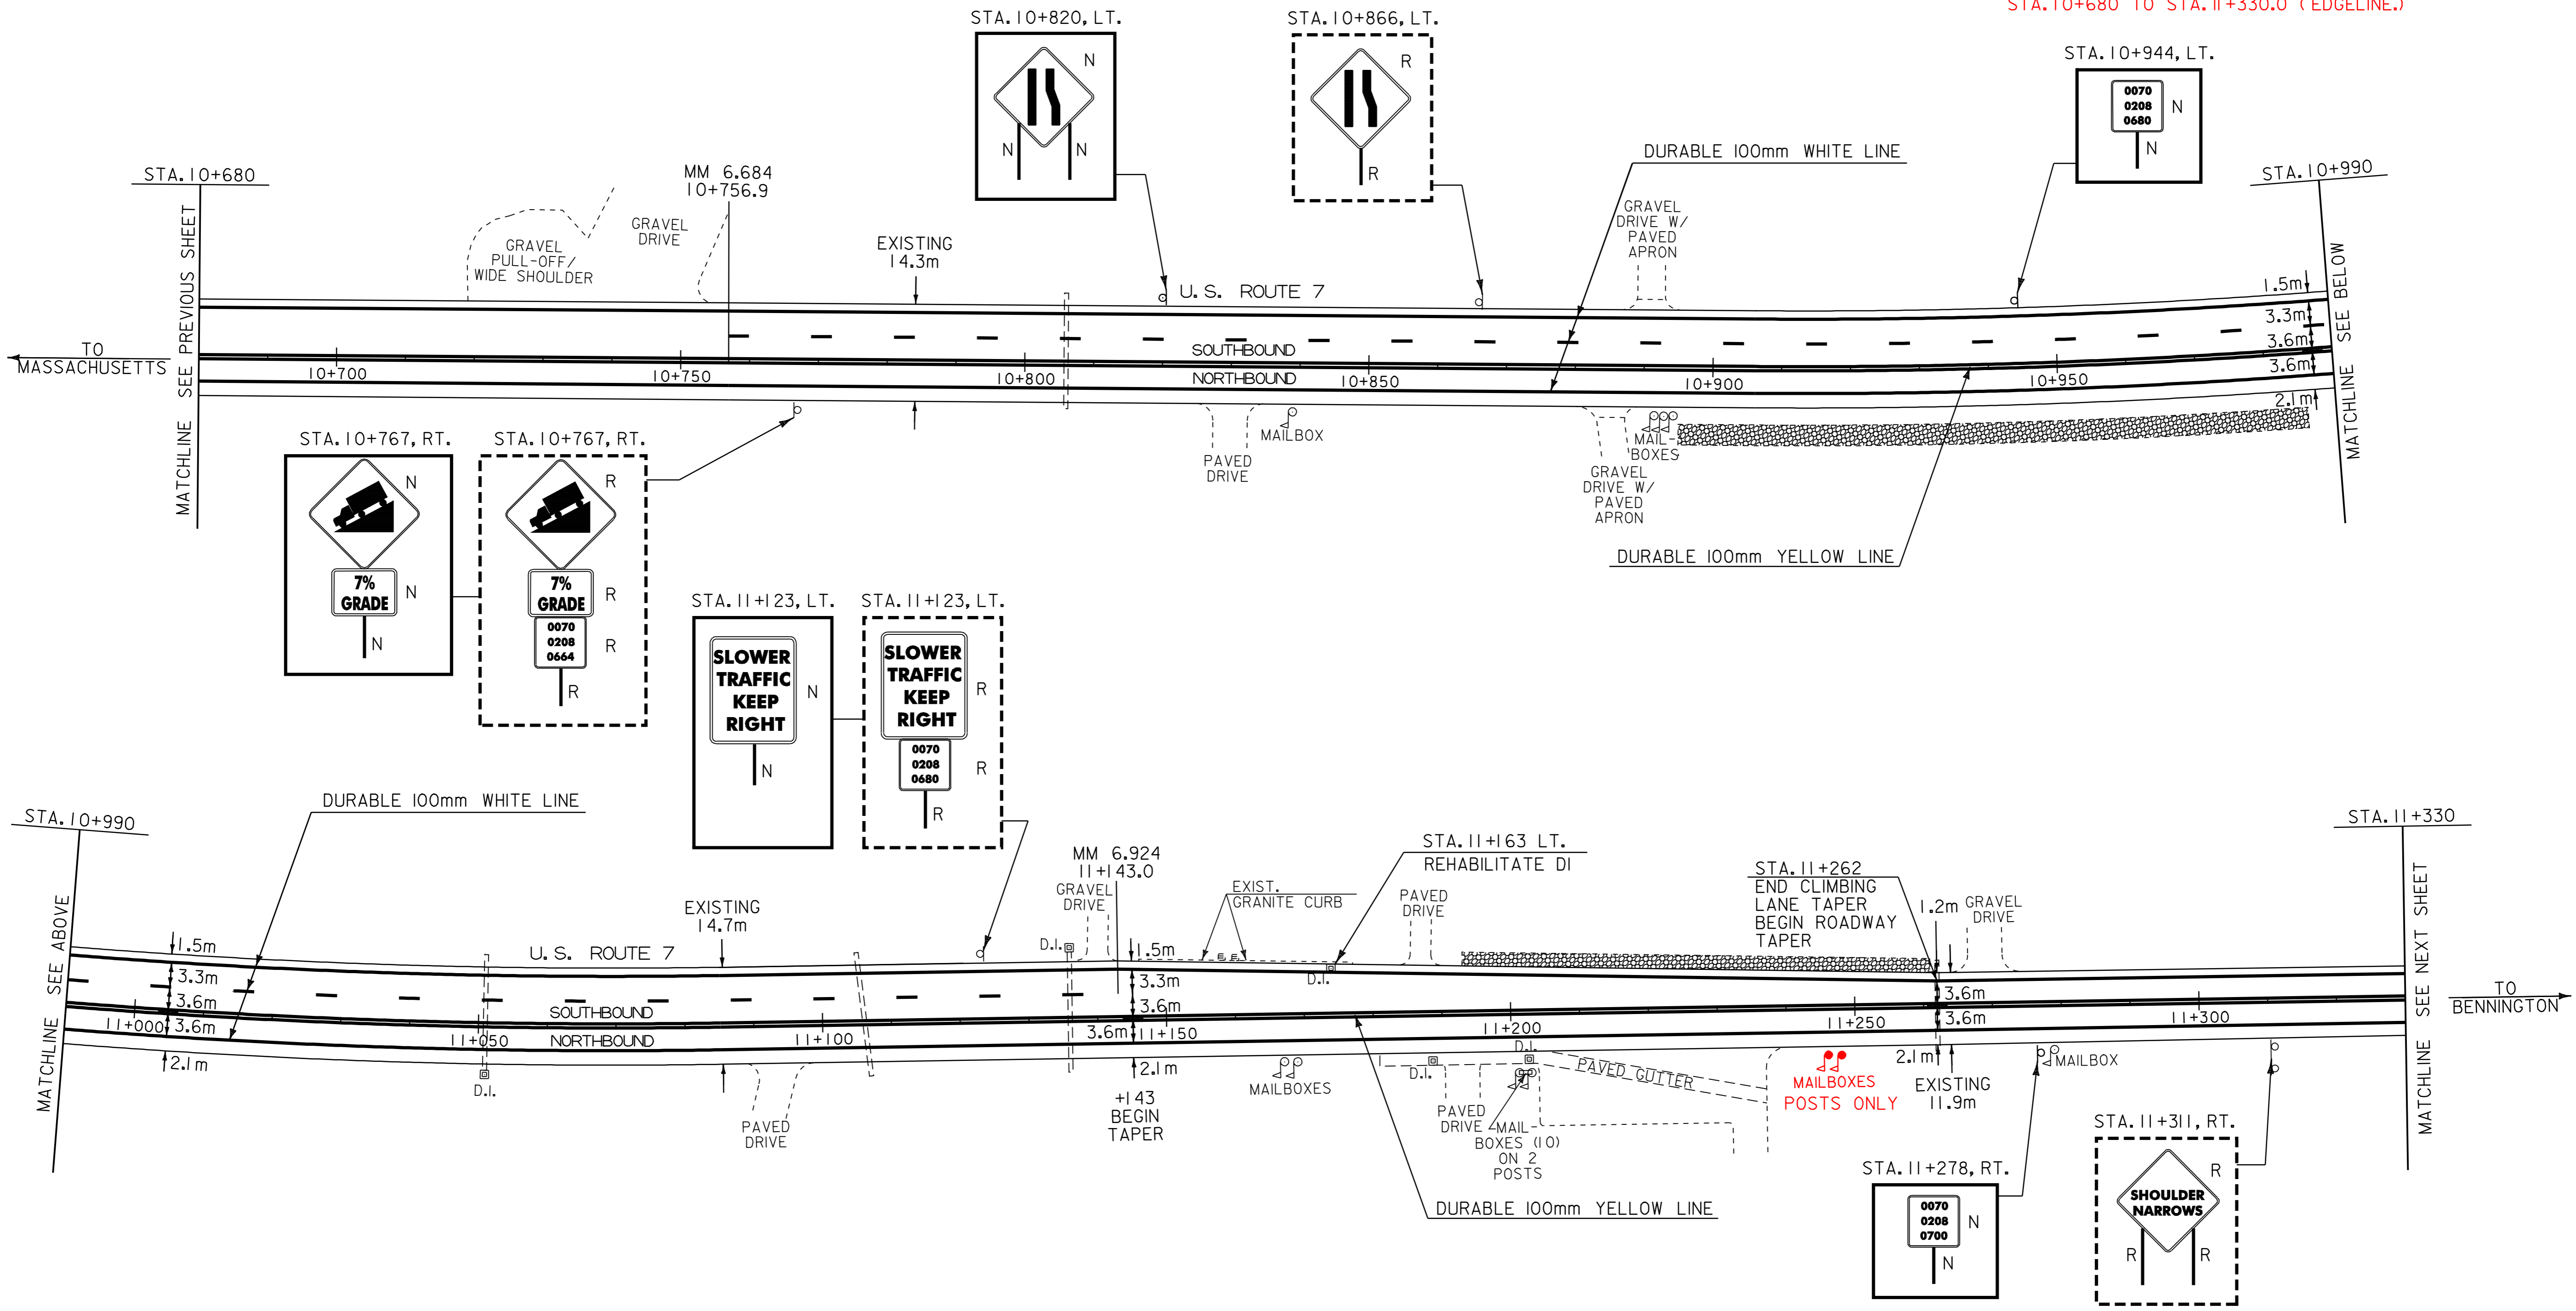

LEGEND  
 N = NEW  
 R = REMOVE  
 R & S = REMOVE AND SALVAGE  
 S = SALVAGE SIGN  
 RET = RETAIN  
 B - B = BACK TO BACK

<b>PAVING PROJECT LAYOUT #24</b>	PROJECT: POWNAL-BENNINGTON	PROJECT NO.: NH 2118(I)S
	DESIGN FILE NAME: /pave/98bl68/pbl68.dgn	PLOT DATE: 17-JAN-2006 14
	IPARM FILE NAME: pbl68i24.i	SURVEY DATE:
	SURVEYED BY: ACT, SJL, RAL	DRAWN BY: ACT
	SQUAD LEADER: JAV	SHEET: 32 OF 65

DATUM	
VERTICAL	N/A
HORIZONTAL	N/A