

STA. 11+330.0 TO STA. 11+670.0 SOLID LT. AND RT.
(WITH CENTERLINE BREAK FOR SIDE ROAD)

STA. 11+330.0 TO STA. 11+670.0 SOLID LT. AND RT. (EDGE LINE)
(WITH EDGE LINE BREAK FOR SIDE ROAD)

5 -- AS SHOWN


ERECTING SALVAGED SIGNS

1 -- AS SHOWN

DURABLE 100MM YELLOW LINE (POLYUREA)(GROUND & IN LAID)
STA. 11+600.0 TO STA. 11+670.0 (LT. AND RT.).

DURABLE 100MM YELLOW LINE (THERMO-PLASTIC)
STA. 11+330.0 TO STA. 11+600.0 (LT. AND RT.).

DURABLE 100MM YELLOW LINE (POLYUREA)
STA. 11+330.0 TO STA. 11+670.0 (EDGE LINE).

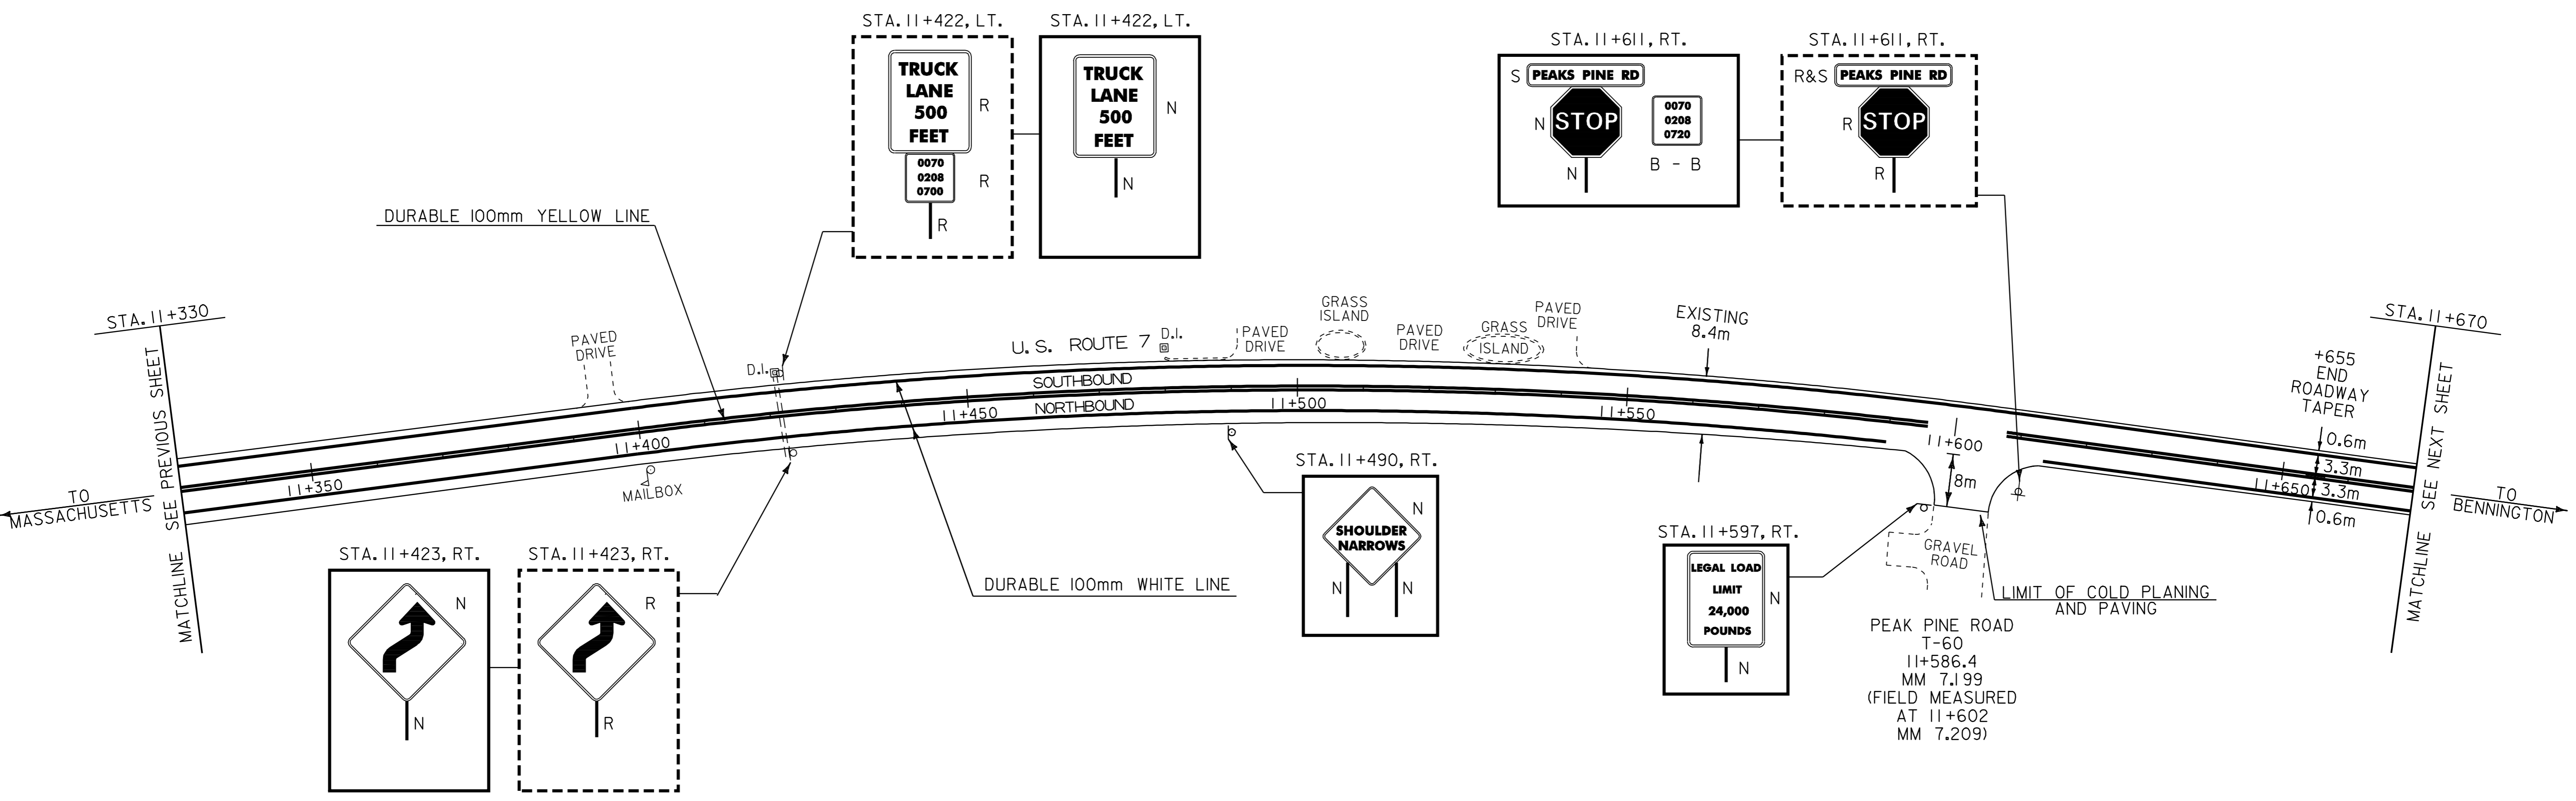

- LEGEND
- N = NEW
 - R = REMOVE
 - R & S = REMOVE AND SALVAGE
 - S = SALVAGE SIGN
 - RET = RETAIN
 - B - B = BACK TO BACK

**PAVING
PROJECT
LAYOUT
#25**

PROJECT: POWNAI-BENNINGTON	PROJECT NO.: NH 2118(I)S
DESIGN FILE NAME: /pave/98bl68/pbl68.dgn	PLOT DATE: 17-JAN-2006 14
IPARM FILE NAME: pbl68i25.1	SURVEY DATE:
SURVEYED BY: ACT, SJL, RAL	DRAWN BY: ACT
SQUAD LEADER: JAV	SHEET: 33 OF 65

DATUM	
VERTICAL	N/A
HORIZONTAL	N/A