

~~TEMPORARY AND DURABLE 100mm YELLOW LINE~~

STA. 11+670.0 TO STA. 11+788.4 SOLID LT. AND RT.
 STA. 11+788.4 TO STA. 12+037.9 SOLID LT. AND DASHED RT.
 STA. 12+037.9 TO STA. 12+102.3 DASHED
 STA. 12+102.3 TO STA. 12+335.6 DASHED LT. AND SOLID RT.
 STA. 12+335.6 TO STA. 12+360.0 SOLID LT. AND RT.

MANUFACTURED TERMINAL SECTION (FLARED)

STA. 11+711.2 RT. TO STA. 11+722.6 RT.
 STA. 11+779.0 LT. TO STA. 11+790.4 LT.
 STA. 11+794.8 RT. TO STA. 11+806.2 RT.
 STA. 11+798.0 LT. TO STA. 11+809.4 LT.

REMOVAL AND DISPOSAL OF GUARD RAIL

STA. 11+715.0 RT. TO STA. 11+807.0 RT.
 STA. 11+779.0 LT. TO STA. 11+807.0 LT.

~~TEMPORARY AND DURABLE 100mm WHITE LINE~~

STA. 11+670.0 TO STA. 12+360.0 SOLID LT. AND RT. (EDGE LINE)

STEEL BEAM GUARD RAIL


STA. 11+790.4 LT. TO STA. 11+798.0 LT.
 STA. 11+722.6 RT. TO STA. 11+794.8 RT.

REMOVING SIGNS

3 -- AS SHOWN

~~DURABLE 100mm WHITE LINE (POLYUREA)~~

STA. 11+670.0 TO STA. 12+020.0 (EDGE LINE).

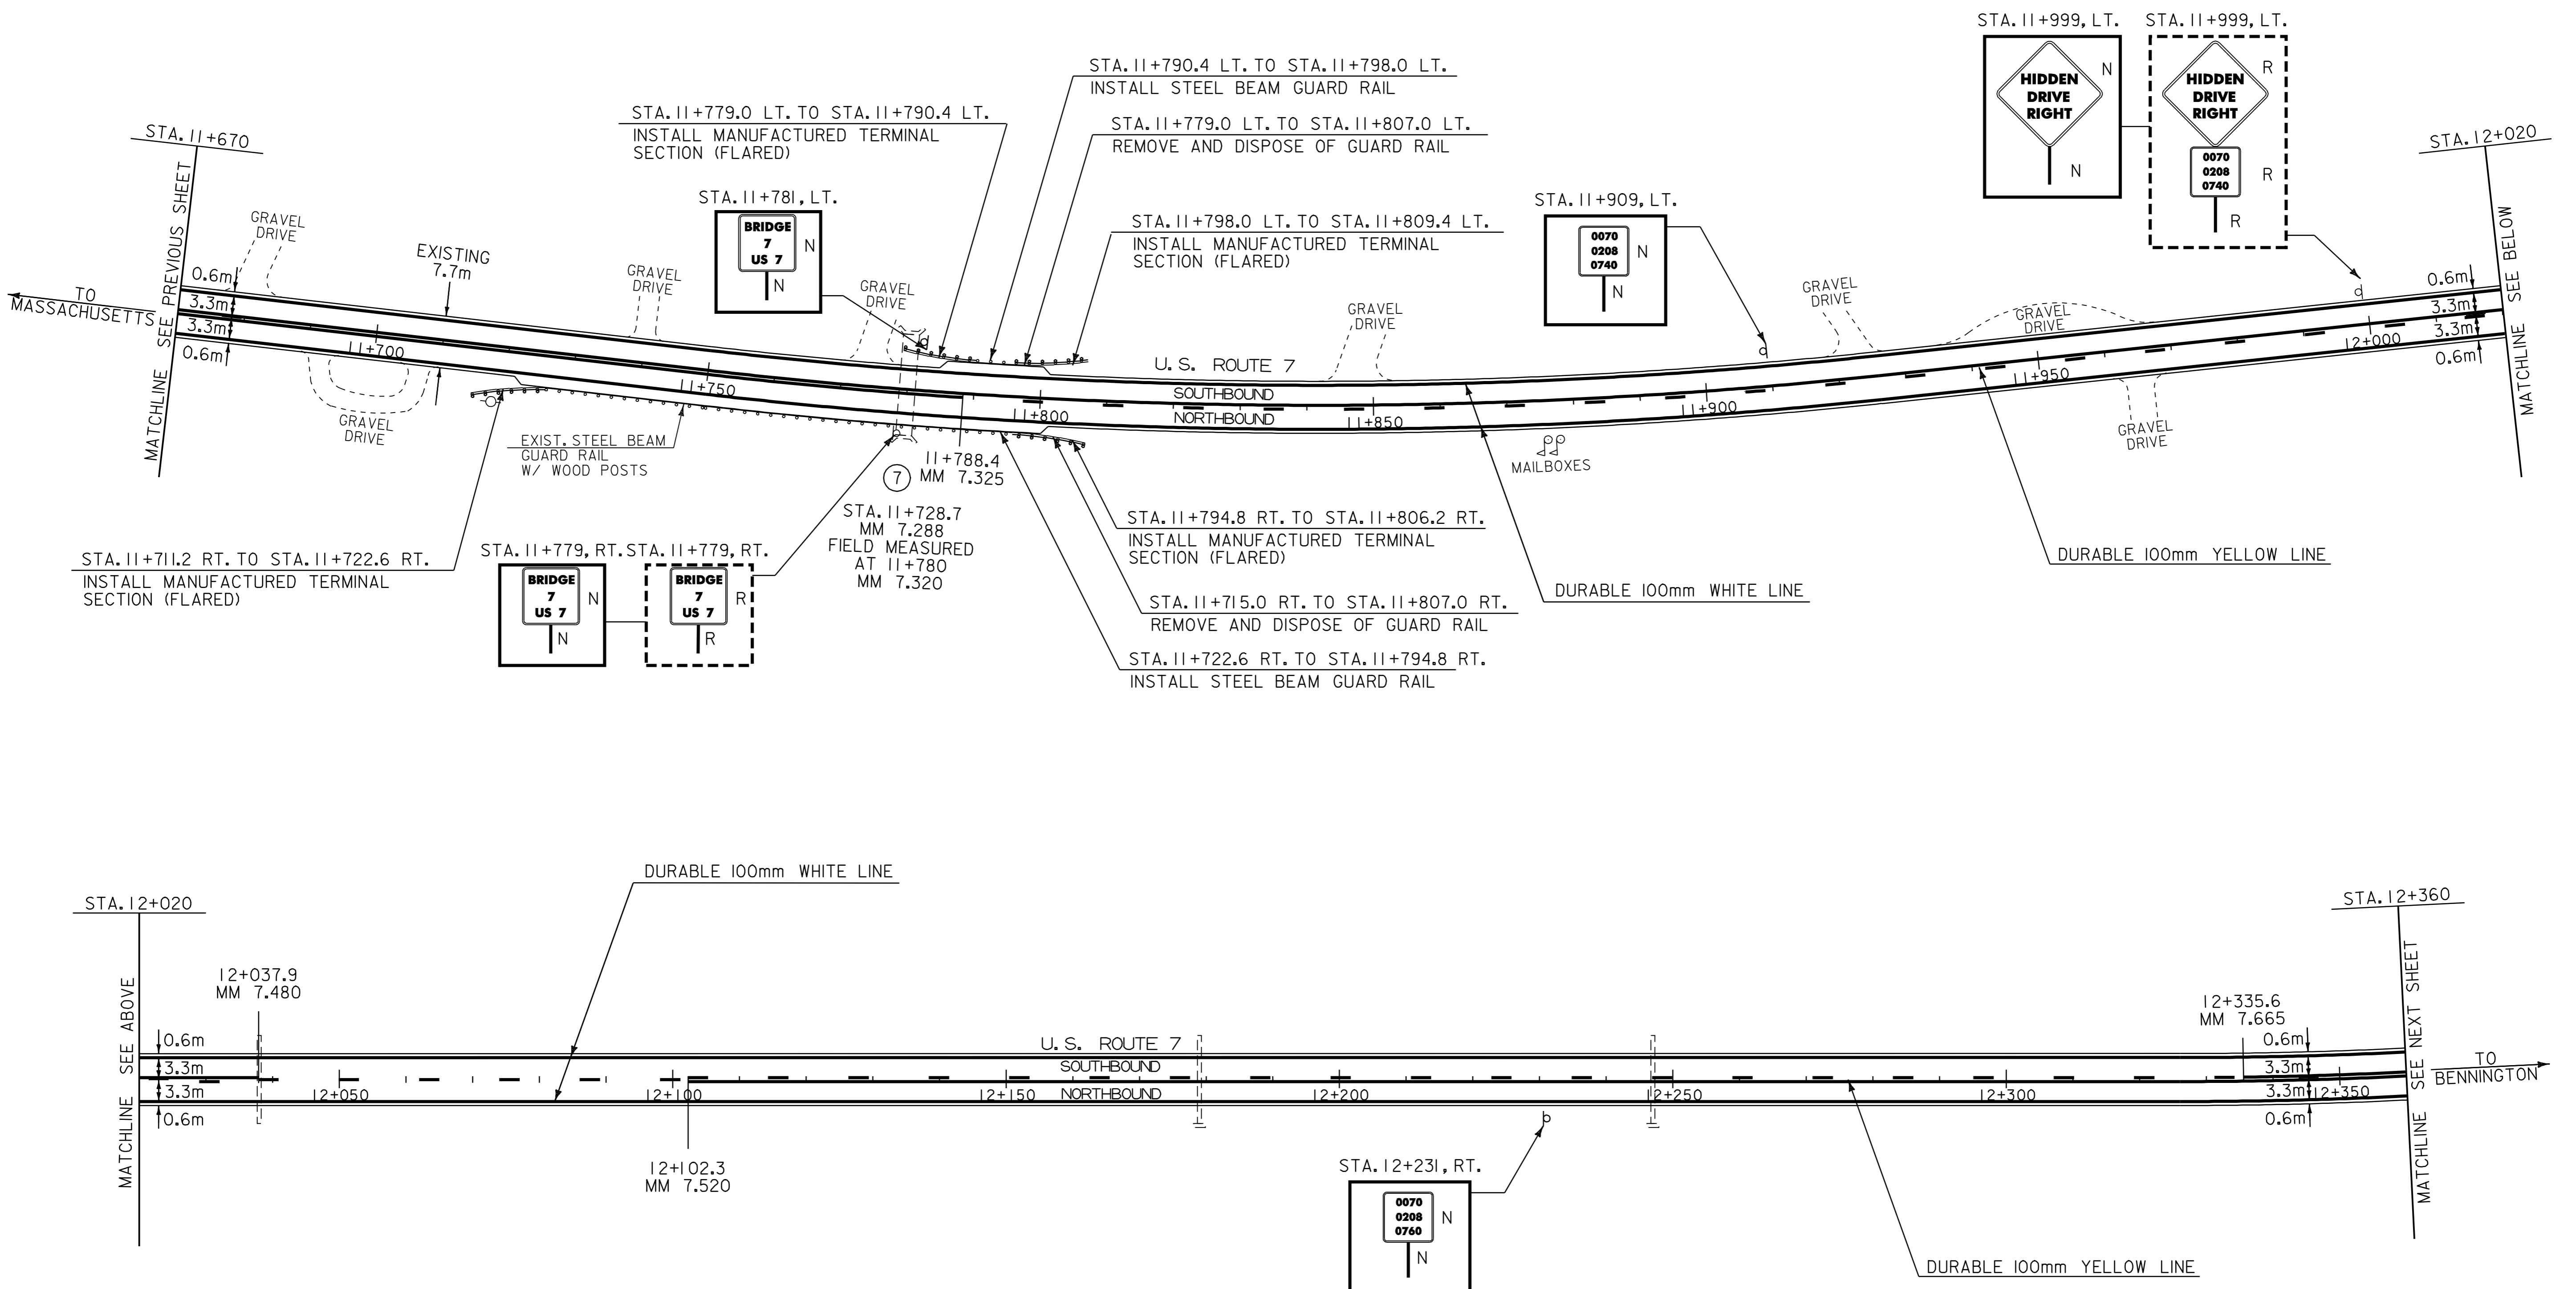

DATUM	
VERTICAL	N/A
HORIZONTAL	N/A

- LEGEND
- N = NEW
 - R = REMOVE
 - R & S = REMOVE AND SALVAGE
 - S = SALVAGE SIGN
 - RET = RETAIN
 - B - B = BACK TO BACK

PAVING PROJECT LAYOUT #26	PROJECT:	POWNAI-BENNINGTON	PROJECT NO.:	NH 2118(I)S
	DESIGN FILE NAME:	/pave/98bl68/pbl68.dgn	PLOT DATE:	17-JAN-2006 14
	IPARM FILE NAME:	pbl68l26.1	SURVEY DATE:	
	SURVEYED BY:	ACT, SJL, RAL	SQUAD LEADER:	JAV
		DRAWN BY:		ACT
		SHEET:		34 OF 65