

~~TEMPORARY AND DURABLE 100mm YELLOW LINE~~

STA. 0+015.0 TO STA. 0+690.0 SOLID LT. AND RT.

REMOVAL AND DISPOSAL OF GUARD RAIL

STA. 0+018.0 RT. TO STA. 0+117.0 RT.
STA. 0+474.0 LT. TO STA. 0+536.0 LT.

MANUFACTURED TERMINAL SECTION (FLARED)

STA. 0+018.0 RT. TO STA. 0+029.4 RT.
STA. 0+105.6 RT. TO STA. 0+117.0 RT.
STA. 0+474.0 LT. TO STA. 0+485.4 LT.
STA. 0+551.2 LT. TO STA. 0+562.6 LT.

SHOULDER BERM REMOVAL

~~STA. 0+029 RT. TO STA. 0+106 RT.~~
~~STA. 0+485 LT. TO STA. 0+525 LT.~~

~~TEMPORARY AND DURABLE 100mm WHITE LINE~~

STA. 0+015.0 TO STA. 0+690.0 SOLID LT. AND RT. (EDGE LINE)

STEEL BEAM GUARD RAIL

STA. 0+029.4 RT. TO STA. 0+105.6 RT.
STA. 0+524.6 LT. TO STA. 0+551.2 LT.

DURABLE 100MM YELLOW LINE (POLYUREA) GROUND & IN LAID


STA. 0+015.0 TO STA. 0+690.0 (LT & RT).

REMOVING SIGNS

3 4 -- AS SHOWN

DURABLE 100MM WHITE LINE (POLYUREA)

STA. 0+015.0 TO STA. 0+690.0 (EDGE LINE).

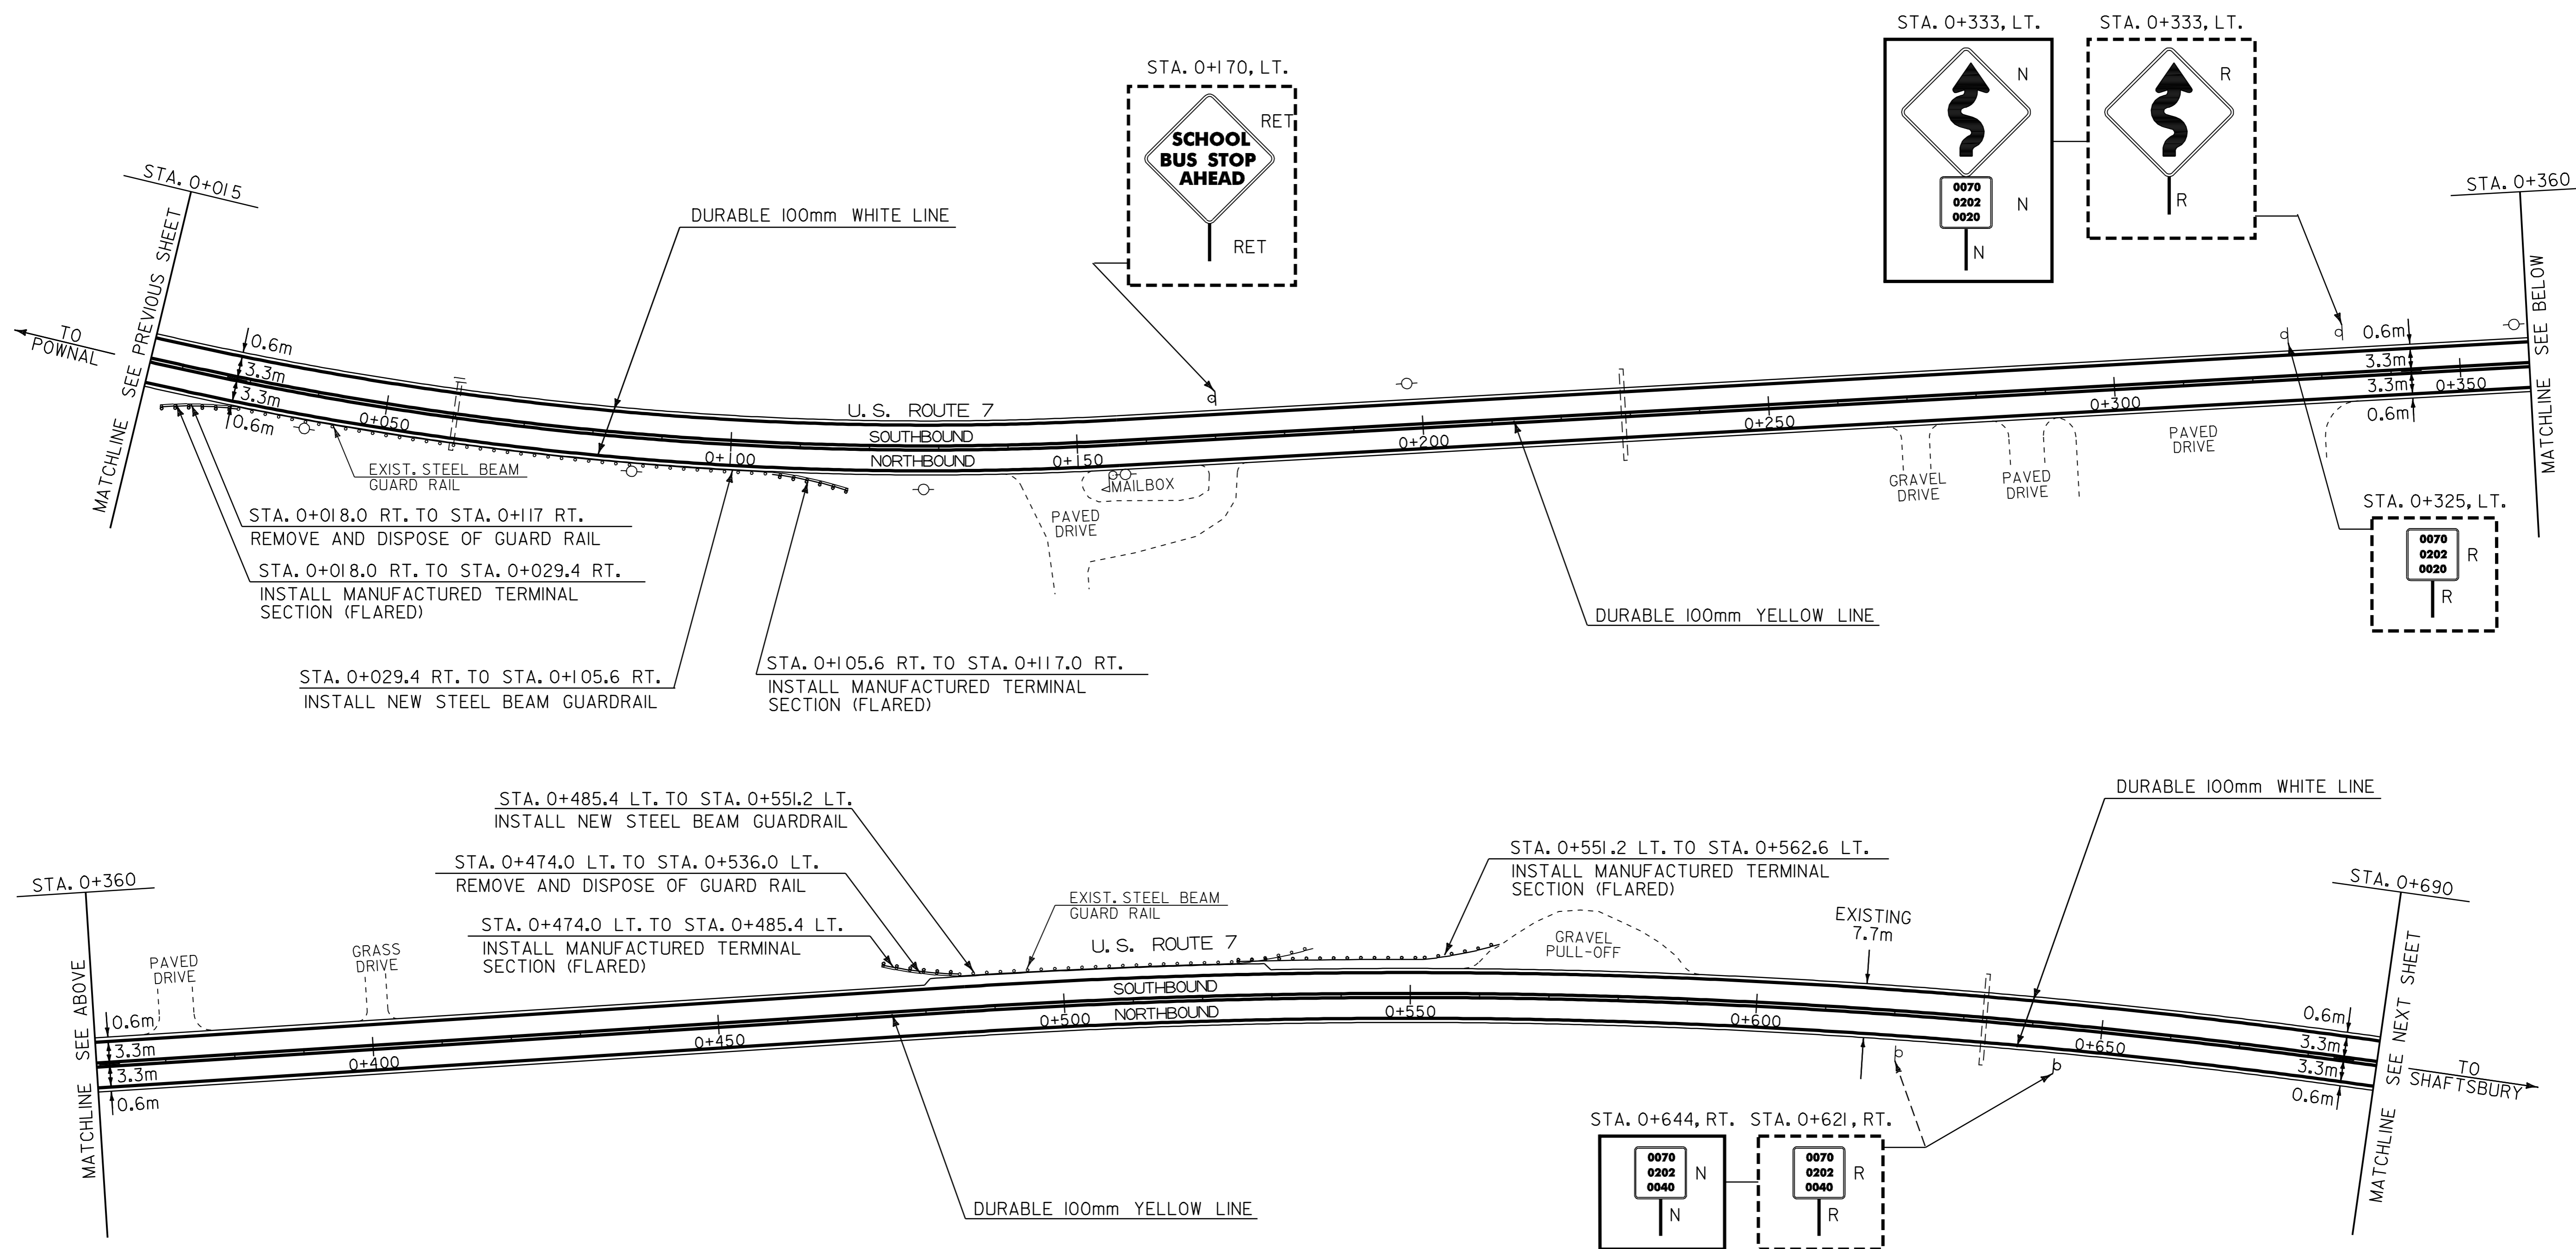

LEGEND

- N = NEW
- R = REMOVE
- R & S = REMOVE AND SALVAGE
- S = SALVAGE SIGN
- RET = RETAIN
- B - B = BACK TO BACK

PAVING PROJECT LAYOUT #28	PROJECT: POWNAL-BENNINGTON	PROJECT NO.: NH 2118(I)S
	DESIGN FILE NAME: /pave/98bl68/pbl68.dgn	PLOT DATE: 17-JAN-2006 14
	IPARM FILE NAME: pbl68l28.1	SURVEY DATE:
	SURVEYED BY: ACT, SJL, RAL	DRAWN BY: ACT
	SQUAD LEADER: JAV	SHEET: 36 OF 65

DATUM	
VERTICAL	N/A
HORIZONTAL	N/A