
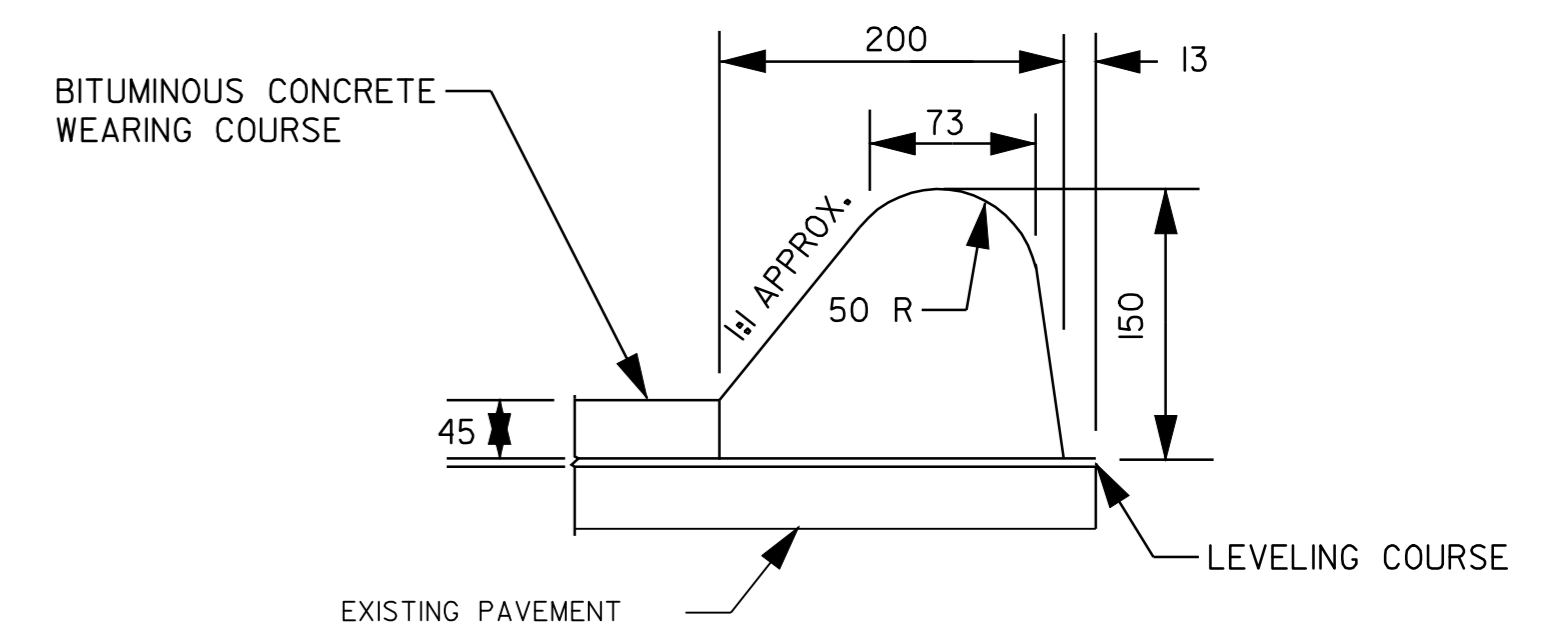
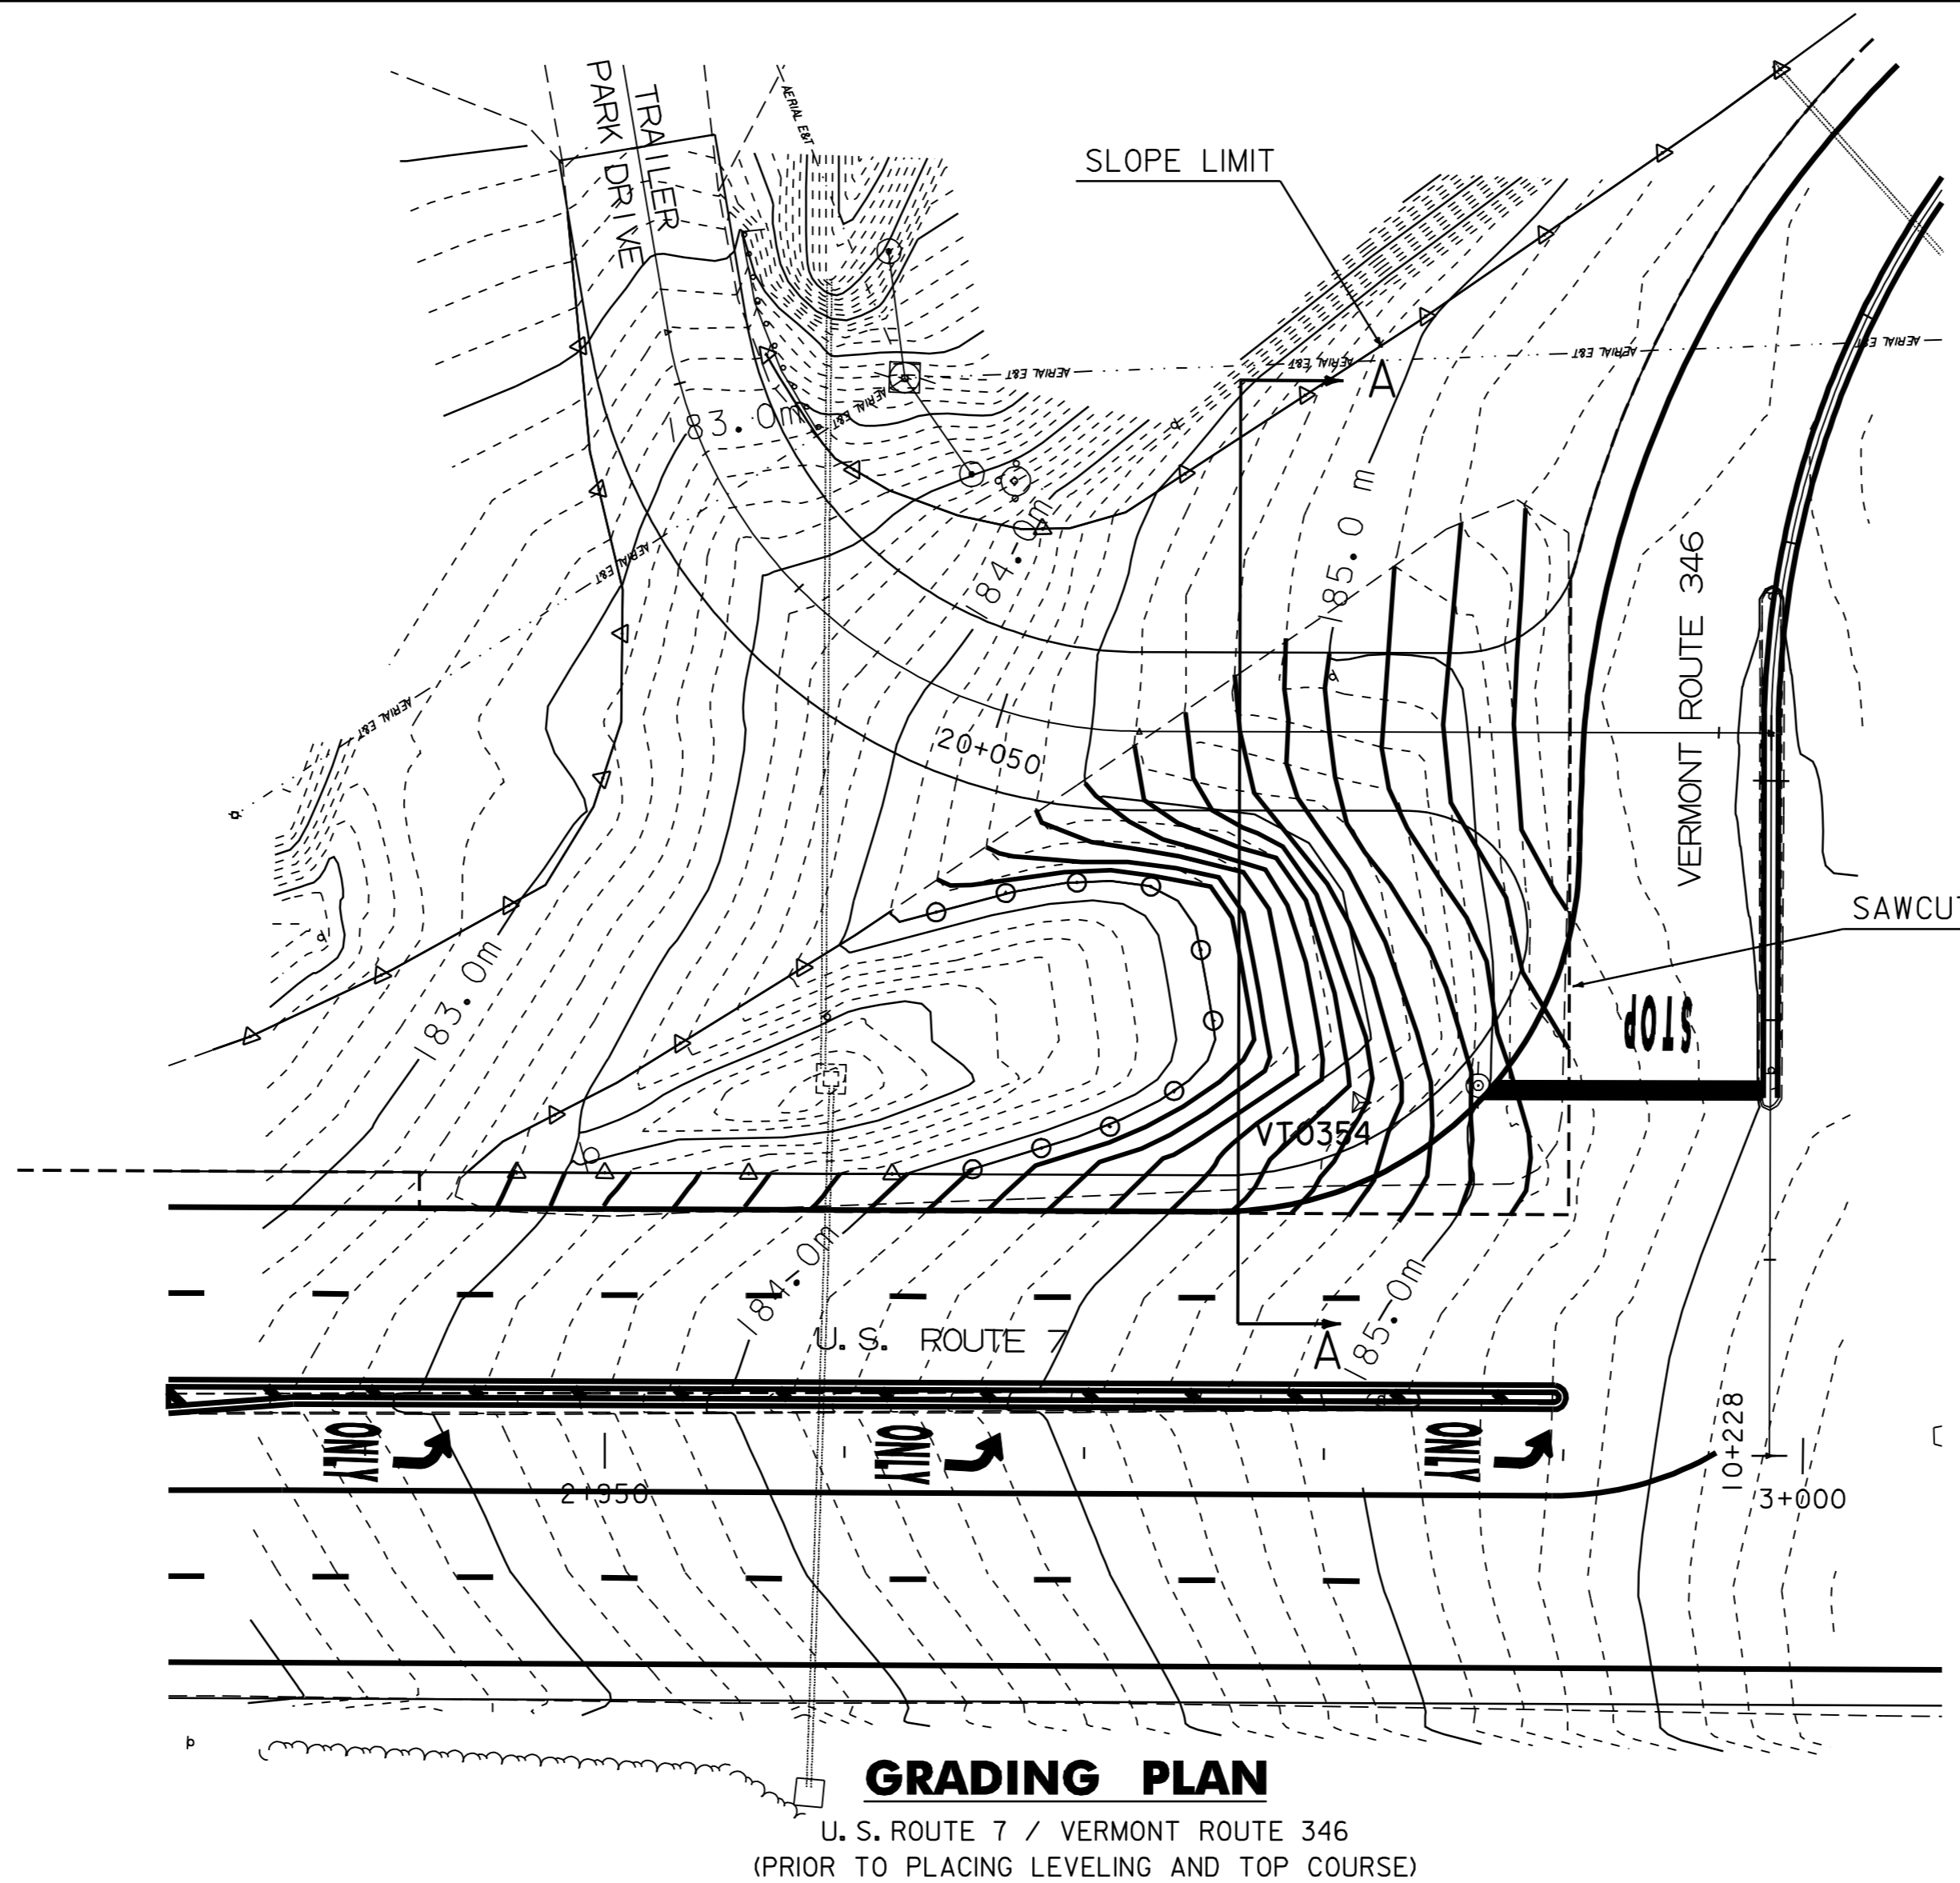


REMOVE 450mm EXISTING PAVEMENT
AND AGGREGATE MATERIAL AND REPLACE
WITH EARTH BORROW, TOPSOIL, AND SEED

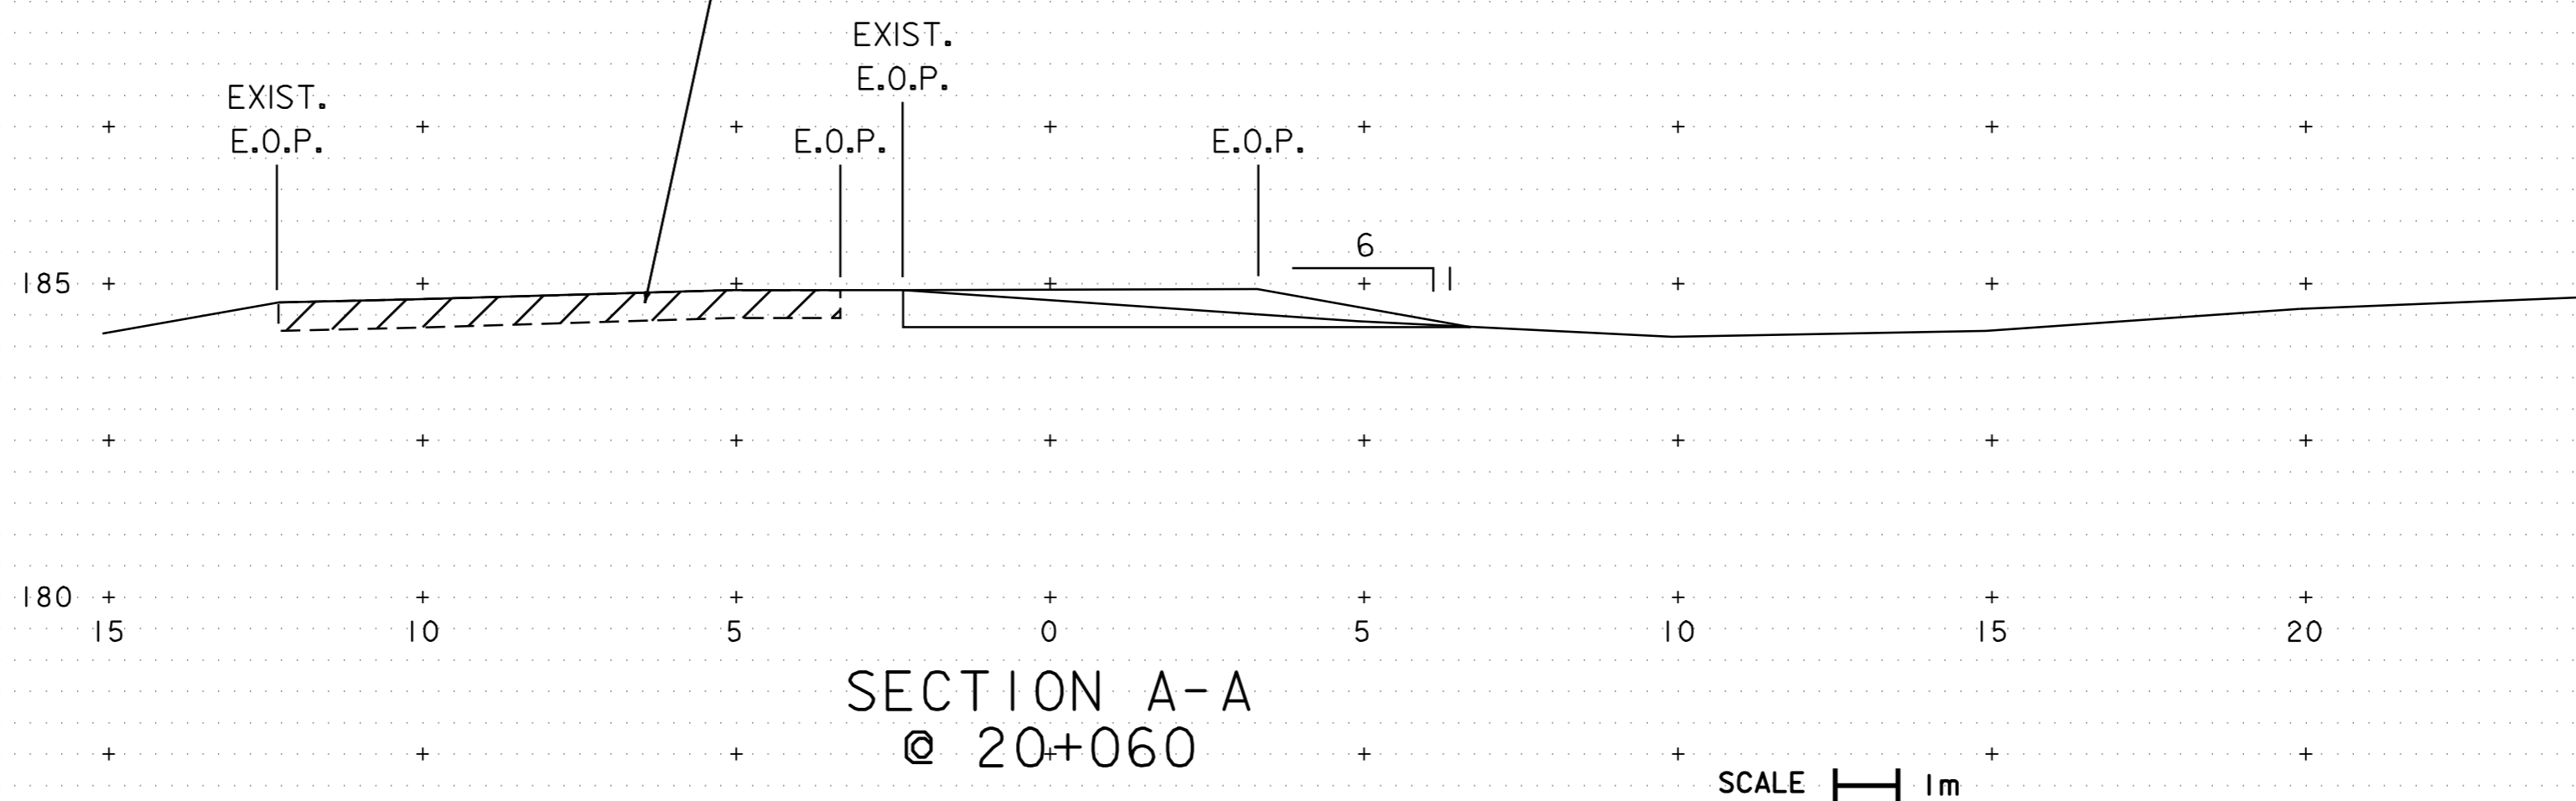

DETAIL FOR BITUMINOUS CONCRETE CURB TYPE B
NOT TO SCALE

DATUM	
VERTICAL	N/A
HORIZONTAL	N/A

**MISCELLANEOUS
DETAILS
#3**

PROJECT: POWNAI-BENNINGTON	PROJECT NO.: NH 2118(I)S
DESIGN FILE NAME: /pave/98bl68/pbl68.dgn	PLOT DATE: 17-JAN-2006 14
IPARM FILE NAME: pbl68md03.1	SURVEY DATE:
SURVEYED BY: ACT, SJL, RAL	DRAWN BY: ACT
SQUAD LEADER: JAV	SHEET: 64 OF 65