

646.40 DURABLE 100 mm WHITE LINE
 (ALL LINES WILL INCLUDE EDGE LINE BREAKS AND RADIUS FOR TOWN HIGHWAYS)
 ROCHESTER:
 STA. 10+320.0 - STA. 10+860.0 LT & RT


646.41 DURABLE 100 mm YELLOW LINE
 (ALL LINES WILL INCLUDE C/L BREAKS FOR TOWN HIGHWAYS) S=SOLID, D=DASHED
 ROCHESTER:
 STA. 10+320.0 - STA. 10+860.0 LT S C RT S

646.60 TEMPORARY 100 mm WHITE LINE
 (ALL LINES WILL INCLUDE EDGE LINE BREAKS AND RADIUS FOR TOWN HIGHWAYS)
 ROCHESTER:
 STA. 10+320.0 - STA. 10+860.0 LT & RT

646.61 TEMPORARY 100 mm YELLOW LINE
 (ALL LINES WILL INCLUDE C/L BREAKS FOR TOWN HIGHWAYS) S=SOLID, D=DASHED
 ROCHESTER:
 STA. 10+320.0 - STA. 10+860.0 LT S C RT S

DITCHING LOCATIONS

ROCHESTER:
 STA. 10+493 - STA. 10+860 RT
 (SEE SHEET 8 FOR DETAILS)

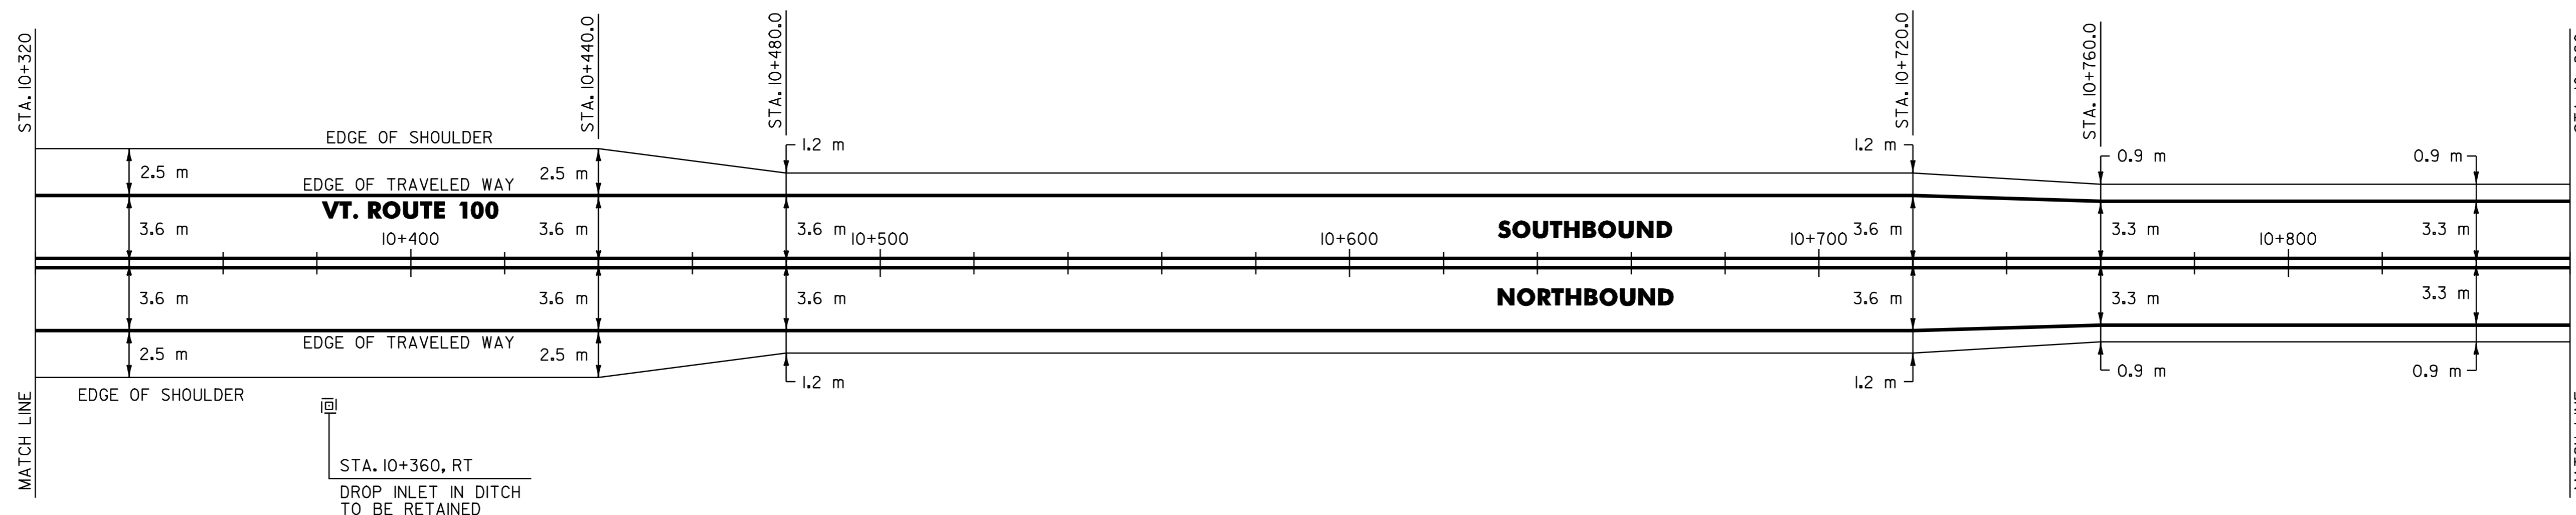

DATUM	
VERTICAL	<u>N/A</u>
HORIZONTAL	<u>N/A</u>

PAVING PROJECT LAYOUT	SURVEYED BY <u>N/A</u> DATE <u>N/A</u>
	DRAWN BY <u>C.A.K.</u> DATE <u>11/00</u>
	SQUAD LEADER <u>T.P.K.</u>
	DESIGN FILE NO. <u>/pave/98bl80/pbl80.dgn</u>
	IPARM FILE <u>pbl80p02.i</u> DATE PLOTTED <u>21-DEC-2006 15</u>
PROJ. NAME <u>ROCHESTER-GRANVILLE</u>	
PROJ. NO. <u>AC_SIP_2124(1)S</u>	
SHEET <u>10</u> OF <u>49</u> SHEETS	