

646.40 DURABLE 100 mm WHITE LINE  
(ALL LINES WILL INCLUDE EDGE LINE BREAKS AND RADIUS FOR TOWN HIGHWAYS)

ROCHESTER:  
STA. 13+020.0 - STA. 13+455.725 LT & RT

HANCOCK:  
STA. 0+000.000 - STA. 0+100.0 LT & RT

646.60 TEMPORARY 100 mm WHITE LINE  
(ALL LINES WILL INCLUDE EDGE LINE BREAKS AND RADIUS FOR TOWN HIGHWAYS)

ROCHESTER:  
STA. 13+020.0 - STA. 13+455.725 LT & RT

HANCOCK:  
STA. 0+000.000 - STA. 0+100.0 LT & RT

646.41 DURABLE 100 mm YELLOW LINE  
(ALL LINES WILL INCLUDE C/L BREAKS FOR TOWN HIGHWAYS) S=SOLID, D=DASHED

ROCHESTER:  
STA. 13+020.0 - STA. 13+084.0 - D - S  
STA. 13+084.0 - STA. 13+309.3 - D - S  
STA. 13+309.3 - STA. 13+455.725 - S - S

HANCOCK:  
STA. 0+000.000 - STA. 0+100.0 - S - S


646.61 TEMPORARY 100 mm YELLOW LINE  
(ALL LINES WILL INCLUDE C/L BREAKS FOR TOWN HIGHWAYS) S=SOLID, D=DASHED

ROCHESTER:  
STA. 13+020.0 - STA. 13+084.0 - D - S  
STA. 13+084.0 - STA. 13+309.3 - D - S  
STA. 13+309.3 - STA. 13+455.725 - S - S

HANCOCK:  
STA. 0+000.000 - STA. 0+100.0 - S - S

**DITCHING LOCATIONS**

ROCHESTER:  
STA. 13+144 - STA. 13+322 LT  
HANCOCK:  
STA. 0+000 - STA. 0+100 LT  
(SEE SHEET 8 FOR DETAILS)

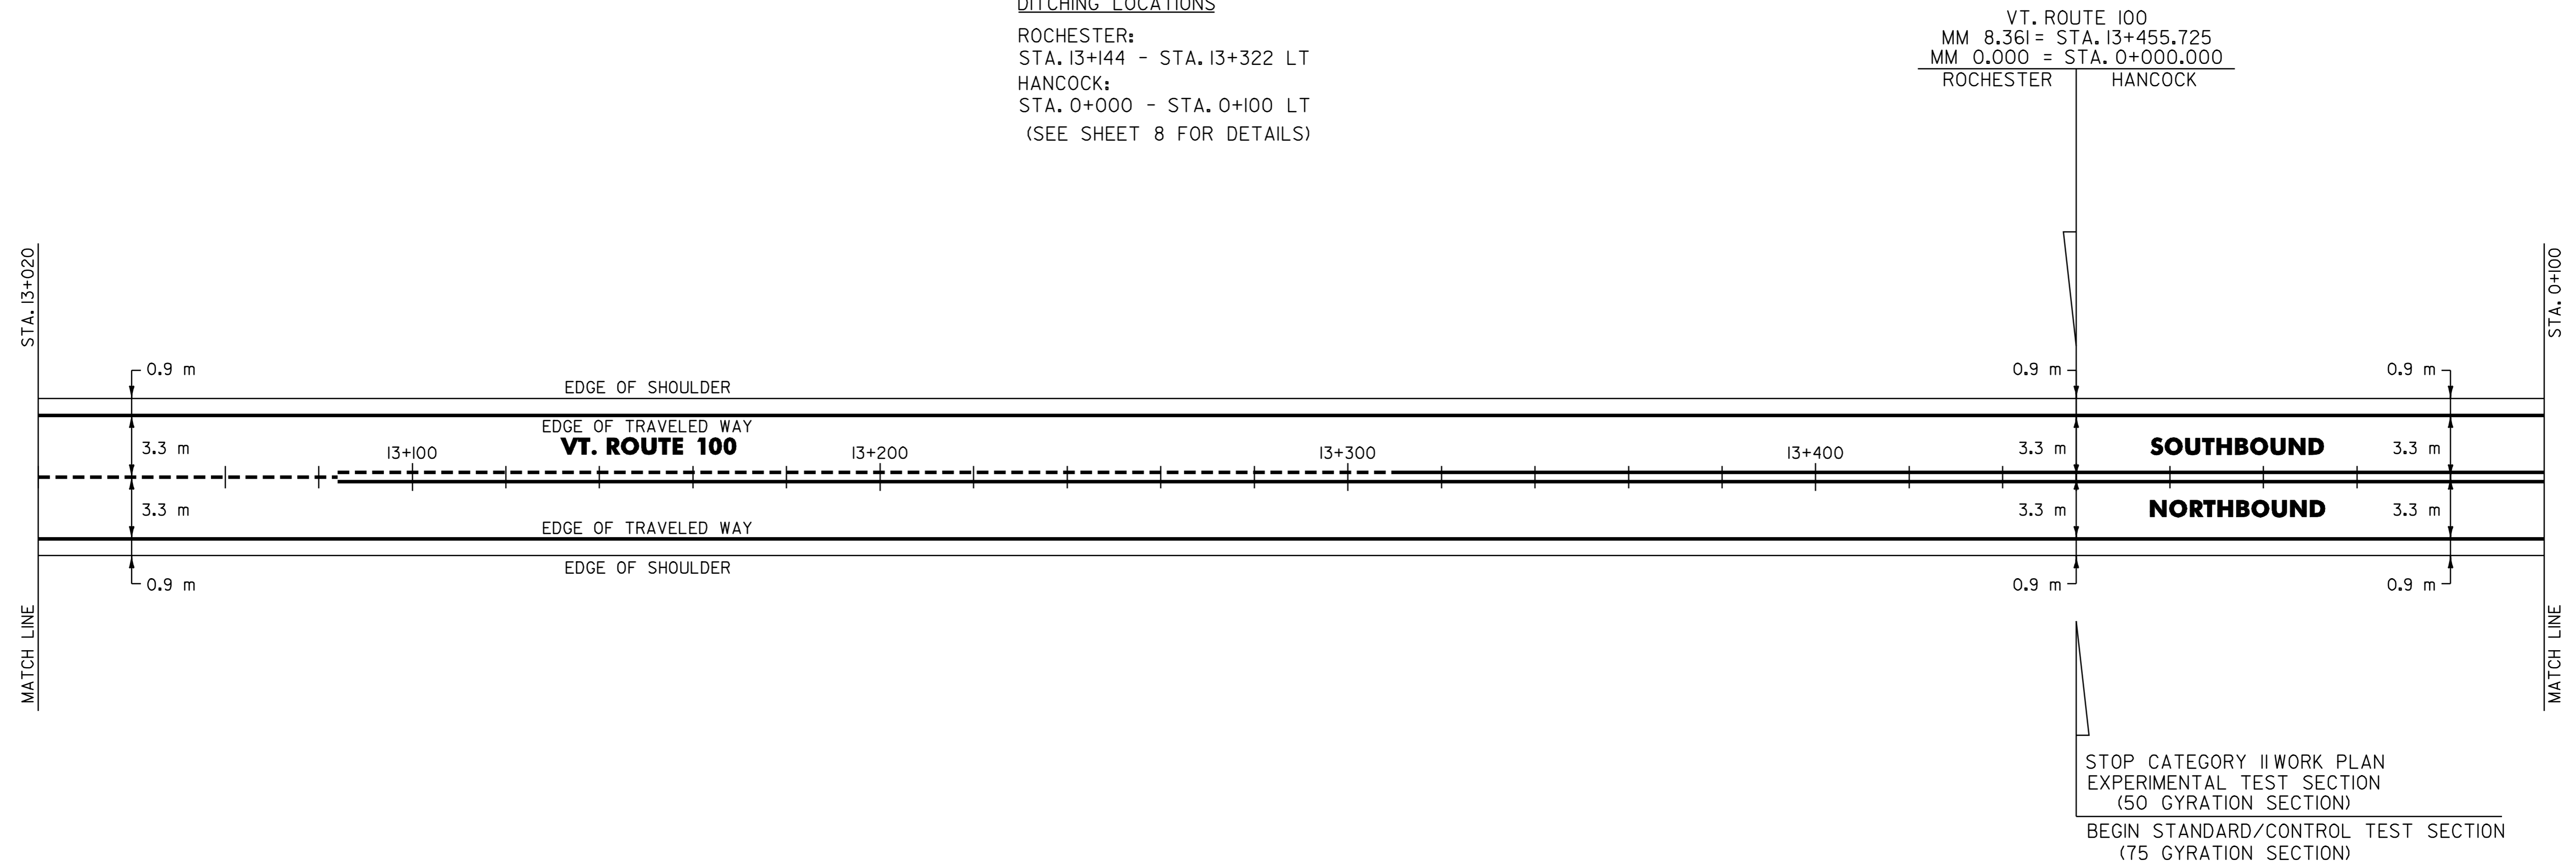

**NOTE:**

1. THE CONTRACTOR SHOULD BE AWARE THAT AN EXISTING BURIED PHONE CABLE IS LOCATED NEAR THE ROCHESTER/HANCOCK TOWN LINE. THE CONTRACTOR IS RESPONSIBLE FOR CONTACTING "DIG SAFE" AT 1-888-344-7233 TO DETERMINE THE EXACT LOCATION OF THE PHONE CABLE PRIOR TO PERFORMING ANY DITCH CLEANING IN THIS AREA.

DATUM	
VERTICAL	N/A
HORIZONTAL	N/A

<b>PAVING PROJECT LAYOUT</b>	SURVEYED BY	N/A	DATE	N/A
	DRAWN BY	C.A.K.	DATE	11/00
	SQUAD LEADER	T.P.K.		
	DESIGN FILE NO.	/pave/98b180/pb180.dgn		
	IPARM FILE	pb180p07.i	DATE PLOTTED	21-DEC-2006 15
PROJ. NAME	ROCHESTER-GRANVILLE			
PROJ. NO.	AC_SIP_2124(1)S			
SHEET	15	OF	49	SHEETS