

646.40 DURABLE 100 mm WHITE LINE  
(ALL LINES WILL INCLUDE EDGE LINE BREAKS AND RADIUS FOR TOWN HIGHWAYS)

HANCOCK:  
STA. 0+100.0 - STA. 0+660.0 LT & RT

646.60 TEMPORARY 100 mm WHITE LINE  
(ALL LINES WILL INCLUDE EDGE LINE BREAKS AND RADIUS FOR TOWN HIGHWAYS)

HANCOCK:  
STA. 0+100.0 - STA. 0+660.0 LT & RT

646.41 DURABLE 100 mm YELLOW LINE  
(ALL LINES WILL INCLUDE C/L BREAKS FOR TOWN HIGHWAYS) S=SOLID, D=DASHED

HANCOCK:  
STA. 0+100.0 - STA. 0+660.0 LT S C RT S  
STA. 0+606.723 DOUBLE SOLID LT, T-12

646.61 TEMPORARY 100 mm YELLOW LINE  
(ALL LINES WILL INCLUDE C/L BREAKS FOR TOWN HIGHWAYS) S=SOLID, D=DASHED

HANCOCK:  
STA. 0+100.0 - STA. 0+660.0 LT S C RT S

646.46 DURABLE 600 mm STOP BAR

HANCOCK:  
STA. 0+606.723 LT, T-12

646.50 DURABLE LETTER OR SYMBOL

HANCOCK:  
STA. 0+606.723 LT, T-12, "S,T,O,P" (4 EA)

675.50 REMOVING SIGNS


AS SHOWN - 3

675.60 ERECTING SALVAGED SIGNS

AS SHOWN - 3

**DITCHING LOCATIONS**

HANCOCK:  
STA. 0+100 - STA. 0+467 LT  
(SEE SHEET 8 FOR DETAILS)

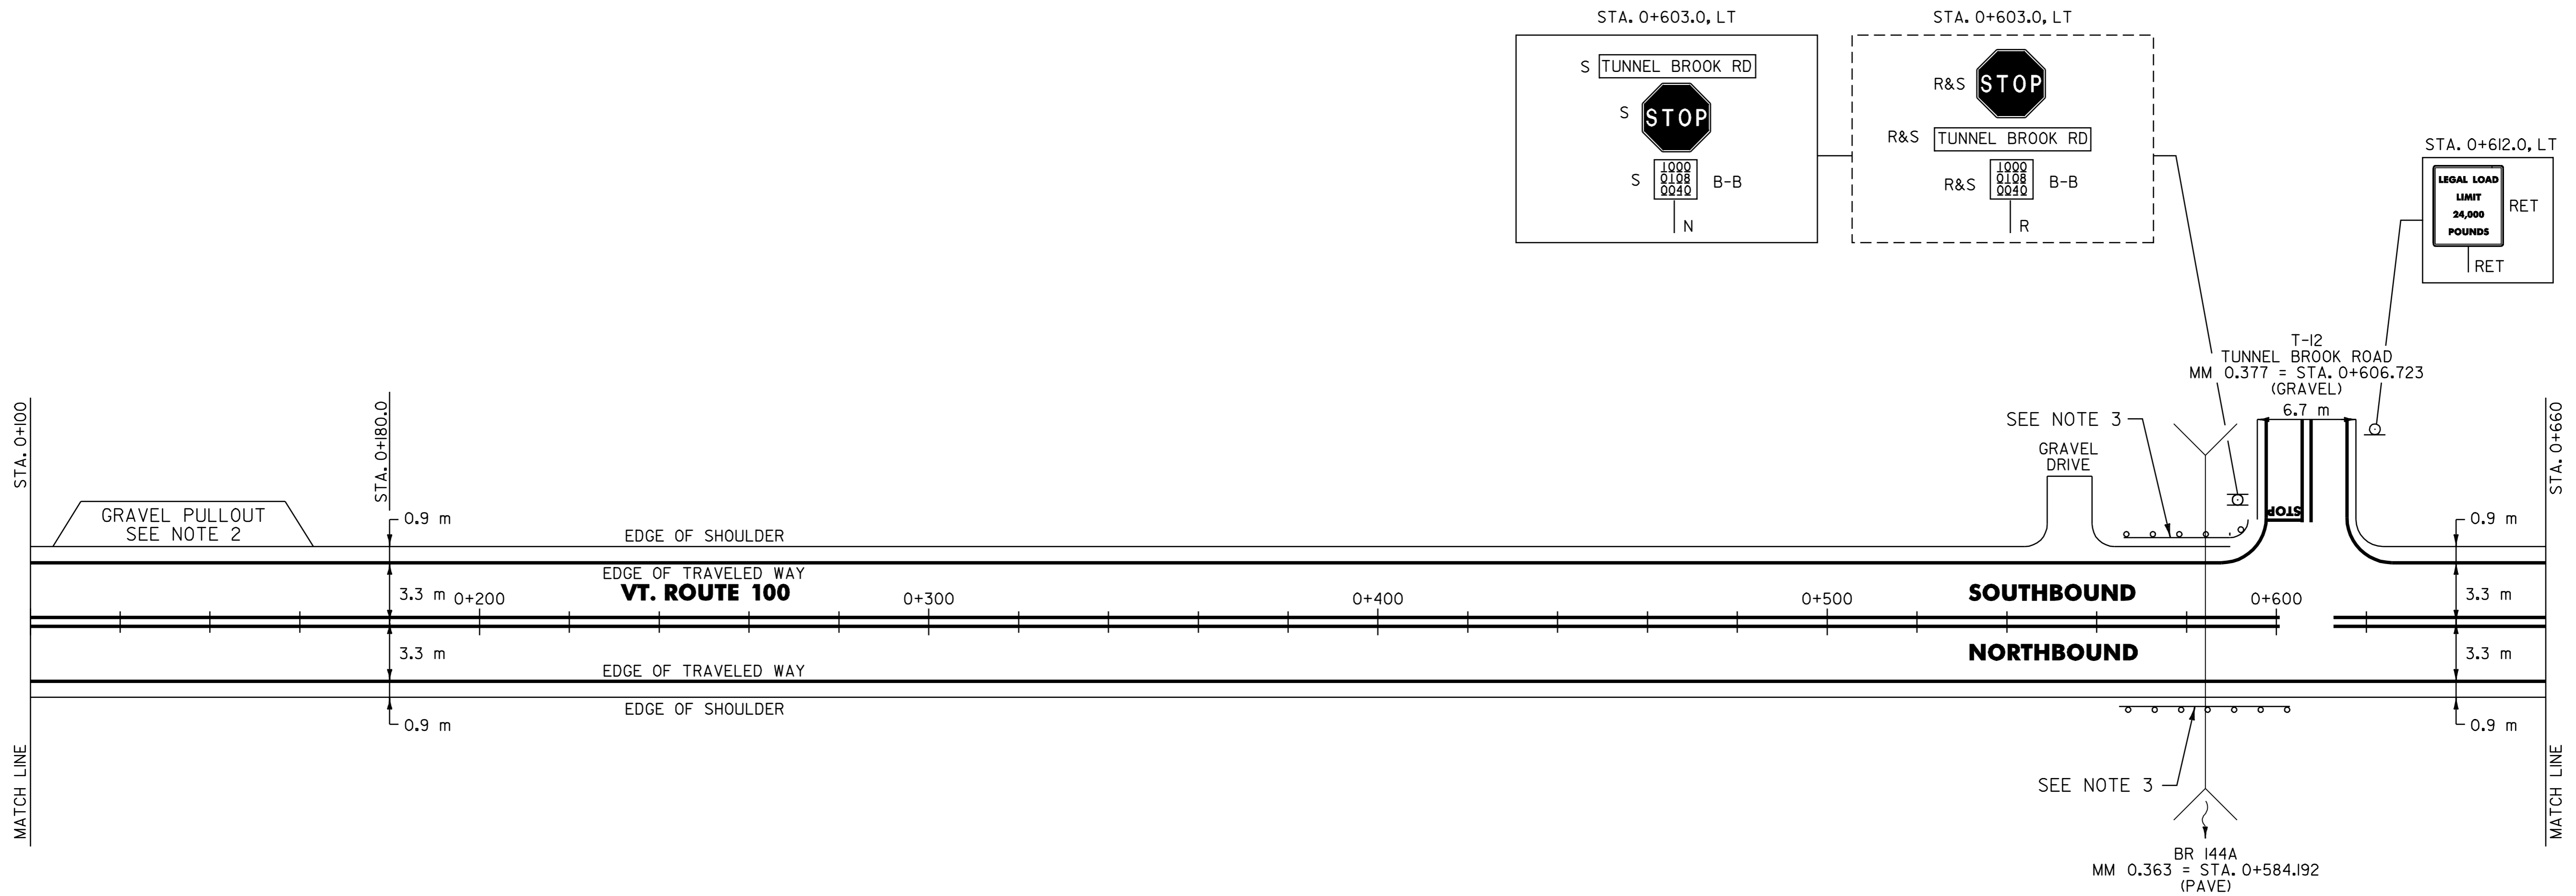

**NOTES:**

- PAVING LIMIT ON ALL TOWN HIGHWAYS SHALL BE MEASURED 8 m BACK FROM VT. ROUTE 100 EDGE OF SHOULDER UNLESS DENOTED OTHERWISE ON THE PLANS OR AS DIRECTED BY THE RESIDENT ENGINEER.
- PLACE 100 mm OF COMPACTED COLD PLANE GRINDINGS ON THE EXISTING GRAVEL PULLOUT AND PROVIDE A 35 mm TYPE IVS (75 GYRATION) APRON (1.5 m WIDE). ANY REQUIRED EXCAVATION SHALL BE PERFORMED AS DIRECTED BY THE RESIDENT ENGINEER AND PAID UNDER ITEM 608.25. PLACEMENT OF THE COLD PLANE GRINDINGS SHALL BE MADE UNDER ITEM 402.12, AGGREGATE SHOULDERS (MOD.).
- SEE SHEET 48 OF 49 FOR STEEL BEAM GUARDRAIL AT BR 144A DETAIL.

621.20 STEEL BEAM GUARDRAIL

HANCOCK:  
STA. 0+576.4 - STA. 0+591.6 RT (15.2 m)  
STA. 0+577.4 - STA. 0+597.0 LT (19.6 m)

621.505 MANUFACTURED TERMINAL SECTION (FLARED)

HANCOCK:  
STA. 0+576.4 RT  
STA. 0+577.4 LT  
STA. 0+591.6 RT

621.80 REMOVAL AND DISPOSAL OF GUARDRAIL

HANCOCK:  
STA. 0+574.0 - STA. 0+597.0 LT (23.0 m)  
STA. 0+574.0 - STA. 0+597.0 RT (23.0 m)

621.60 ANCHOR FOR STEEL BEAM RAIL

HANCOCK:  
STA. 0+594.5 LT

**SIGN LEGEND**

R= REMOVE  
S= SALVAGE  
N= NEW  
RET= RETAIN  
B-B= BACK TO BACK  
EXISTING= \_\_\_\_\_  
NEW= \_\_\_\_\_

<b>PAVING PROJECT LAYOUT</b>	SURVEYED BY <u>N/A</u> DATE <u>N/A</u>
	DRAWN BY <u>C.A.K.</u> DATE <u>11/00</u>
	SQUAD LEADER <u>T.P.K.</u>
	DESIGN FILE NO. <u>pave/98bl80/pbl80.dgn</u>
	IPARM FILE <u>pbl80p08.i</u> DATE PLOTTED <u>21-DEC-2006 15</u>
PROJ. NAME <u>ROCHESTER-GRANVILLE</u>	
PROJ. NO. <u>AC_SIP_2124(I)S</u>	
SHEET <u>16</u> OF <u>49</u> SHEETS _____	

DATUM	
VERTICAL	<u>N/A</u>
HORIZONTAL	<u>N/A</u>