

646.40 DURABLE 100 mm WHITE LINE
(ALL LINES WILL INCLUDE EDGE LINE BREAKS AND RADIUS FOR TOWN HIGHWAYS)

HANCOCK:
STA. 2+800.0 - STA. 3+340.0 LT & RT

646.60 TEMPORARY 100 mm WHITE LINE
(ALL LINES WILL INCLUDE EDGE LINE BREAKS AND RADIUS FOR TOWN HIGHWAYS)

HANCOCK:
STA. 2+800.0 - STA. 3+340.0 LT & RT

646.41 DURABLE 100 mm YELLOW LINE
(ALL LINES WILL INCLUDE C/L BREAKS FOR TOWN HIGHWAYS) S=SOLID, D=DASHED


HANCOCK:
STA. 2+800.0 - STA. 3+340.0 LT C RT
S - - S

646.61 TEMPORARY 100 mm YELLOW LINE
(ALL LINES WILL INCLUDE C/L BREAKS FOR TOWN HIGHWAYS) S=SOLID, D=DASHED

HANCOCK:
STA. 2+800.0 - STA. 3+340.0 LT C RT
S - - S

DITCHING LOCATIONS

HANCOCK:
STA. 2+800 - STA. 3+340 LT
(SEE SHEET 8 FOR DETAILS)

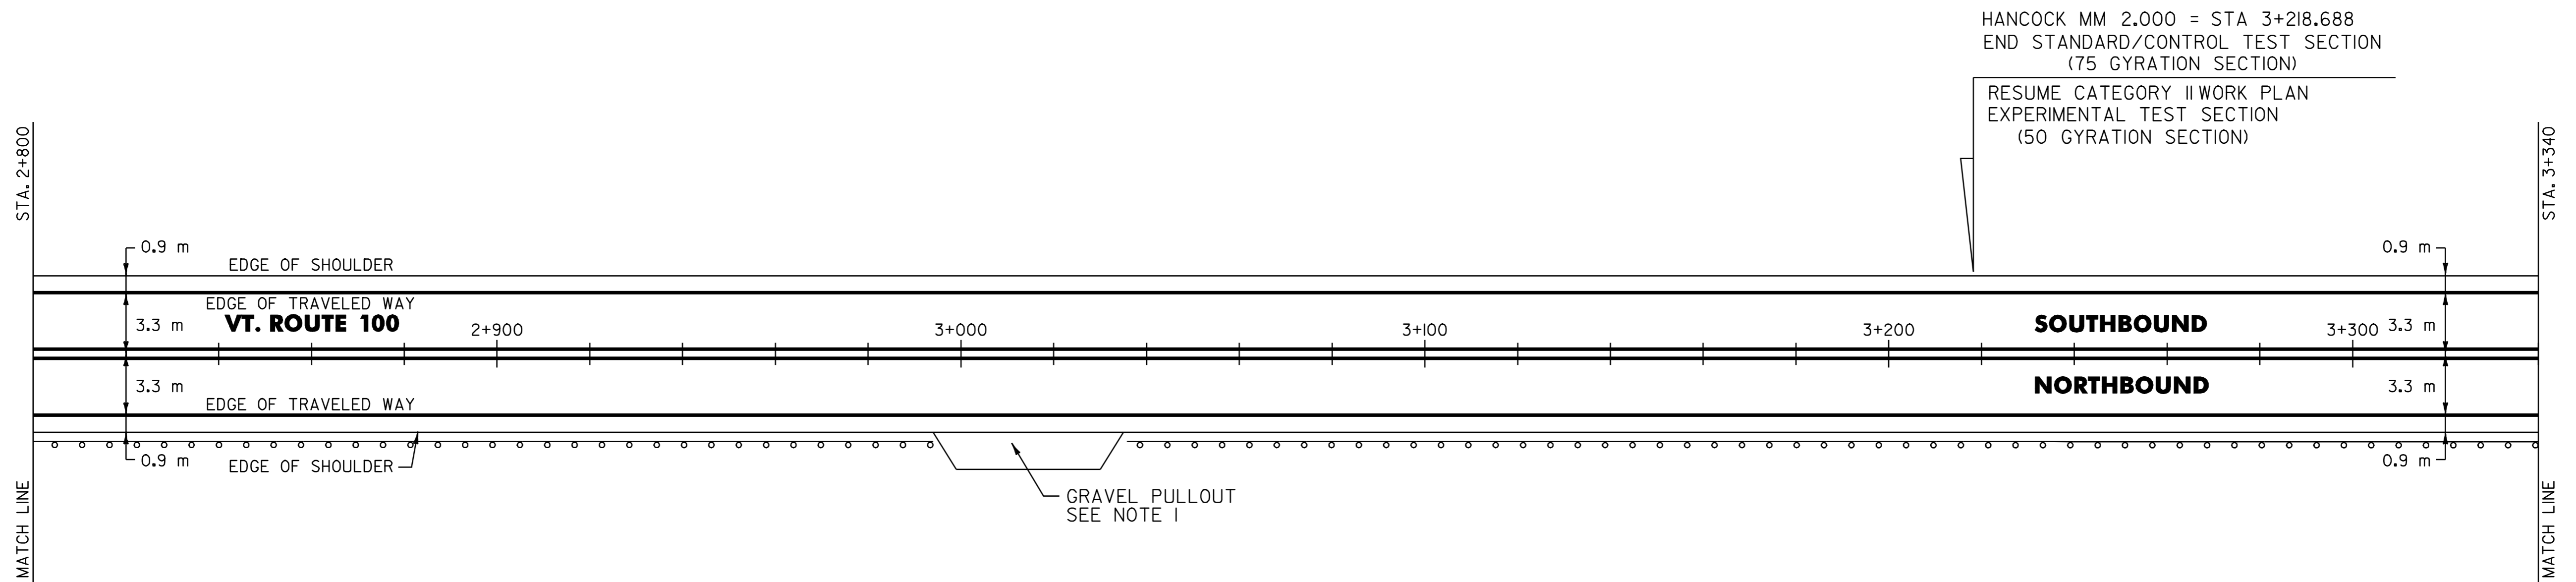

NOTE:

- PLACE 100 mm OF COMPACTED COLD PLANE GRINDINGS ON THE EXISTING GRAVEL PULLOUT AND PROVIDE A 35 mm TYPE IVS (75 GYRATION) APRON 1.5 m WIDE. ANY REQUIRED EXCAVATION SHALL BE PERFORMED AS DIRECTED BY THE RESIDENT ENGINEER AND PAID UNDER ITEM 608.25. PLACEMENT OF THE COLD PLANE GRINDINGS SHALL BE MADE UNDER ITEM 402.12, AGGREGATE SHOULDERS (MOD.)

621.20 STEEL BEAM GUARDRAIL W/2.4 m POSTS (MOD.)

HANCOCK: STA. 2+977.16 RT (177.16 m)
STA. 2+800.0 - ~~STA. 2+982.6 RT (182.6 m)~~
STA. 3+038.4 - ~~STA. 3+331.0 RT (292.6 m)~~
STA. 2+327.96 RT (289.56 m)

621.505 MANUFACTURED TERMINAL SECTION (FLARED)

HANCOCK:
STA. 2+982.6 RT
STA. 3+038.4 RT
STA. 3+331.0 RT

621.80 REMOVAL AND DISPOSAL OF GUARDRAIL

HANCOCK:
STA. 2+800.0 - STA. 2+994.0 RT (194.0 m)
STA. 3+027.0 - STA. 3+340.0 RT (313.0 m)

DATUM	
VERTICAL	N/A
HORIZONTAL	N/A

PAVING PROJECT LAYOUT	SURVEYED BY	N/A	DATE	N/A
	DRAWN BY	C.A.K.	DATE	11/00
	SQUAD LEADER	T.P.K.		
	DESIGN FILE NO.	pave/98bl80/pbl80.dgn		
	IPARM FILE	pbl80pl3.i	DATE PLOTTED	21-DEC-2006
PROJ. NAME	ROCHESTER-GRANVILLE			
PROJ. NO.	AC_SIP_2124(I)S			
SHEET	21	OF	49	SHEETS