


646.40 DURABLE 100 mm WHITE LINE
 (ALL LINES WILL INCLUDE EDGE LINE BREAKS AND RADIUS FOR TOWN HIGHWAYS)
 GRANVILLE:
 STA. 0+360.0 - STA. 0+900.0 LT & RT

646.41 DURABLE 100 mm YELLOW LINE
 (ALL LINES WILL INCLUDE C/L BREAKS FOR TOWN HIGHWAYS) S=SOLID, D=DASHED
 GRANVILLE:
 STA. 0+360.0 - STA. 0+900.0 LT S RT S

646.60 TEMPORARY 100 mm WHITE LINE
 (ALL LINES WILL INCLUDE EDGE LINE BREAKS AND RADIUS FOR TOWN HIGHWAYS)
 GRANVILLE:
 STA. 0+360.0 - STA. 0+900.0 LT & RT

646.61 TEMPORARY 100 mm YELLOW LINE
 (ALL LINES WILL INCLUDE C/L BREAKS FOR TOWN HIGHWAYS) S=SOLID, D=DASHED
 GRANVILLE:
 STA. 0+360.0 - STA. 0+900.0 LT S RT S

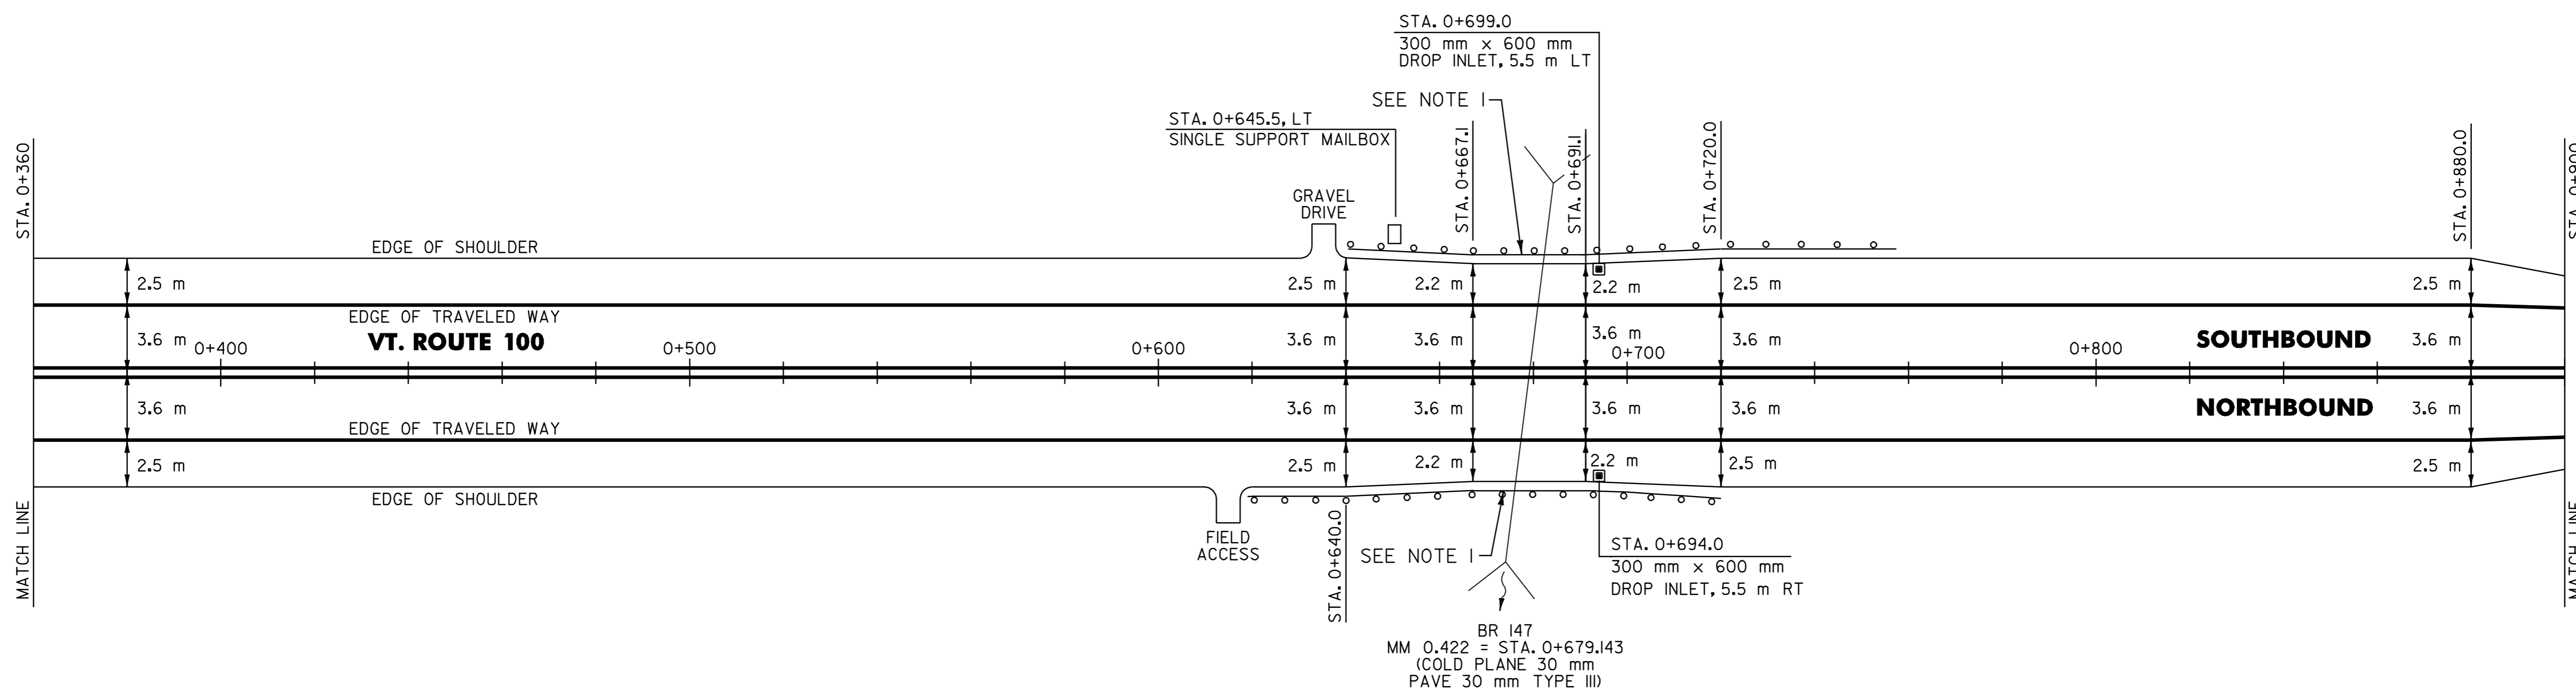

604.412 REHABING DI, CB OR MH, CLASS J

GRANVILLE:
 STA. 0+694.0 RT
 STA. 0+699.0 LT

616.35 TREATED TIMBER CURB

GRANVILLE:
 STA. 0+692.0 - STA. 0+697.0 RT (5.0 m)
 STA. 0+697.0 - STA. 0+702.0 LT (5.0 m)

617.10 RELOCATE MAILBOX, SINGLE SUPPORT

GRANVILLE:
 STA. 0+645.5 LT

621.20 STEEL BEAM GUARDRAIL

GRANVILLE:
~~STA. 0+631.4 - STA. 0+646.6 RT (15.2 m)~~
~~STA. 0+651.6 - STA. 0+663.0 LT (11.4 m)~~
 STA. 0+696.0 - STA. 0+707.4 RT (11.4 m)
 STA. 0+712.4 - STA. 0+742.8 LT (30.4 m)
 STA. 0+655.38 - STA. 0+663 LT (7.62 m)
 STA. 0+631.4 - STA. 0+646.6 RT (7.62 m)

621.505 MANUFACTURED TERMINAL SECTION (FLARED)

GRANVILLE:
 STA. 0+631.4 RT
 STA. 0+651.6 LT
 STA. 0+707.4 RT
 STA. 0+742.8 LT

621.70 GUARDRAIL APPROACH SECTION, TYPE J

GRANVILLE:
 STA. 0+646.6 - STA. 0+661.8 RT (1EA)
 STA. 0+697.2 - STA. 0+712.4 LT (1EA)

621.71 GUARDRAIL APPROACH SECTION, TYPE II

GRANVILLE:
 STA. 0+663.0 - STA. 0+666.8 LT (1EA)
 STA. 0+692.2 - STA. 0+696.0 RT (1EA)

621.80 REMOVAL AND DISPOSAL OF GUARDRAIL

GRANVILLE:
 STA. 0+620.0 - STA. 0+661.8 RT (41.8 m)
 STA. 0+640.0 - STA. 0+666.8 LT (26.8 m)
 STA. 0+692.2 - STA. 0+719.0 RT (26.8 m)
 STA. 0+697.2 - STA. 0+741.0 LT (43.8 m)

NOTE:

1. SEE SHEET 39 OF 49 FOR BR 147 DETAILS. SEE SHEET 45 OF 49 & 46 OF 49 FOR BRIDGE APPROACH SECTION DETAILS.

DATUM	
VERTICAL	N/A
HORIZONTAL	N/A

PAVING PROJECT LAYOUT	SURVEYED BY	N/A	DATE	N/A
	DRAWN BY	C.A.K.	DATE	11/00
	SQUAD LEADER	T.P.K.		
	DESIGN FILE NO.	/pave/98bl80/pbl80.dgn		
	IPARM FILE	pbl80p16.i	DATE PLOTTED	21-DEC-2006
PROJ. NAME	ROCHESTER-GRANVILLE			
PROJ. NO.	AC_SIP_2124(1)S			
SHEET	24	OF	49	SHEETS