

646.40 DURABLE 100 mm WHITE LINE
(ALL LINES WILL INCLUDE EDGE LINE BREAKS AND RADIUS FOR TOWN HIGHWAYS)

GRANVILLE:
STA. 2+520.0 - STA. 3+060.0 LT & RT

646.60 TEMPORARY 100 mm WHITE LINE
(ALL LINES WILL INCLUDE EDGE LINE BREAKS AND RADIUS FOR TOWN HIGHWAYS)

GRANVILLE:
STA. 2+520.0 - STA. 3+060.0 LT & RT

646.41 DURABLE 100 mm YELLOW LINE
(ALL LINES WILL INCLUDE C/L BREAKS FOR TOWN HIGHWAYS) S=SOLID, D=DASHED

GRANVILLE:
STA. 2+520.0 - STA. 3+060.0 LT S - RT S

646.61 TEMPORARY 100 mm YELLOW LINE
(ALL LINES WILL INCLUDE C/L BREAKS FOR TOWN HIGHWAYS) S=SOLID, D=DASHED


GRANVILLE:
STA. 2+520.0 - STA. 3+060.0 LT S - RT S

646.50 DURABLE LETTER OR SYMBOL

GRANVILLE:
STA. 2+935.0 LT, "S,C,H,O,O,L" (6 EA)

646.70 TEMPORARY LETTER OR SYMBOL

GRANVILLE:
STA. 2+935.0 LT, "S,C,H,O,O,L" (6 EA)

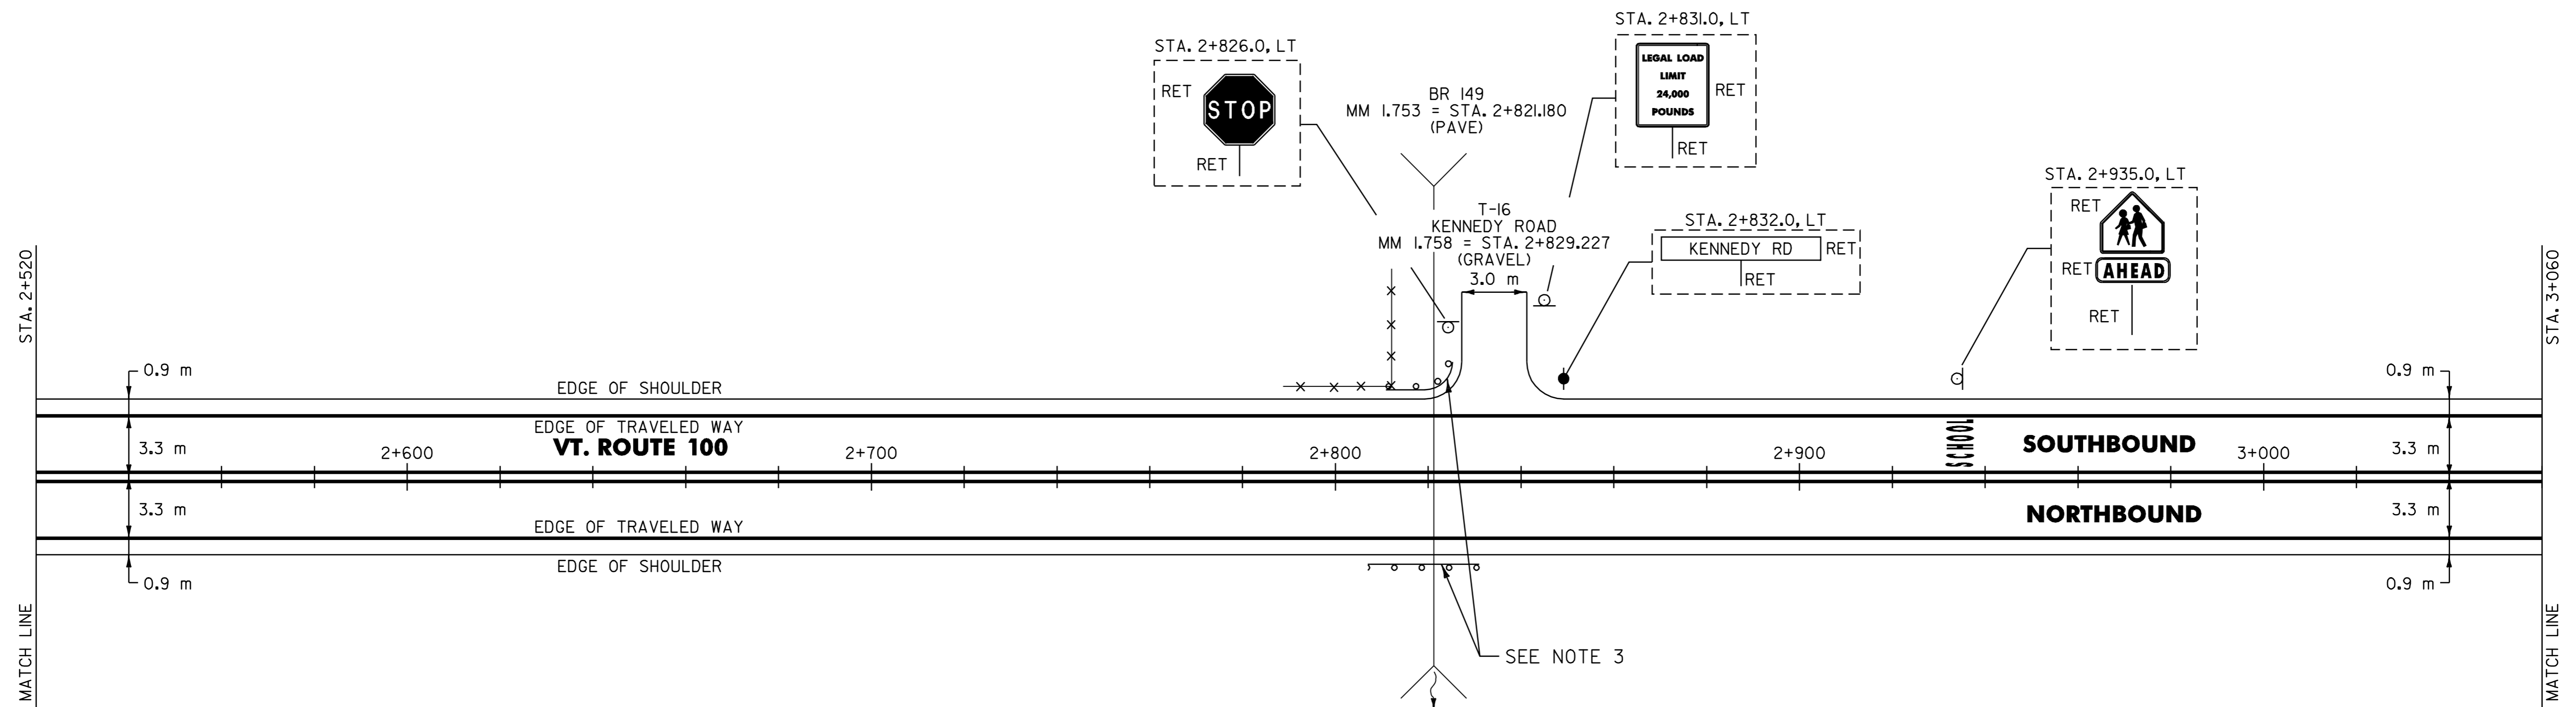

525.10 REMOVAL OF EXISTING RAILING

GRANVILLE:
STA. 2+819.1 - STA. 2+822.9 LT (3.8 m)
STA. 2+819.1 - STA. 2+822.9 RT (3.8 m)

525.41 BRIDGE RAIL - H.D. STEEL BEAM/FASCIA MOUNTED (MOD. 2)

GRANVILLE:
STA. 2+819.1 - STA. 2+822.9 LT (3.8 m)
STA. 2+819.1 - STA. 2+822.9 RT (3.8 m)

620.50 REMOVING AND RESETTING FENCE

GRANVILLE:
~~STA. 2+813.7 - STA. 2+814.7 LT (10.0 m)~~

621.21 HEAVY DUTY STEEL BEAM GUARDRAIL

GRANVILLE:
STA. 2+814.7 - STA. 2+819.1 LT (4.4 m)
STA. 2+822.9 - STA. 2+827.3 LT (4.4 m)
STA. 2+822.9 - STA. 2+831.1 RT (8.2 m)

621.505 MANUFACTURED TERMINAL SECTION (FLARED)

GRANVILLE:
STA. 2+819.1 RT

621.60 ANCHOR FOR STEEL BEAM RAIL

GRANVILLE:
STA. 2+817.2 LT
STA. 2+824.8 LT
STA. 2+828.6 RT

621.80 REMOVAL AND DISPOSAL OF GUARDRAIL

GRANVILLE:
STA. 2+810.0 - STA. 2+819.1 RT (9.1 m)
STA. 2+814.7 - STA. 2+819.1 LT (4.4 m)
STA. 2+822.9 - STA. 2+827.3 LT (4.4 m)
STA. 2+822.9 - STA. 2+832.0 RT (9.1 m)

NOTES:

- PAVING LIMIT ON ALL TOWN HIGHWAYS SHALL BE MEASURED 8 m BACK FROM VT. ROUTE 100 EDGE OF SHOULDER UNLESS DENOTED OTHERWISE ON THE PLANS OR AS DIRECTED BY THE RESIDENT ENGINEER.
- NO OPENING IN THE CENTERLINE OR EDGE LINE MARKINGS WILL BE PROVIDED FOR T-16 BECAUSE IT IS A CLASS IV TOWN HIGHWAY.
- SEE SHEETS 36 OF 49 & 41 OF 49 FOR BR 149 DETAILS.

SIGN LEGEND

R= REMOVE
S= SALVAGE
N= NEW
RET= RETAIN
B-B= BACK TO BACK
EXISTING= _____
NEW= _____

PAVING PROJECT LAYOUT

SURVEYED BY N/A DATE N/A
DRAWN BY C.A.K. DATE 11/00
SQUAD LEADER T.P.K.
DESIGN FILE NO. /pave/98b180/pbl80.dgn
IPARM FILE pbl80p20.i DATE PLOTTED 21-DEC-2006 15
PROJ. NAME ROCHESTER-GRANVILLE
PROJ. NO. AC_SIP_212411S
SHEET 28 OF 49 SHEETS _____

DATUM
VERTICAL N/A
HORIZONTAL N/A