


BR 145 HANCOCK MM 1.194 = STA. 1+921.557

NOT TO SCALE

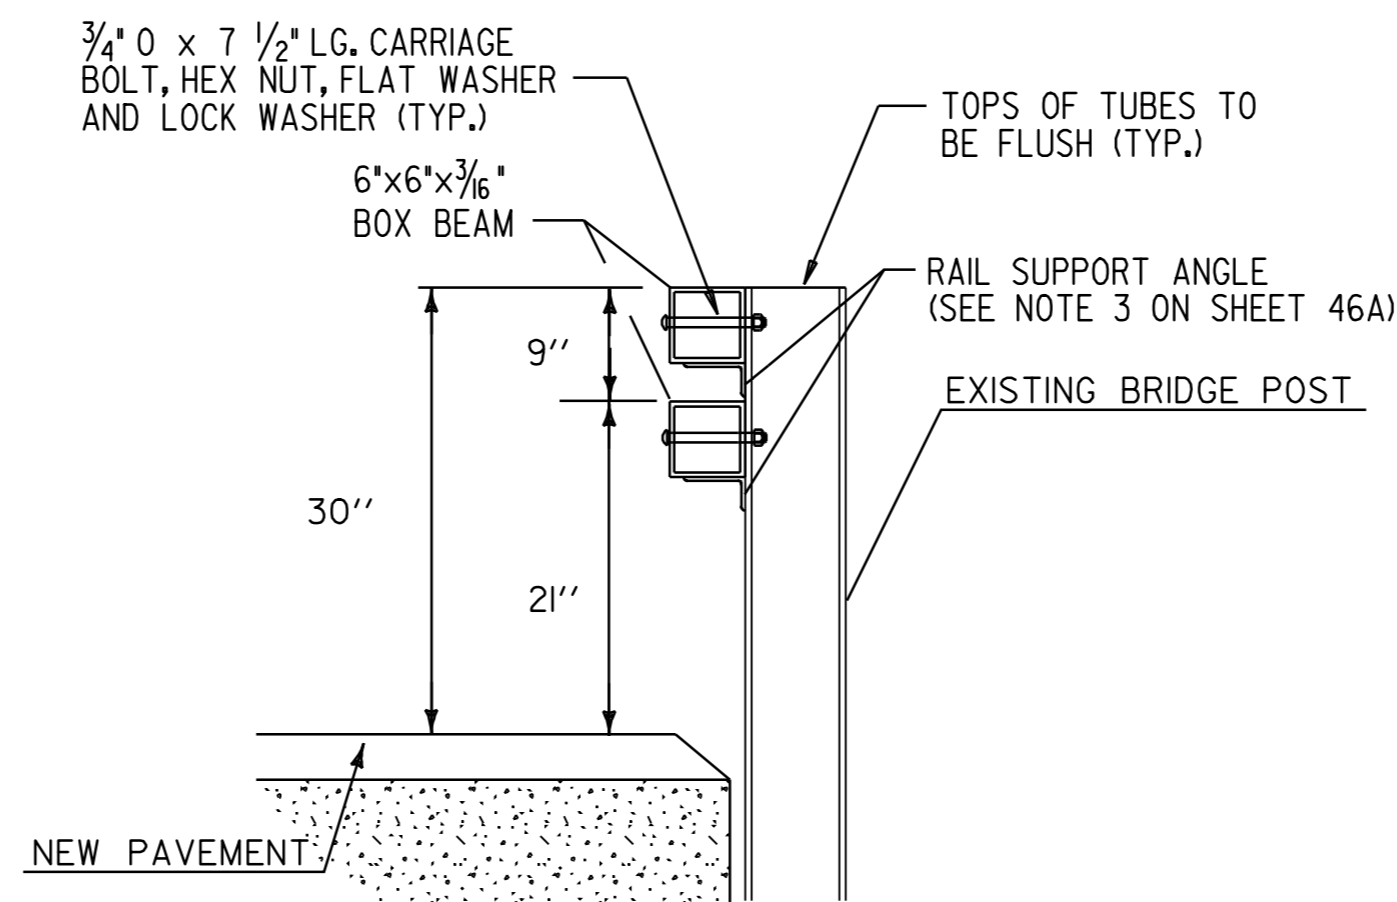

NOTES

ALL BOX BEAM DETAIL DIMENSIONS ARE IN ENGLISH UNITS. THE FINAL QUANTITIES HAVE BEEN CONVERTED TO METRIC FOR PAYMENT.

BOX BEAM DETAILS FOR BRIDGE 145 APPEAR ON SHEET 46A.

THE BOX BEAM RAIL AND LOWER RUB RAIL ALONG THE EDGE OF VT. ROUTE 125 SHALL BE SHOP BENT TO THE INDICATED RADIUS. THIS RADIUS SHALL BE CONFIRMED BY THE CONTRACTOR PRIOR

DATUM	
VERTICAL	N/A
HORIZONTAL	N/A

BRIDGE DETAIL SHEET 3	
SURVEYED BY	N/A DATE N/A
DRAWN BY	C.A.K. DATE 11/00
SQUAD LEADER	T.P.K.
DESIGN FILE NO.	pave/98b180/pbl80.dgn
IPARM FILE	pbl80b03.i DATE PLOTTED 21-DEC-2006 15:53
PROJ. NAME	ROCHESTER-GRANVILLE
PROJ. NO.	AC_SIP_212411S
SHEET	38 OF 49 SHEETS