


BR 148 GRANVILLE MM 0.961 = STA. 1+546.580
NOT TO SCALE

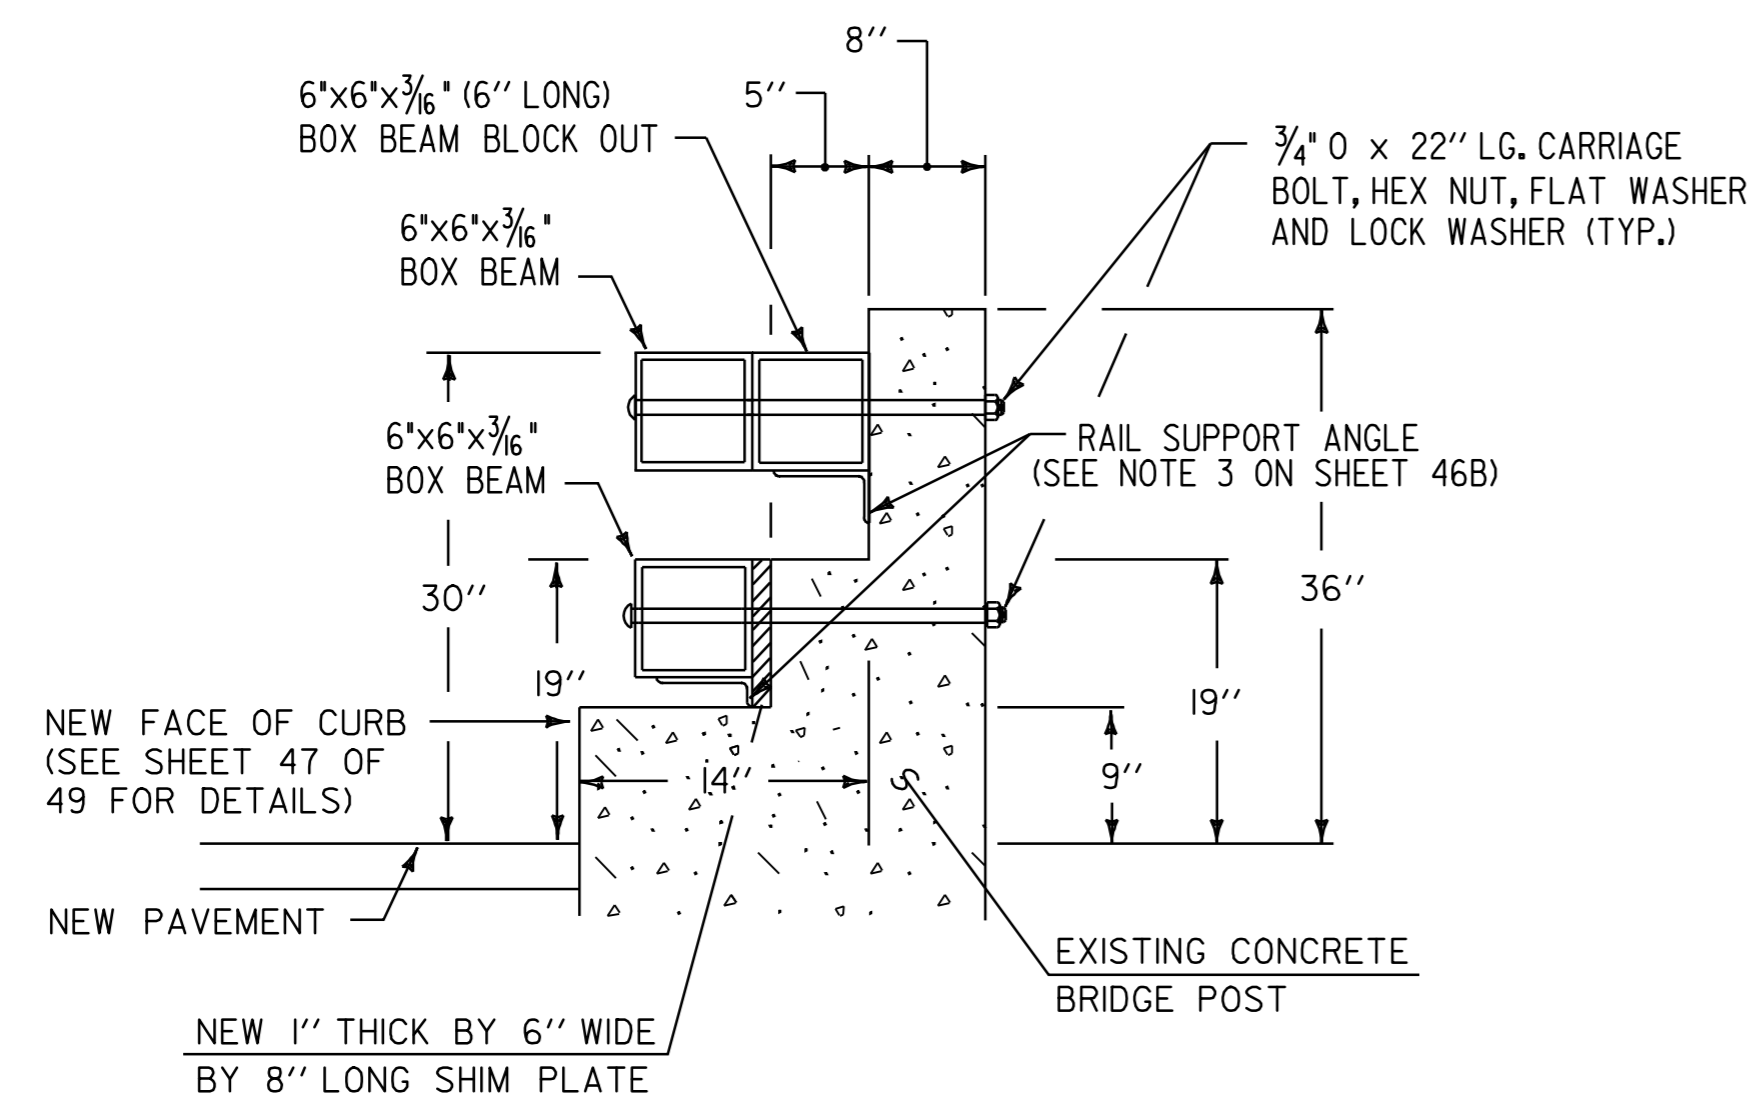

BR 148 BRIDGE POST DETAIL
NOT TO SCALE

NOTES

ALL BOX BEAM DETAIL DIMENSIONS ARE IN ENGLISH UNITS. THE FINAL QUANTITIES HAVE BEEN CONVERTED TO METRIC FOR PAYMENT.

BOX BEAM DETAILS FOR BRIDGE 148 APPEAR ON SHEET 46B.

<p>BRIDGE</p> <p>DETAIL</p> <p>SHEET 5</p>	SURVEYED BY <u>N/A</u> DATE <u>N/A</u>
	DRAWN BY <u>C.A.K.</u> DATE <u>11/00</u>
	SQUAD LEADER <u>T.P.K.</u>
	DESIGN FILE NO. <u>/pave/98b180/pb180.dgn</u>
	IPARM FILE <u>pb180b05.i</u> DATE PLOTTED <u>21-DEC-2006 15:54</u>
PROJ. NAME <u>ROCHESTER-GRANVILLE</u>	
PROJ. NO. <u>AC_STP_2124(1)S</u>	
SHEET <u>40</u> OF <u>49</u> SHEETS	