
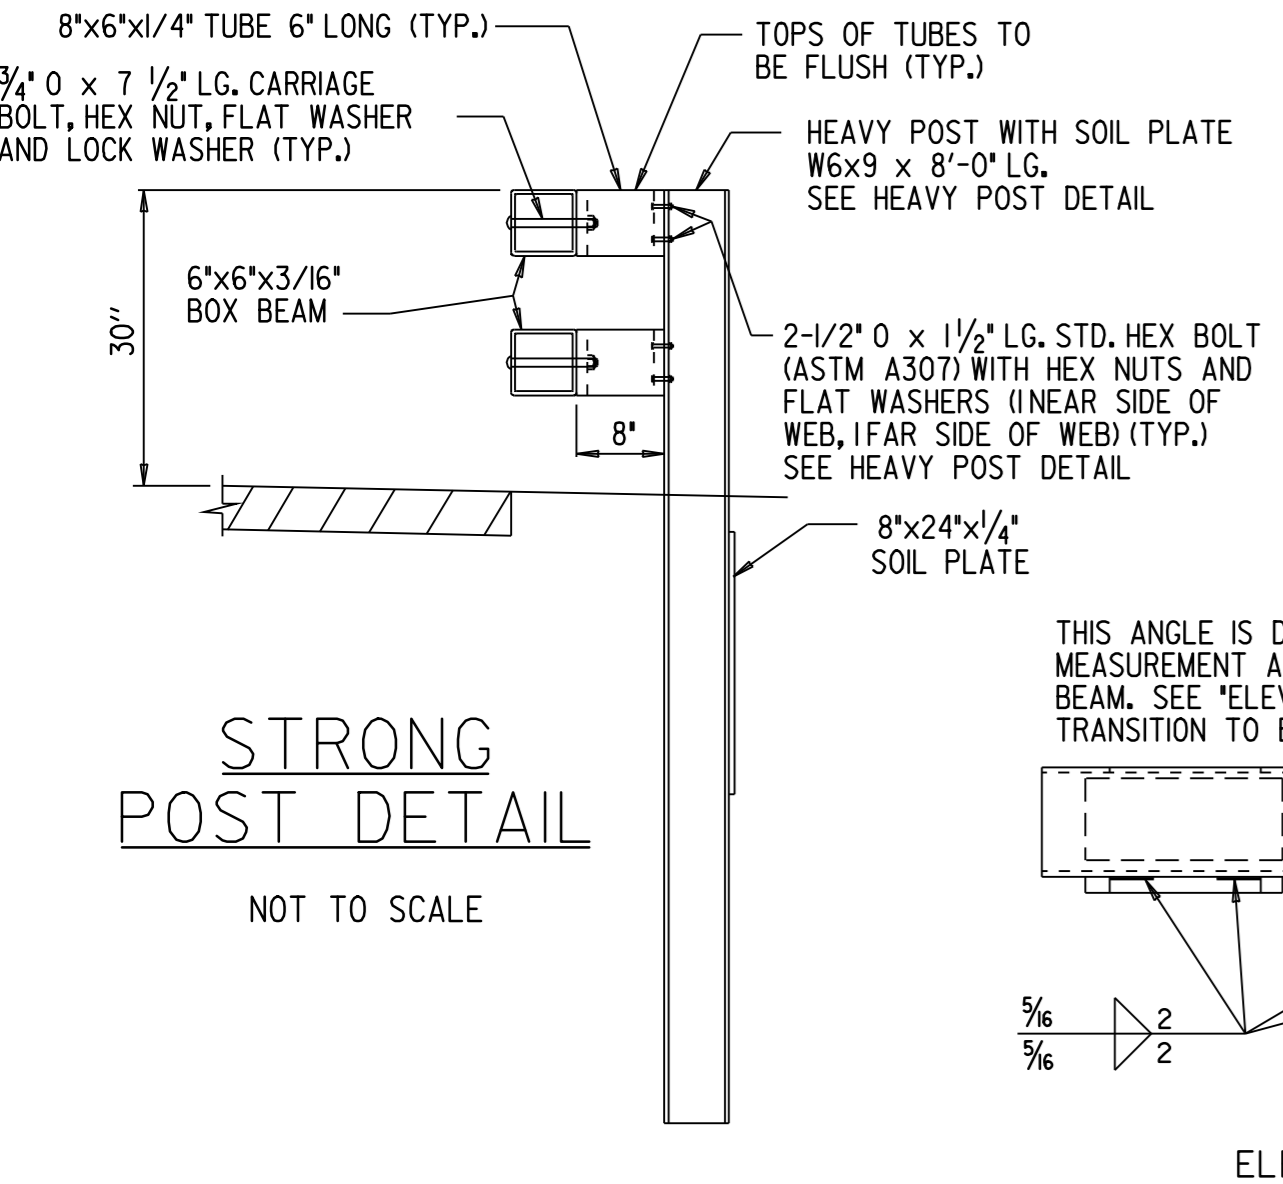






**DETAIL FOR ATTACHING BOX BEAM GUARD RAIL TO EXISTING CONCRETE POSTS BRIDGE 148**

NOT TO SCALE

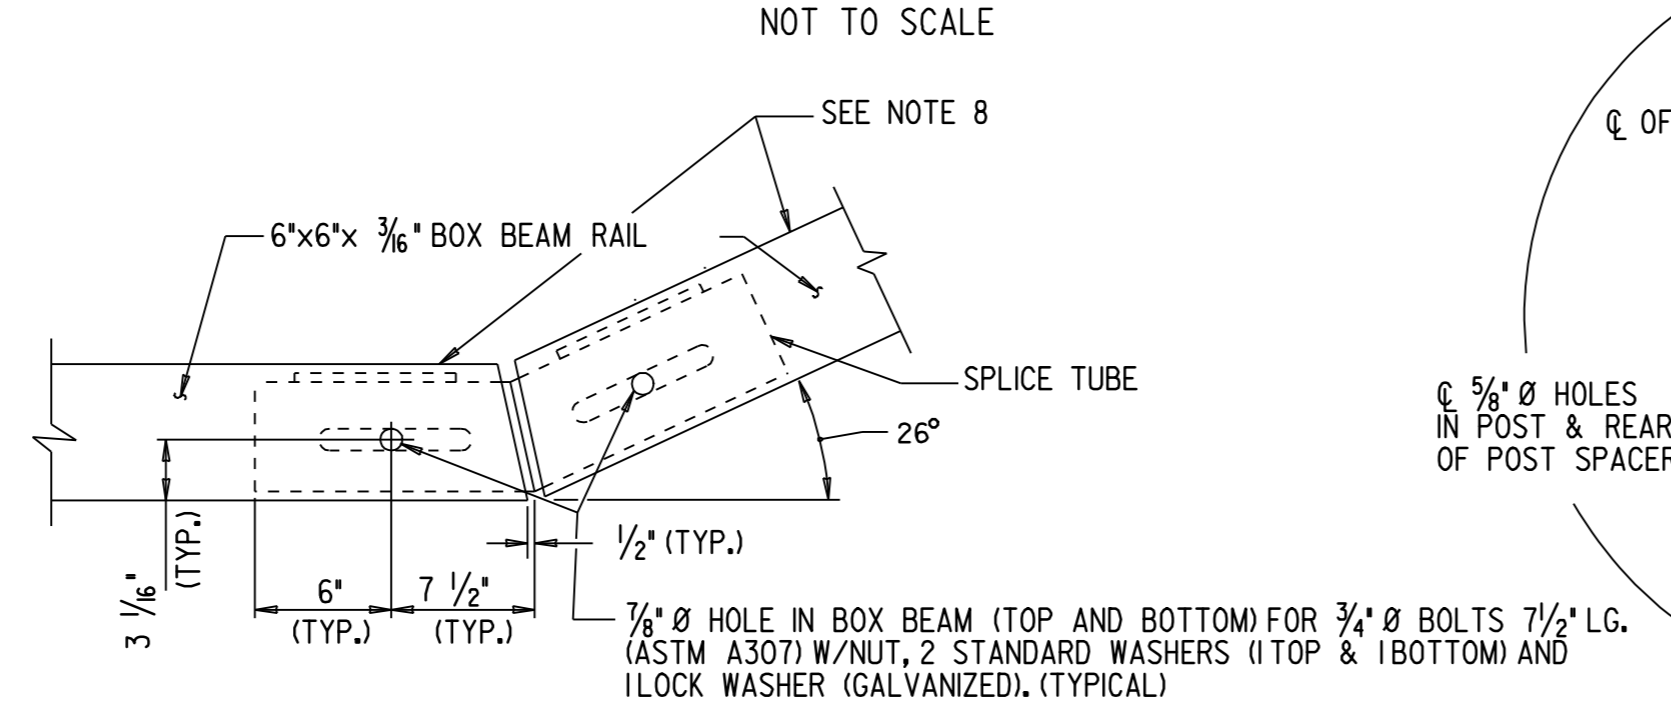

**WELD DETAIL FOR SPLICE TUBE**

NOT TO SCALE

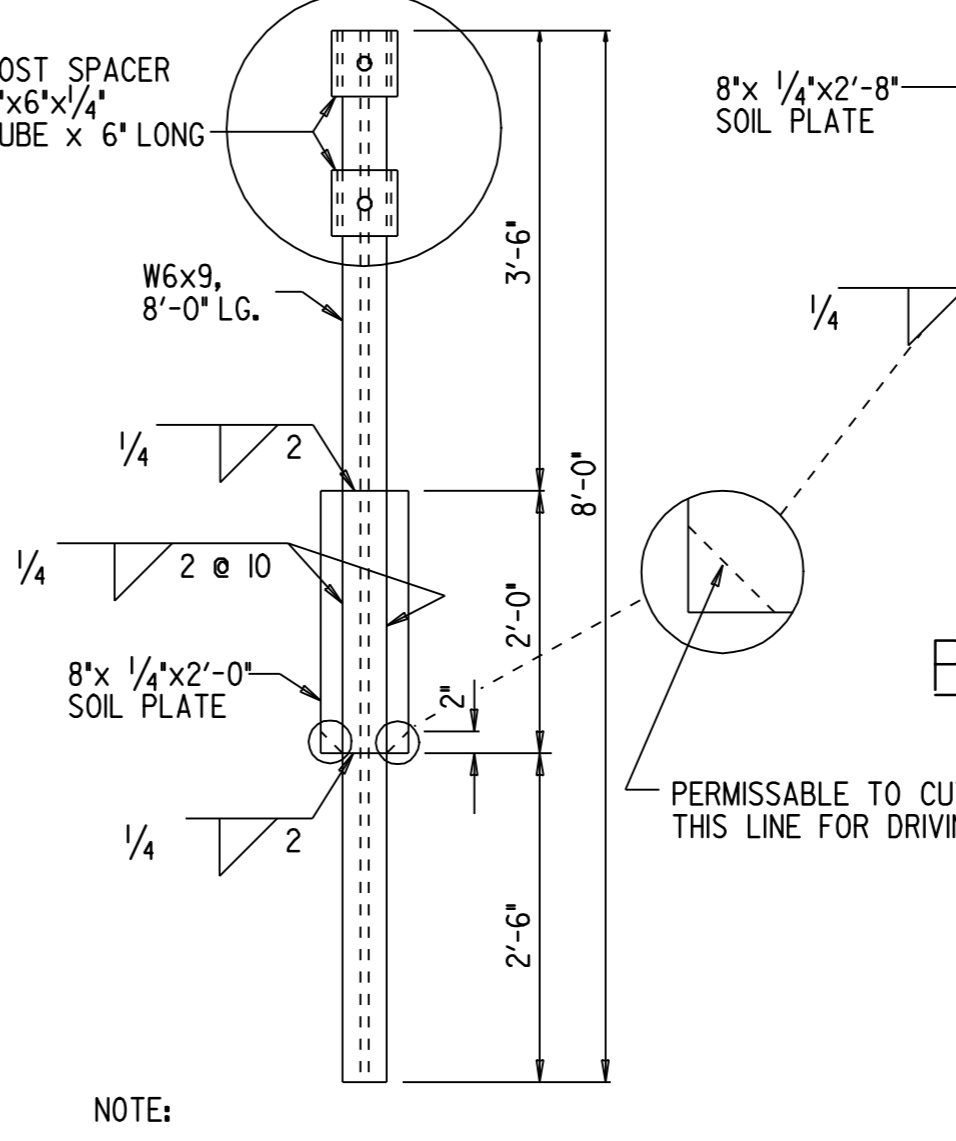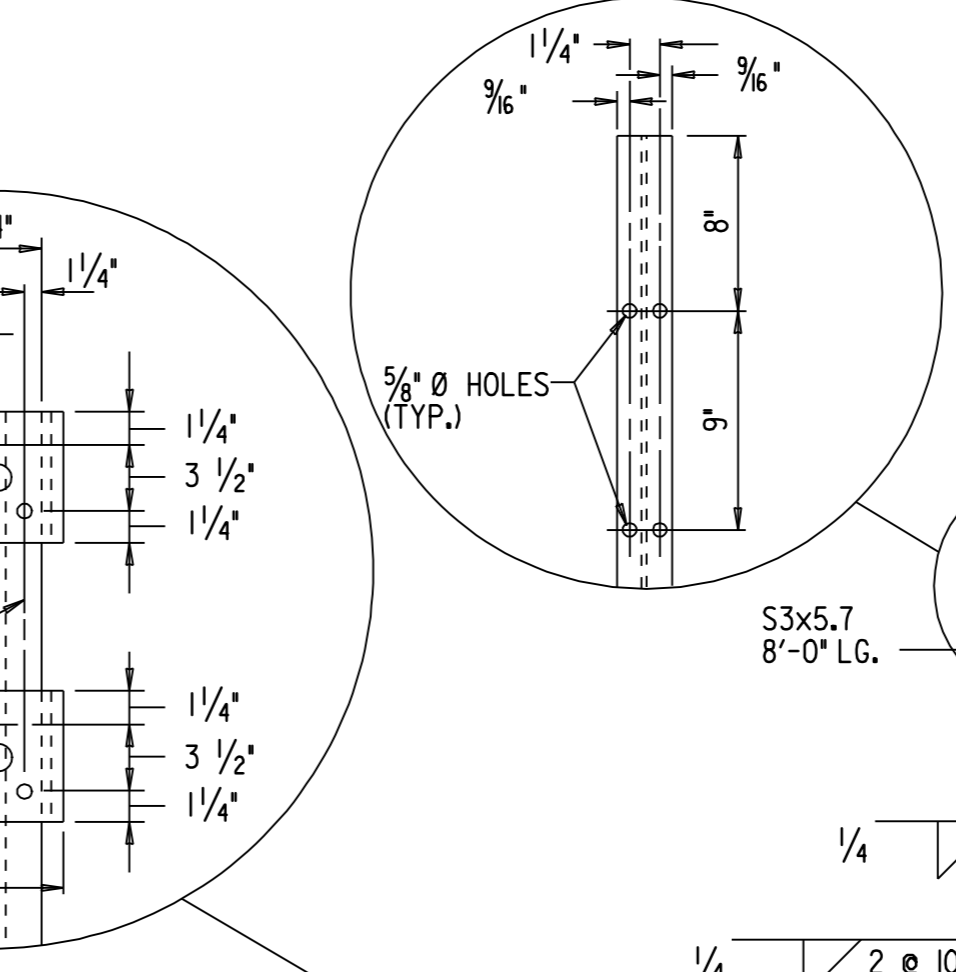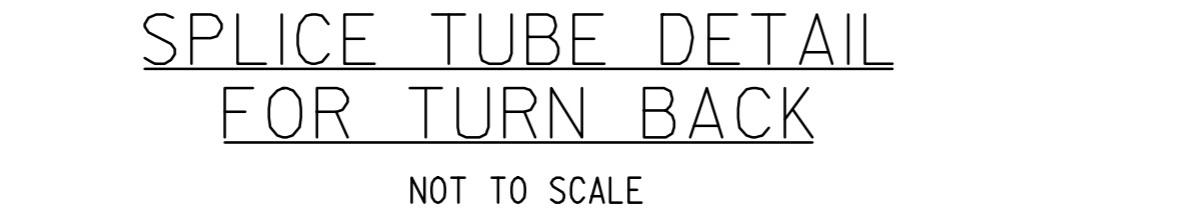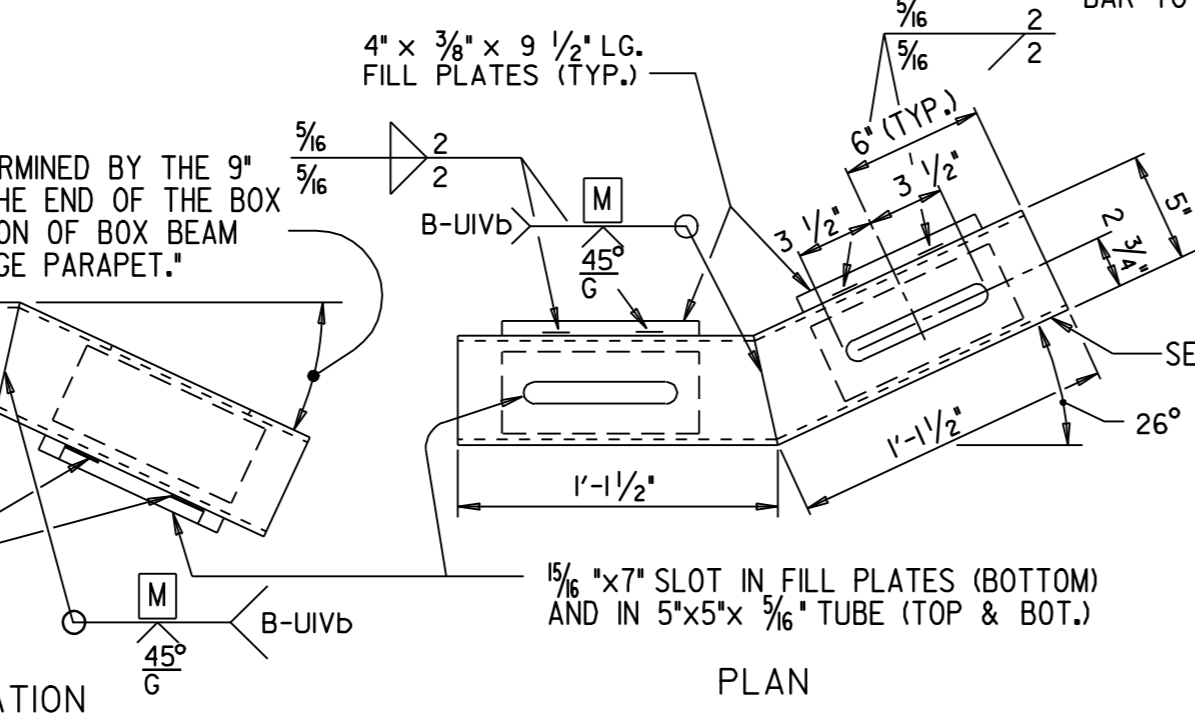

- NOTES:
- ALL BOX BEAM DETAIL DIMENSIONS ARE IN ENGLISH UNITS. THE FINAL QUANTITIES HAVE BEEN CONVERTED TO METRIC FOR PAYMENT.
  - ALL BOX BEAM COMPONENTS, INCLUDING POSTS AND HARDWARE, SHALL CONFORM TO THE CURRENT SPECIFICATION FOR BOX BEAM GUARD RAIL. REFER TO STANDARD G-IBM FOR DETAILS. ALL BOX BEAM COMPONENTS, INCLUDING POSTS AND HARDWARE, SHALL BE GALVANIZED.
  - FOR DETAILS OF STANDARD POST, EXTRA LONG POST, RAIL ELEMENT, RAIL SUPPORT ANGLE, SPLICE CONNECTIONS, END COVER PLATE, TYPE II END ASSEMBLY AND DELINEATION DEVICE, SEE THE VARIOUS STANDARD SHEET G-IBM, "BOX BEAM GUARD RAIL."
  - IN LOCATIONS OF STANDARD BOX BEAM PLACEMENT (SUCH AS RAIL CONTINUING BEYOND THE END OF RUB RAIL), EXTRA LONG POSTS SHALL BE USED IF THE TOP OF EMBANKMENT IS LESS THAN ONE METER (3') BEHIND THE FACE OF RAIL. REFER TO STANDARD G-IBM FOR DETAILS OF EXTRA LONG POSTS.
  - THIS PLAN VIEW SHOWS TANGENT RAIL ELEMENTS, HOWEVER, THE RAIL ELEMENTS MAY BE SHOP FORMED TO AN INDICATED RADIUS (SEE SHEETS 38 AND 44 OF 49). THE RADII PROPOSED ON THOSE SHEETS SHALL BE VERIFIED BY THE CONTRACTOR PRIOR TO FABRICATION.
  - THE COST OF ALL EQUIPMENT, LABOR, AND MATERIALS NECESSARY TO COMPLETE THE WORK SHOWN FOR THESE DETAILS SHALL BE INCIDENTAL TO THE ITEM 621.30, BOX BEAM GUARD RAIL (MOD. 1, 2 OR 3). THE LENGTH OF THE LOWER BOX BEAM GUARD RAIL (RUB RAIL), INCLUDING ALL TURN BACK MATERIALS, SHALL NOT BE PAID SEPARATELY, BUT SHALL BE INCIDENTAL TO ITEM 621.30, BOX BEAM GUARD RAIL (MOD. 1, 2 OR 3).
  - BOX BEAM BRIDGE RAIL HEIGHT (30") SHALL TRANSITION TO THE NORMAL ROADWAY HEIGHT OF 27" AT THE POINT WHERE THE LOWER RUB RAIL TURNS BACK UNDER THE UPPER BOX BEAM RAIL.
  - PROTRUSIONS CAUSED BY WELDING ARE NOT PERMITTED ON THE INSIDE WALLS OF THE SPLICE TUBE.
  - PROTRUSIONS CAUSED BY WELDING ARE NOT PERMITTED ON THE OUTSIDE WALLS OF THE SPLICE TUBE OR THE OUTSIDE SURFACES OF THE FILL PLATE.

**BRIDGE 148 BOX BEAM GUARD RAIL DETAIL SHEET**

SURVEYED BY N/A DATE \_\_\_\_\_

DRAWN BY C.A.K. DATE 11/00

SQUAD LEADER T.P.K.

DESIGN FILE NO. \_\_\_\_\_

IPARM FILE: pb180box2.i DATE PLOTTED 21-DEC-2006 15

PROJ. NAME ROCHESTER-GRANVILLE

PROJ. NO. AC\_SIP\_212411S

SHEET 46B OF 49