


VT. ROUTE 100
MM 6.069 = STA. 9+767.109
BEGIN PROJECT AC STP 2124(I)S

VT. ROUTE 100
MM 2.929 = STA. 4+713.769
END PROJECT AC STP 2124(I)S

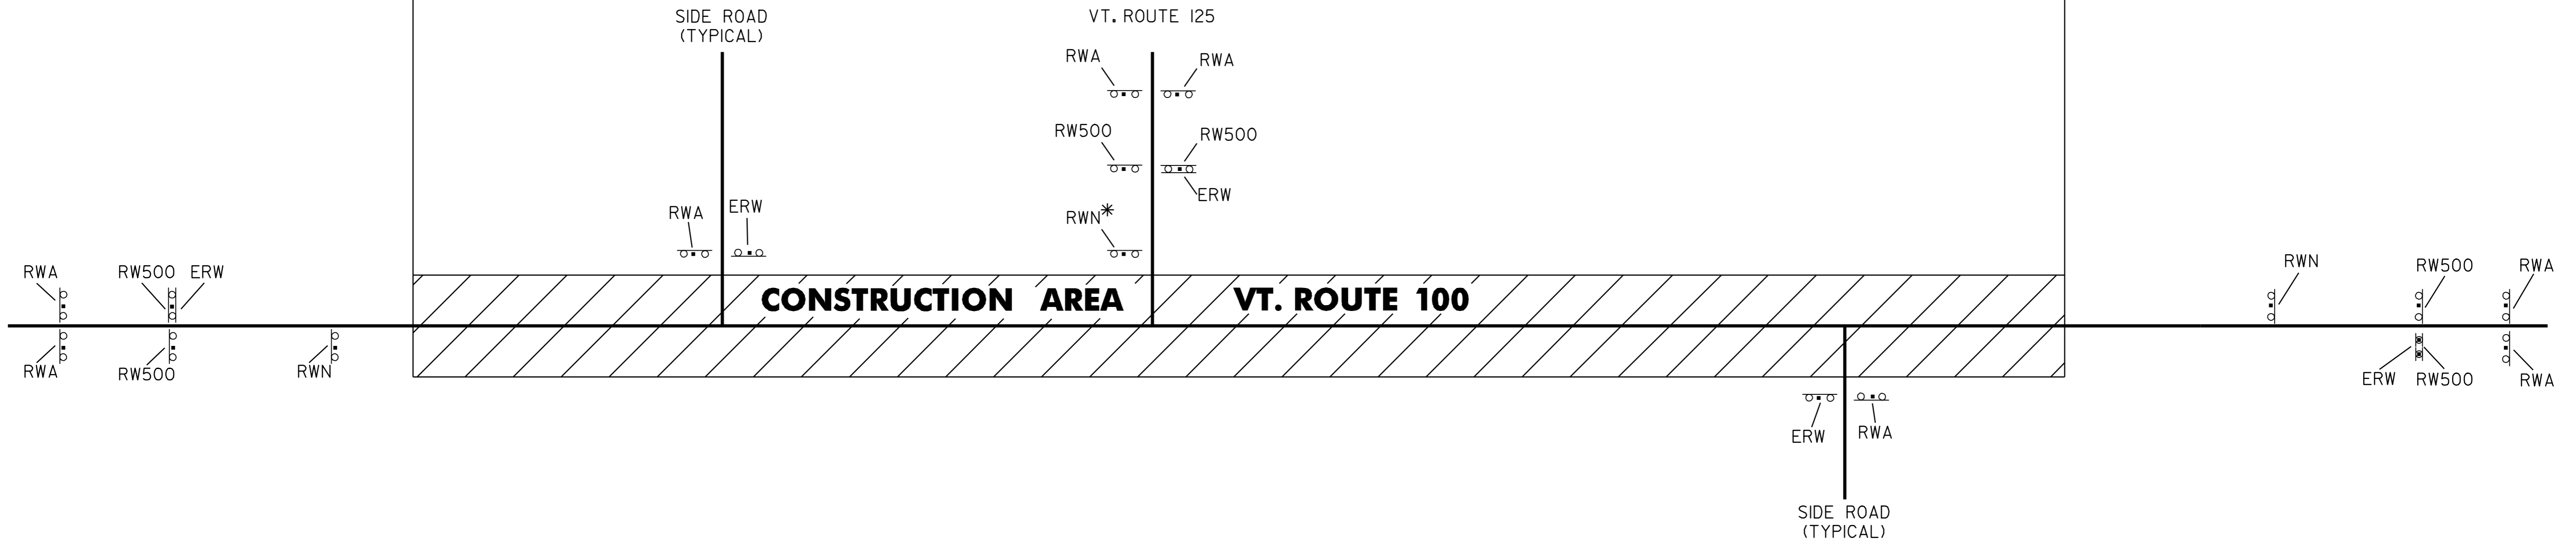

CONSTRUCTION APPROACH SIGNING

SEE STD. E-100 AND E-103 FOR ADDITIONAL SIGN PLACEMENT

SIGN LEGEND

- RWA = ROAD WORK AHEAD
- RW500 = ROAD WORK 500 FEET
- ERW = END ROAD WORK
- SRWA = SIDE ROAD WORK AHEAD
- SRW500 = SIDE ROAD WORK 500 FEET
- RWN = ROAD WORK NEXT 7 3/4 MILES
- RWN* = ROAD WORK NEXT 4 MILES

LIST OF TOWN HIGHWAYS FOR CONSTRUCTION SIGNS

TOWN HIGHWAY NUMBER	ROAD WORK AHEAD	END ROAD WORK	OTHER
BEGIN PROJECT	2	1	2 - RW500 1 - RWN
T-16	1	1	
T-61	1	1	
T-12	1	1	
T-1	1	1	
T-8	1	1	
T-9	1	1	
T-20	1	1	
VT. ROUTE 125	2	1	2 - RW500 1 - RWN*
T-7	1	1	
T-3	1	1	
T-5	1	1	
T-2	1	1	
END PROJECT	2	1	2 - RW500 1 - RWN
TOTAL	17	14	9

DATUM
VERTICAL N/A
HORIZONTAL N/A

CONSTRUCTION APPROACH SIGNING SHEET

SURVEYED BY N/A DATE N/A
DRAWN BY C.A.K. DATE 11/00
SQUAD LEADER T.P.K.
DESIGN FILE NO. /pave/98bl80/pbl80.dgn
IPARM pbl80cas.i DATE 21-DEC-2006 15
FILE pbl80cas.i PLOTTED 21-DEC-2006 15
PROJ. NAME ROCHESTER-GRANVILLE
PROJ. NO. AC_STP_2124(I)S
SHEET 49 OF 49 SHEETS _____