

**Record Plans**  
 Contractor: CCS CONSTRUCTORS, INC.  
 Resident Engineer: CHRIS BARKER  
 Construction Began: JUNE 28, 2017  
 Construction Complete: DECEMBER 20, 2019  
 Record Plans By: CHRIS BARKER & RYAN GREENE

I hereby certify that all construction required by this set of drawings has been accomplished as indicated herein.

E-SIGNED by Christopher Barker  
 on 2020-03-31 18:48:41 GMT  
 BY: \_\_\_\_\_ Resident Engineer



March 31, 2020  
 Date: \_\_\_\_\_

NOTE: Any further information concerning final quantities, amounts or other details relative to this project may be found in electronic locations including Doc Express, OnBase or the Agency's other electronic filing locations.


# STATE OF VERMONT AGENCY OF TRANSPORTATION



## PROPOSED IMPROVEMENT BRIDGE PROJECT TOWN OF EAST MONTPELIER COUNTY OF WASHINGTON BRIDGE NO. 68 ON VT ROUTE 14 PRINCIPAL ARTERIAL (US 2) & MINOR ARTERIAL (VT 14)

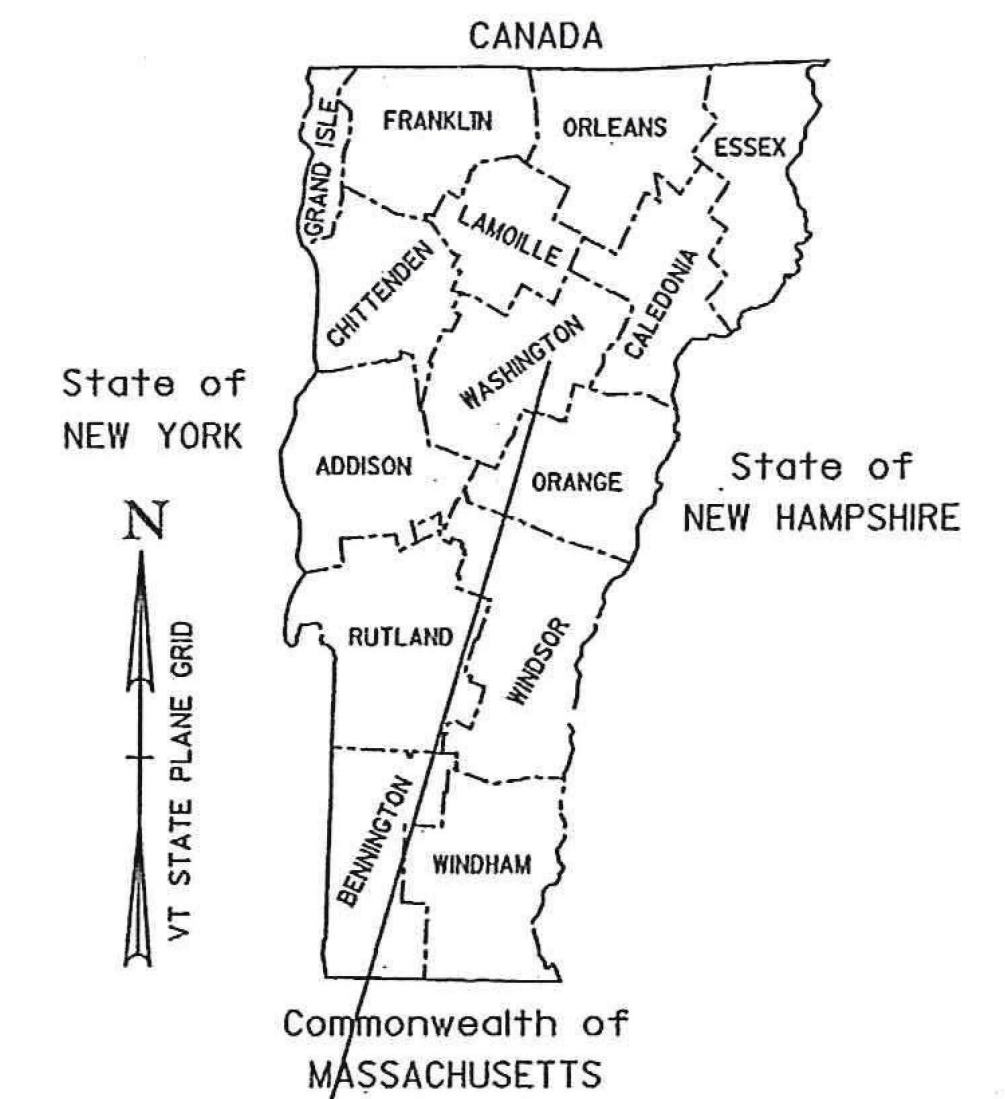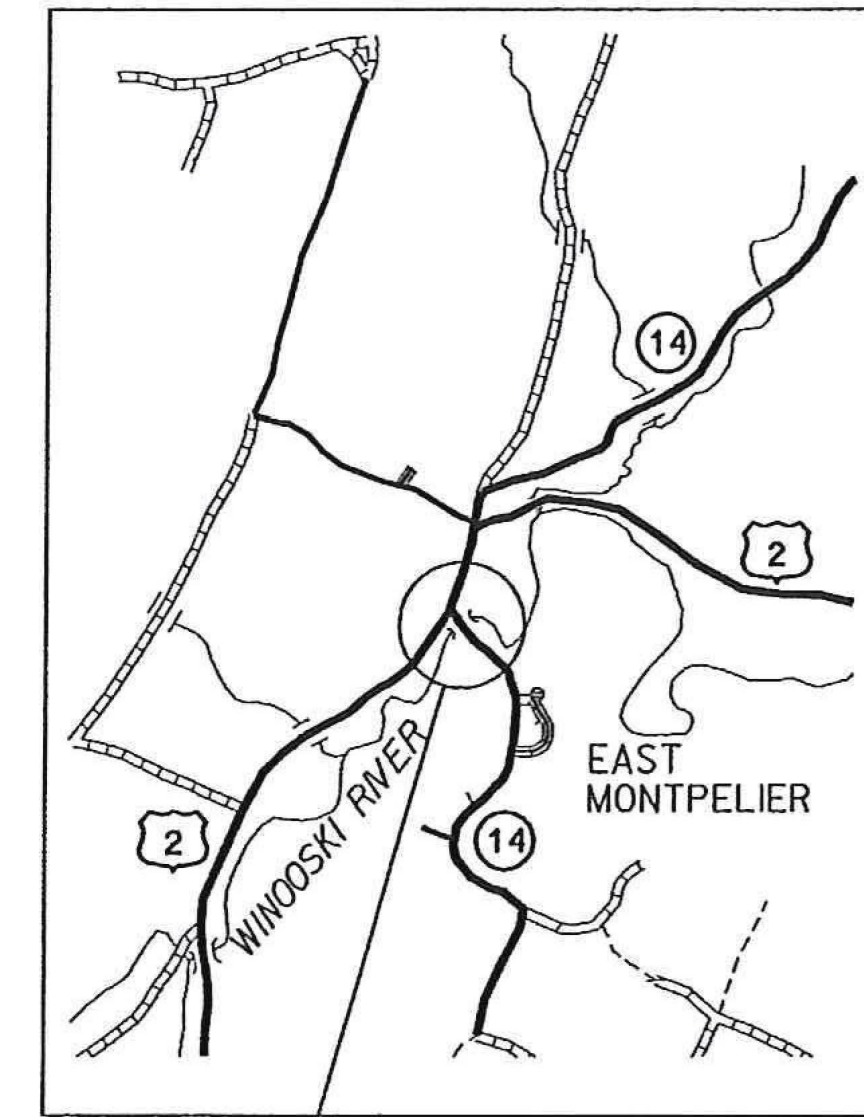

EAST MONTPELIER BRF 037-1 (7)  
 (LOCATION MAP NOT TO SCALE)

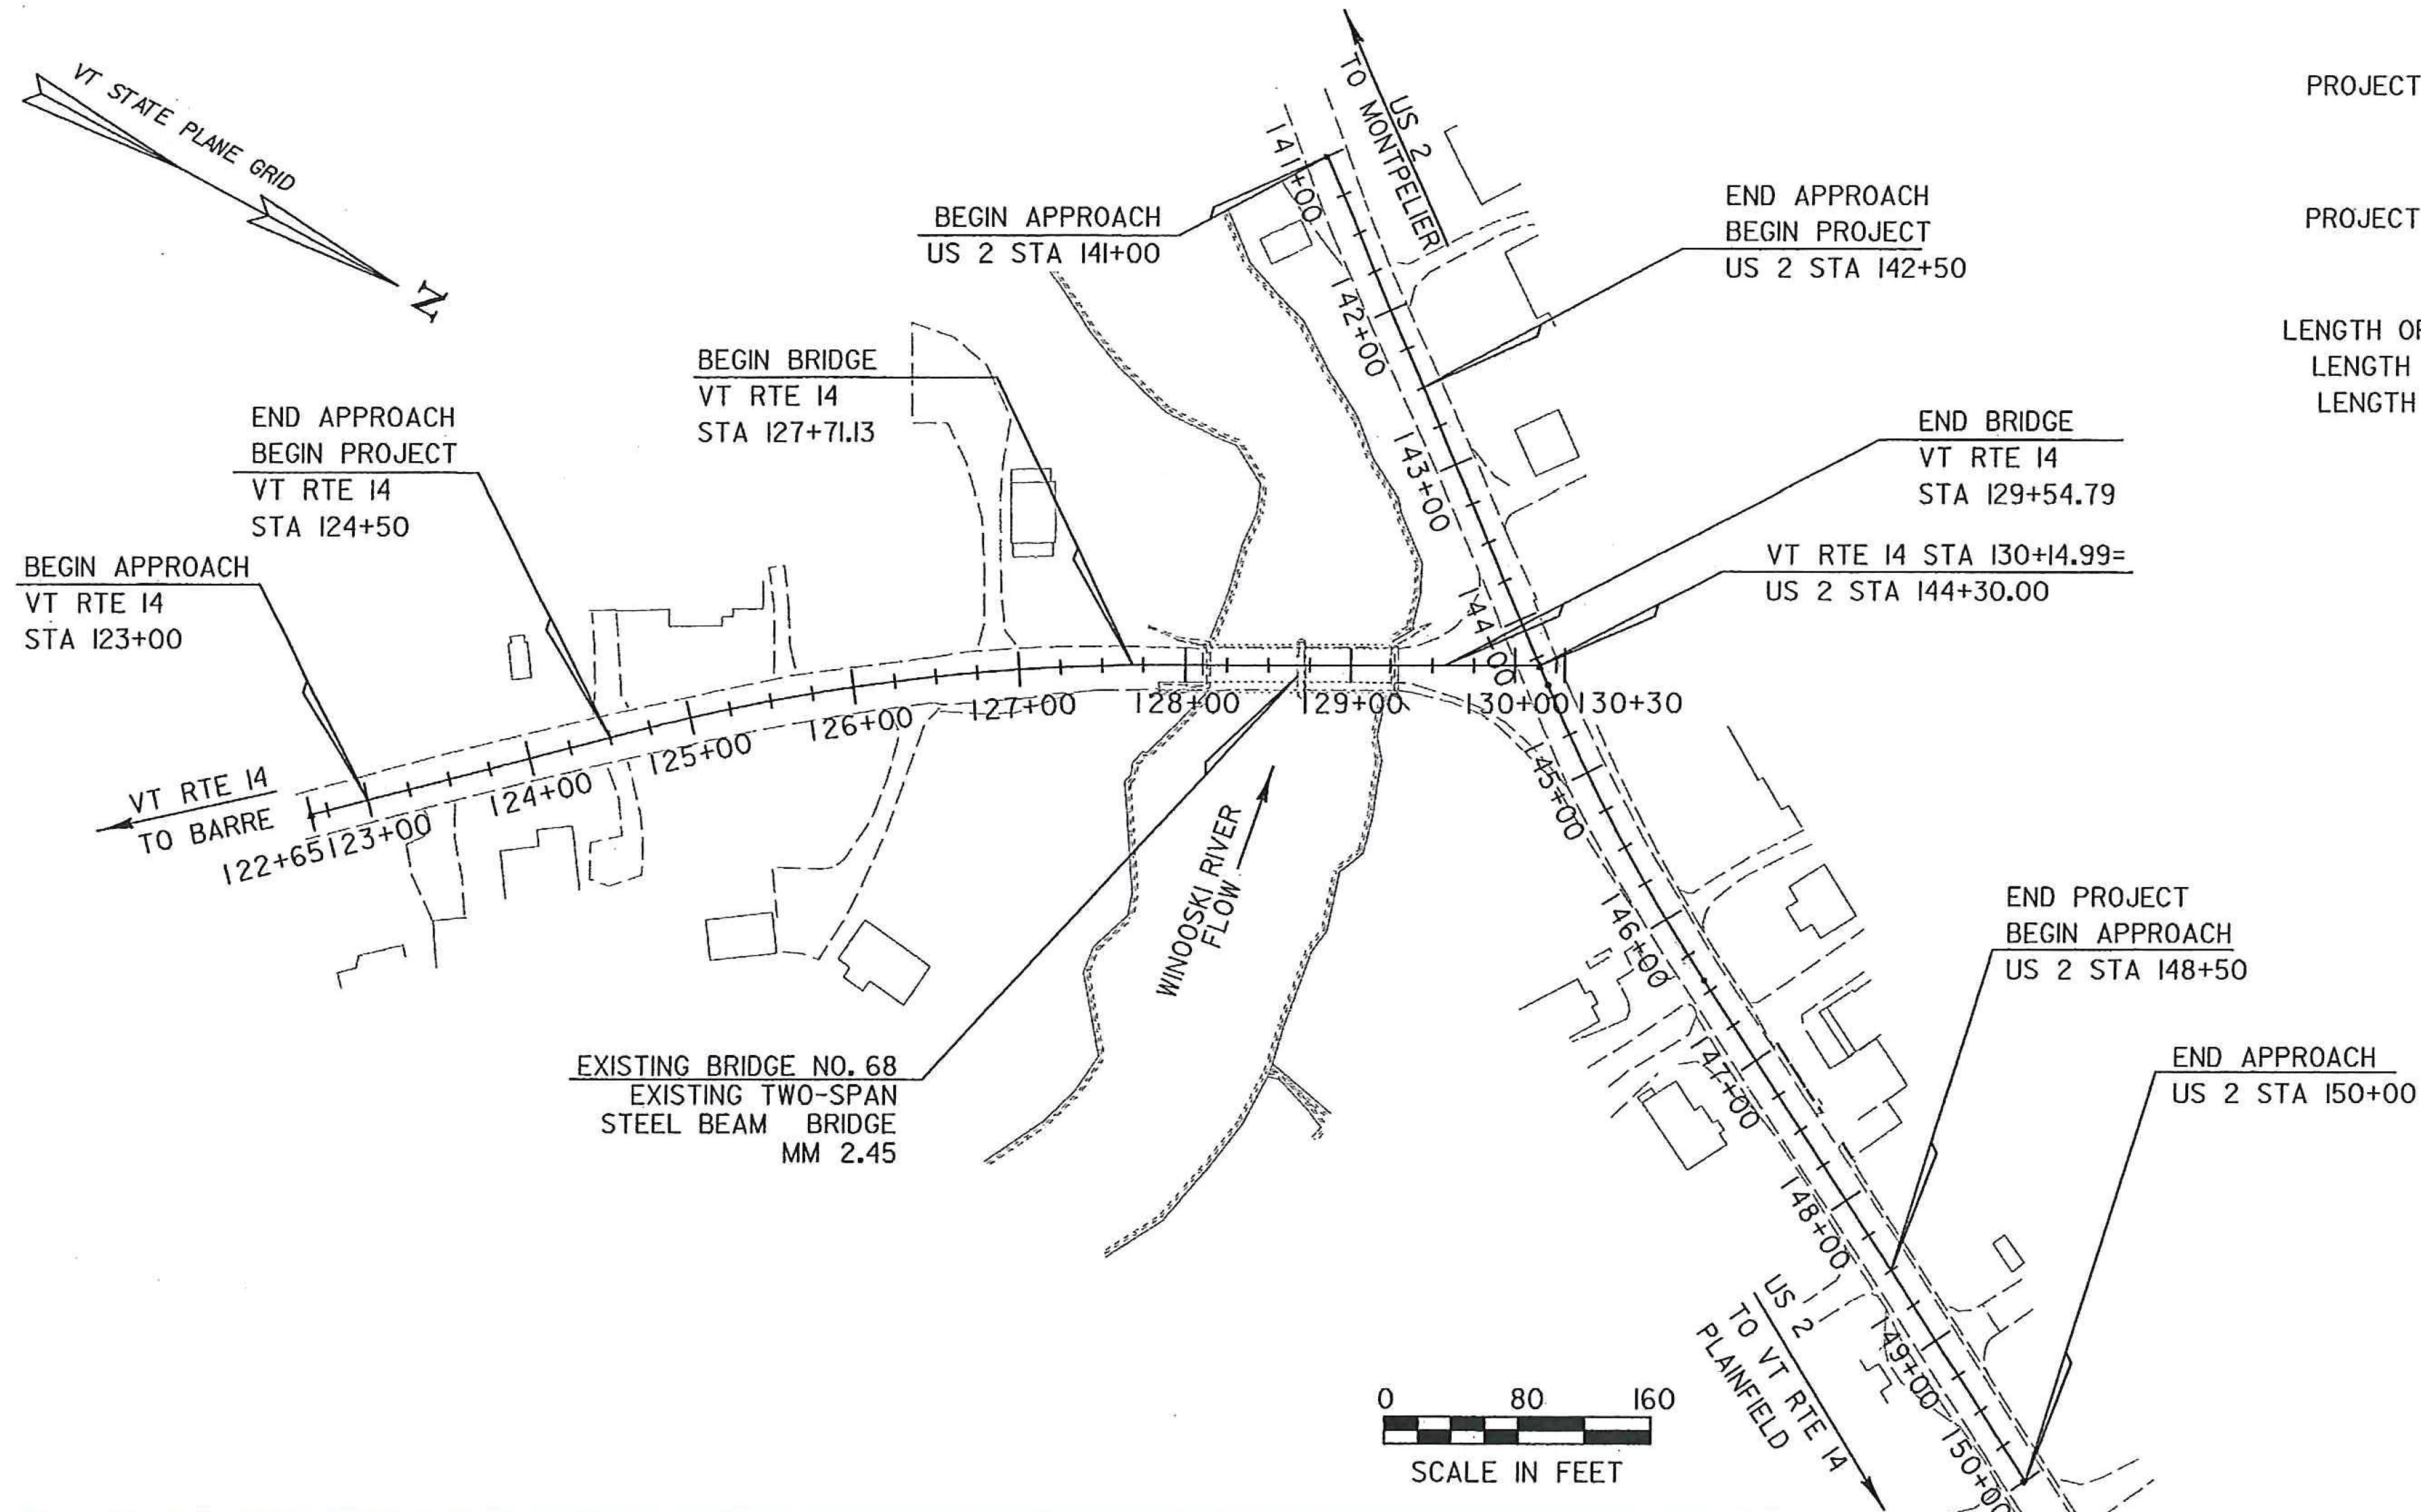


PROJECT LOCATION : LOCATED IN THE COUNTY OF WASHINGTON, TOWN OF EAST MONTPELIER, ON VERMONT ROUTE 14; BRIDGE 68 OVER THE WINOOSKI RIVER, AT THE INTERSECTION OF US ROUTE 2 AND VT ROUTE 14.

PROJECT DESCRIPTION : THE REPLACEMENT OF THE EXISTING STRUCTURE, NEW TRAFFIC SIGNAL, ALONG WITH RELATED CHANNEL AND ROADWAY WORK.

LENGTH OF STRUCTURE : 183.66 FEET  
 LENGTH OF ROADWAY : 981.34 FEET  
 LENGTH OF PROJECT : 1165.00 FEET

CONSTRUCTION IS TO BE CARRIED ON IN ACCORDANCE WITH THESE PLANS AND THE STANDARD SPECIFICATIONS FOR CONSTRUCTION DATED 2011, AS APPROVED BY THE FEDERAL HIGHWAY ADMINISTRATION ON JULY 20, 2011 FOR USE ON THIS PROJECT, INCLUDING ALL SUBSEQUENT REVISIONS AND SUCH REVISED SPECIFICATIONS AND SPECIAL PROVISIONS AS ARE INCORPORATED IN THESE PLANS.

QUALITY ASSURANCE PROGRAM : LEVEL I
SURVEYED BY : R. GILMAN
SURVEYED DATE : OCTOBER 1999
DATUM
VERTICAL DATUM NAVD 88
HORIZONTAL DATUM NAD 83 (92)

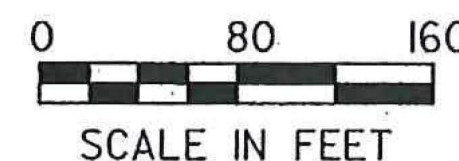

DEPARTMENT OF TRANSPORTATION FEDERAL HIGHWAY ADMINISTRATOR
APPROVED <i>Mark Sargent</i> DATE 3/7/17
DIRECTOR OF PROJECT DELIVERY
APPROVED <i>J.H.M.</i> DATE 2/17/2017
PROJECT MANAGER : MARK SARGENT
PROJECT NAME : EAST MONTPELIER
PROJECT NUMBER : BRF 037-1 (7)
SHEET 1 OF 158 SHEETS

**Stantec**  
 Stantec Consulting Services Inc.  
 55 Green Mountain Drive  
 South Burlington VT U.S.A. 05403  
 Phone: (802) 864-0223  
 Fax: (802) 864-0165  
 www.stantec.com