




**PIPE #17 PROFILE**  
(SEE SHEET DP 4 FOR PLAN)

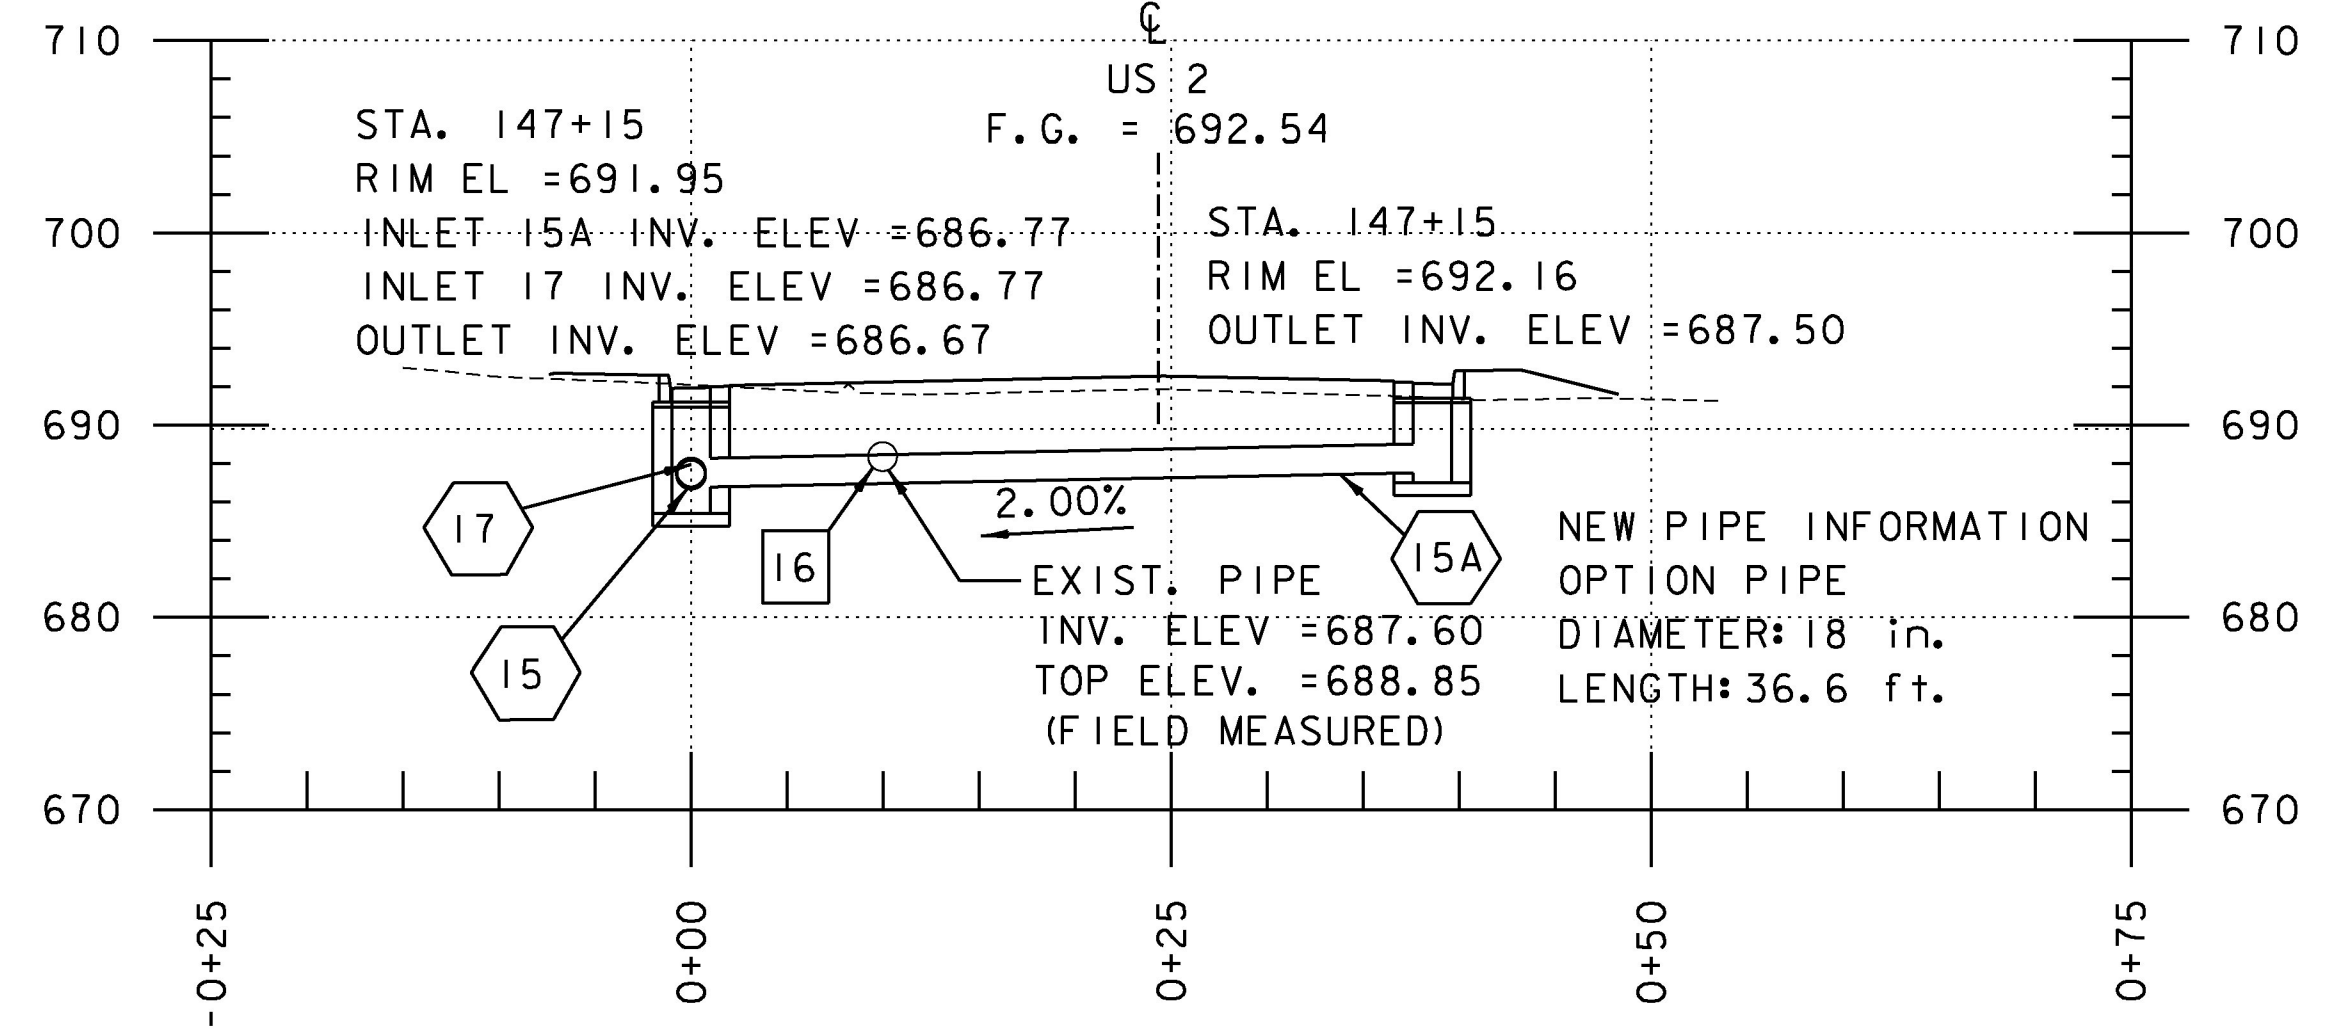

**PIPE #15A PROFILE**  
(SEE SHEET DP 4 FOR PLAN)

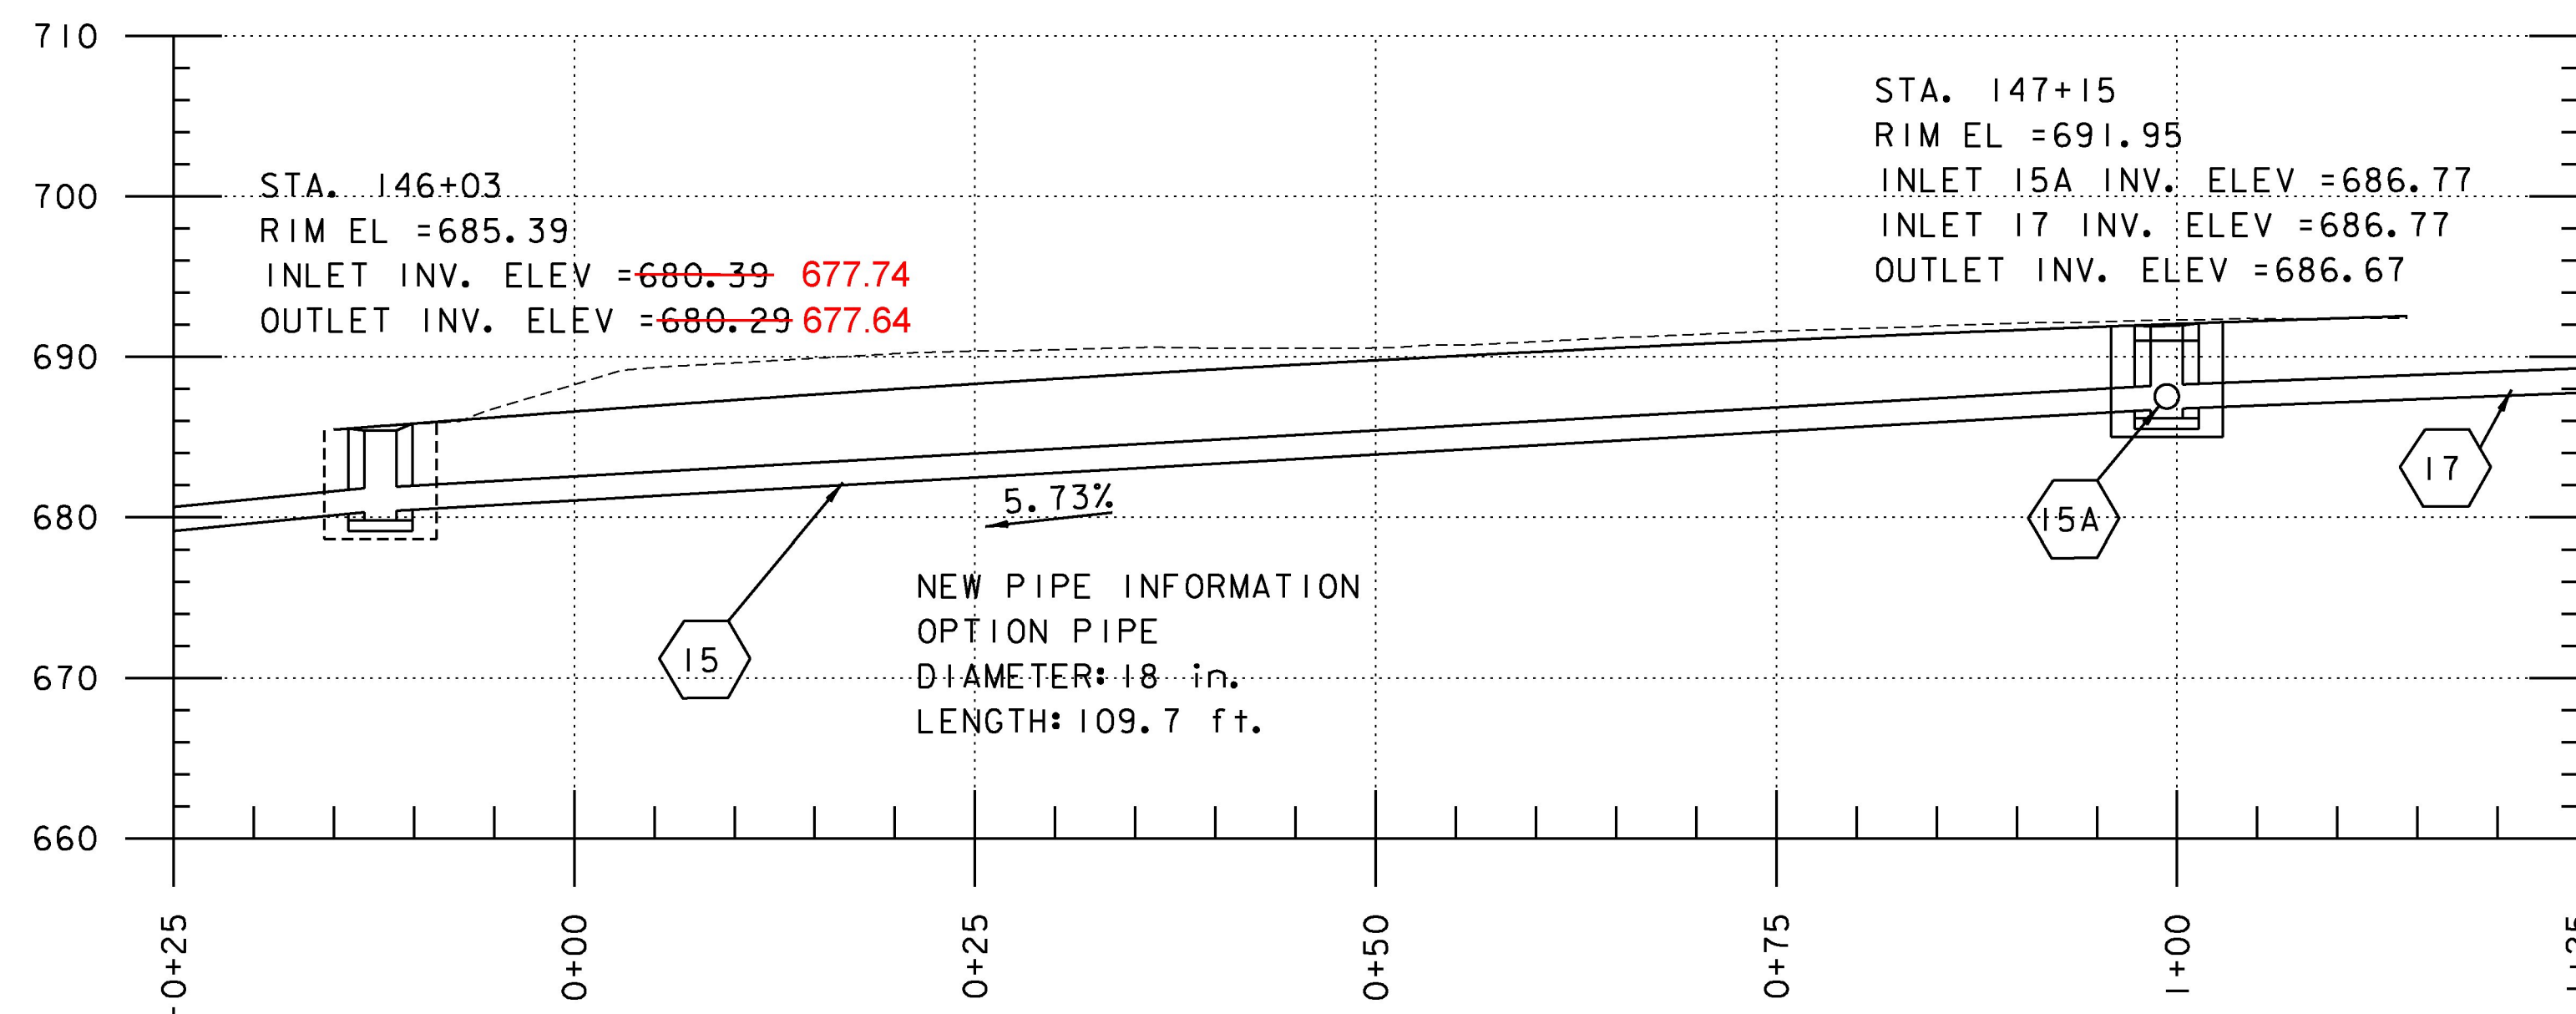

**PIPE #15 PROFILE**  
(SEE SHEET DP 4 FOR PLAN)

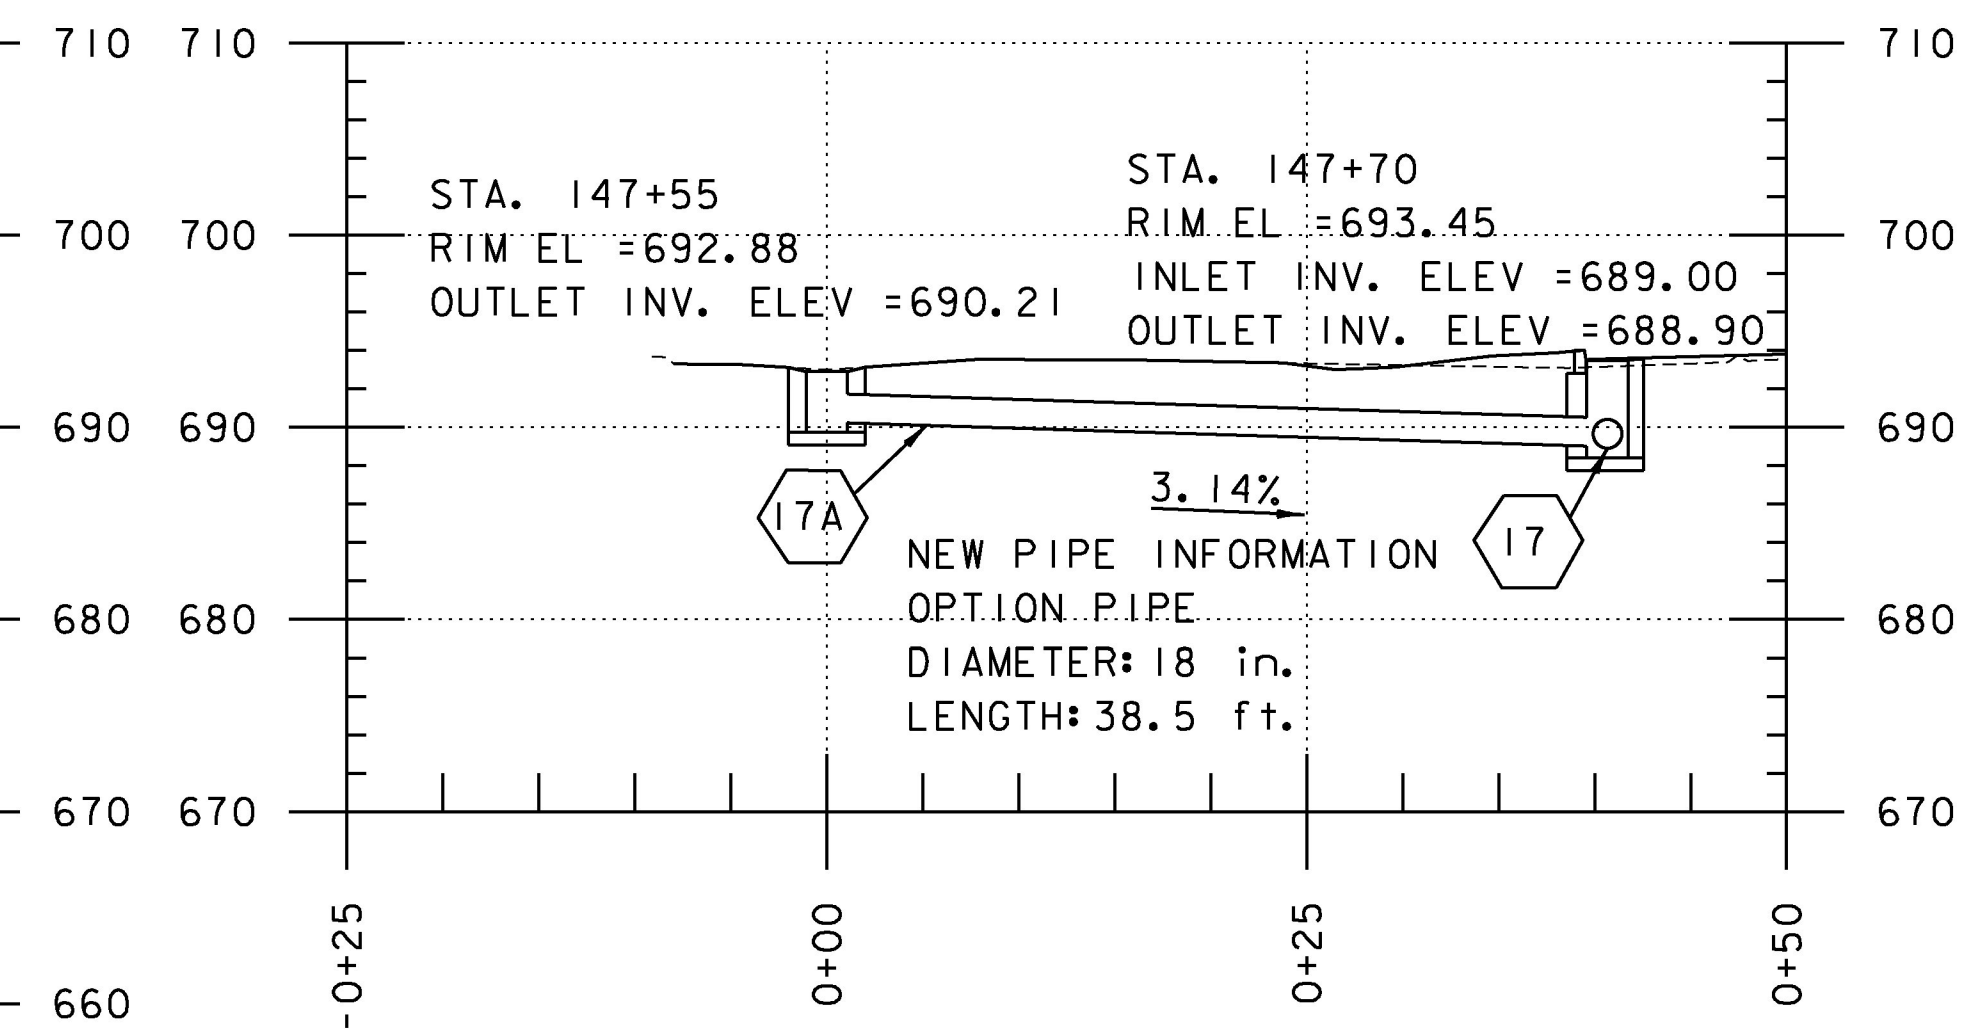

**PIPE #17A PROFILE**  
(SEE SHEET DP 4 FOR PLAN)

NOTE:

FOR CLARITY UNDERDRAIN IS NOT SHOWN IN PROFILES  
ADJUST UNDERDRAIN AS REQUIRED TO AVOID CULVERTS  
DRAINAGE STRUCTURES.

PROJECT NAME: EAST MONTPELIER	PLOT DATE: 2/17/2017
PROJECT NUMBER: BRF 037-(17)	DRAWN BY: E. ALLING
FILE NAME: I9_Drainage profiles.dgn	DESIGNED BY: K. RICHARDSON
PROJECT LEADER: T. KNIGHT	CHECKED BY: G. GOYETTE
DRAINAGE PROFILES DP 8	SHEET 38 OF 158

