


SPECIAL PROVISIONS (HORIZONTAL DIRECTIONAL DRILLING) (4") (HDPE)  
 FIVE CONDUITS: STA. 143+37.9 TO STA. 145+57.7 RT

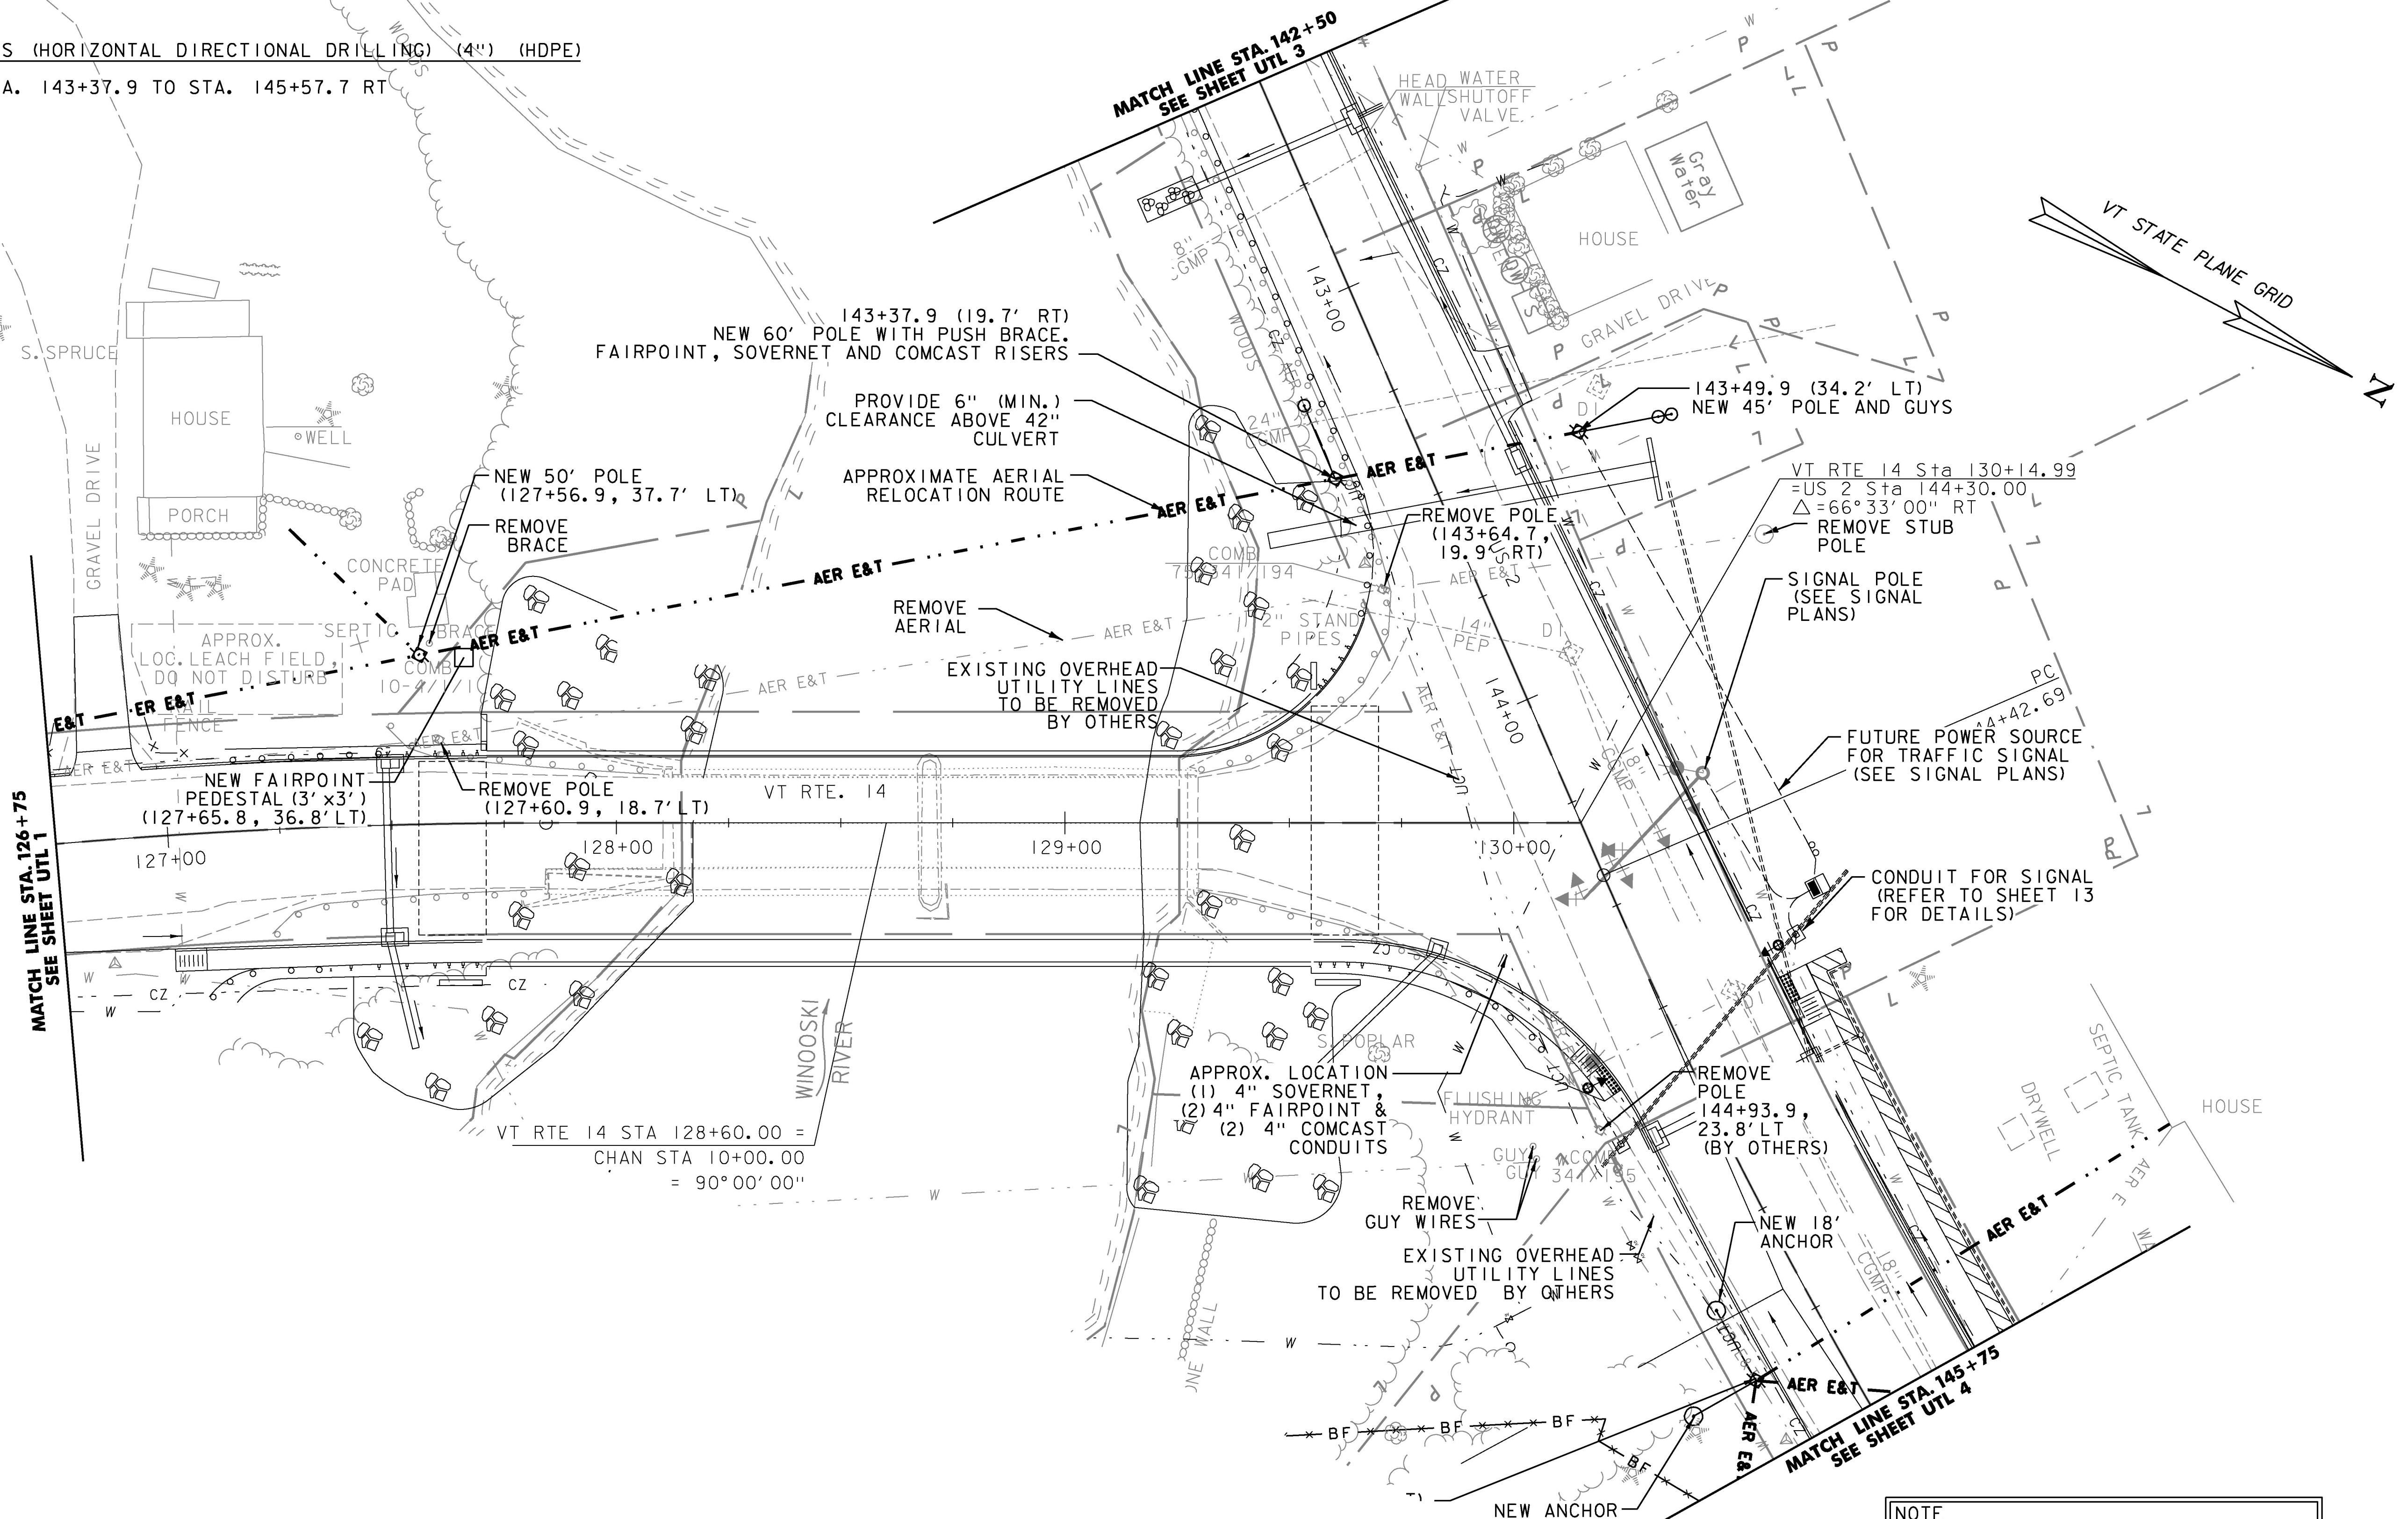

NOTE  
 THIS SHEET IS BEING PROVIDED FOR  
 REFERENCE ONLY. WORK TO BE  
 COMPLETED PRIOR TO PROJECT.

PROJECT NAME:	EAST MONTPELIER
PROJECT NUMBER:	BRF 037-(17)
FILE NAME: ... \28_Utilities plans.dgn	PLOT DATE: 2/17/2017
PROJECT LEADER: T. KNIGHT	DRAWN BY: E. ALLING
DESIGNED BY: K. RICHARDSON	CHECKED BY: G. GOYETTE
UTILITIES PLANS-UTL 2	SHEET 44 OF 158

