


MATCH LINE STA. 145+75
SEE SHEET UTL 2

NOTE
THIS SHEET IS BEING PROVIDED
FOR REFERENCE ONLY.

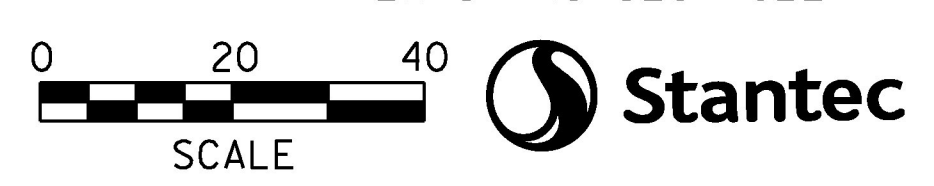

PROJECT NAME:	EAST MONTPELIER	PLOT DATE:	2/17/2017
PROJECT NUMBER:	BRF 037-(17)	DRAWN BY:	E. ALLING
FILE NAME:	...\\28_Utility plans.dgn	DESIGNED BY:	K. RICHARDSON
PROJECT LEADER:	T. KNIGHT	CHECKED BY:	G. GOYETTE
UTILITIES PLANS-UTL 4			SHEET 46 OF 158