

646.406 - DURABLE 4 INCH WHITE LINE, RECESSED POLYUREA

- STA 126+75 - 129+30.25 LT (EDGE LINE)
- STA 126+75 - 129+30.25 RT (EDGE LINE)
- STA 127+60 - 129+25 RT (LANE LINE)
- STA 142+50 - 145+75 LT (EDGE LINE)
- STA 142+50 - 143+84 RT (EDGE LINE)
- STA 143+96 - 145+75 RT (EDGE LINE)
- STA 145+00 - 145+75 LT (LANE LINE)

646.416 - DURABLE 4 INCH YELLOW LINE, RECESSED POLYUREA

- STA 126+75 - 129+25 (DOUBLE CENTERLINE)
- STA 129+25 - 145+00 (DOTTED)
- STA 142+50 - 143+54 (DOUBLE CENTERLINE)
- STA 142+50 - 143+54 (ISLAND MARKINGS)
- STA 145+00 - 145+75 (DOUBLE CENTERLINE)

646.486 - DURABLE 24 INCH STOP BAR, RECESSED POLYUREA

- STA 129+24 RT
- STA 143+49 RT
- STA 145+00 RT

646.494 - DURABLE LETTER OR SYMBOL, POLYUREA

- STA 127+64 RT - "S" "P"
- STA 128+36 RT - "M" (2)
- STA 129+15 RT - "S" "P"
- STA 145+09 LT - "S"
- STA 145+56 LT - "M"

675.20 - TRAFFIC SIGNS, TYPE A

- STA 127+33 RT
- STA 127+51 LT
- STA 127+60 RT
- STA 129+55 LT
- STA 129+50 RT
- STA 145+54 LT

675.50 - REMOVING SIGNS


22 - AS SHOWN

675.60 - ERECTING SALVAGED SIGNS

- STA 142+78 LT

REVISIONS		
	08.07.2017	LANE AND SHOULDER WIDTH CHANGES TO AVOID SEPTIC SYSTEM

LEGEND	
N	- NEW
R	- REMOVE
R&S	- REMOVE & SALVAGE
RET	- RETAIN
S	- SALVAGE

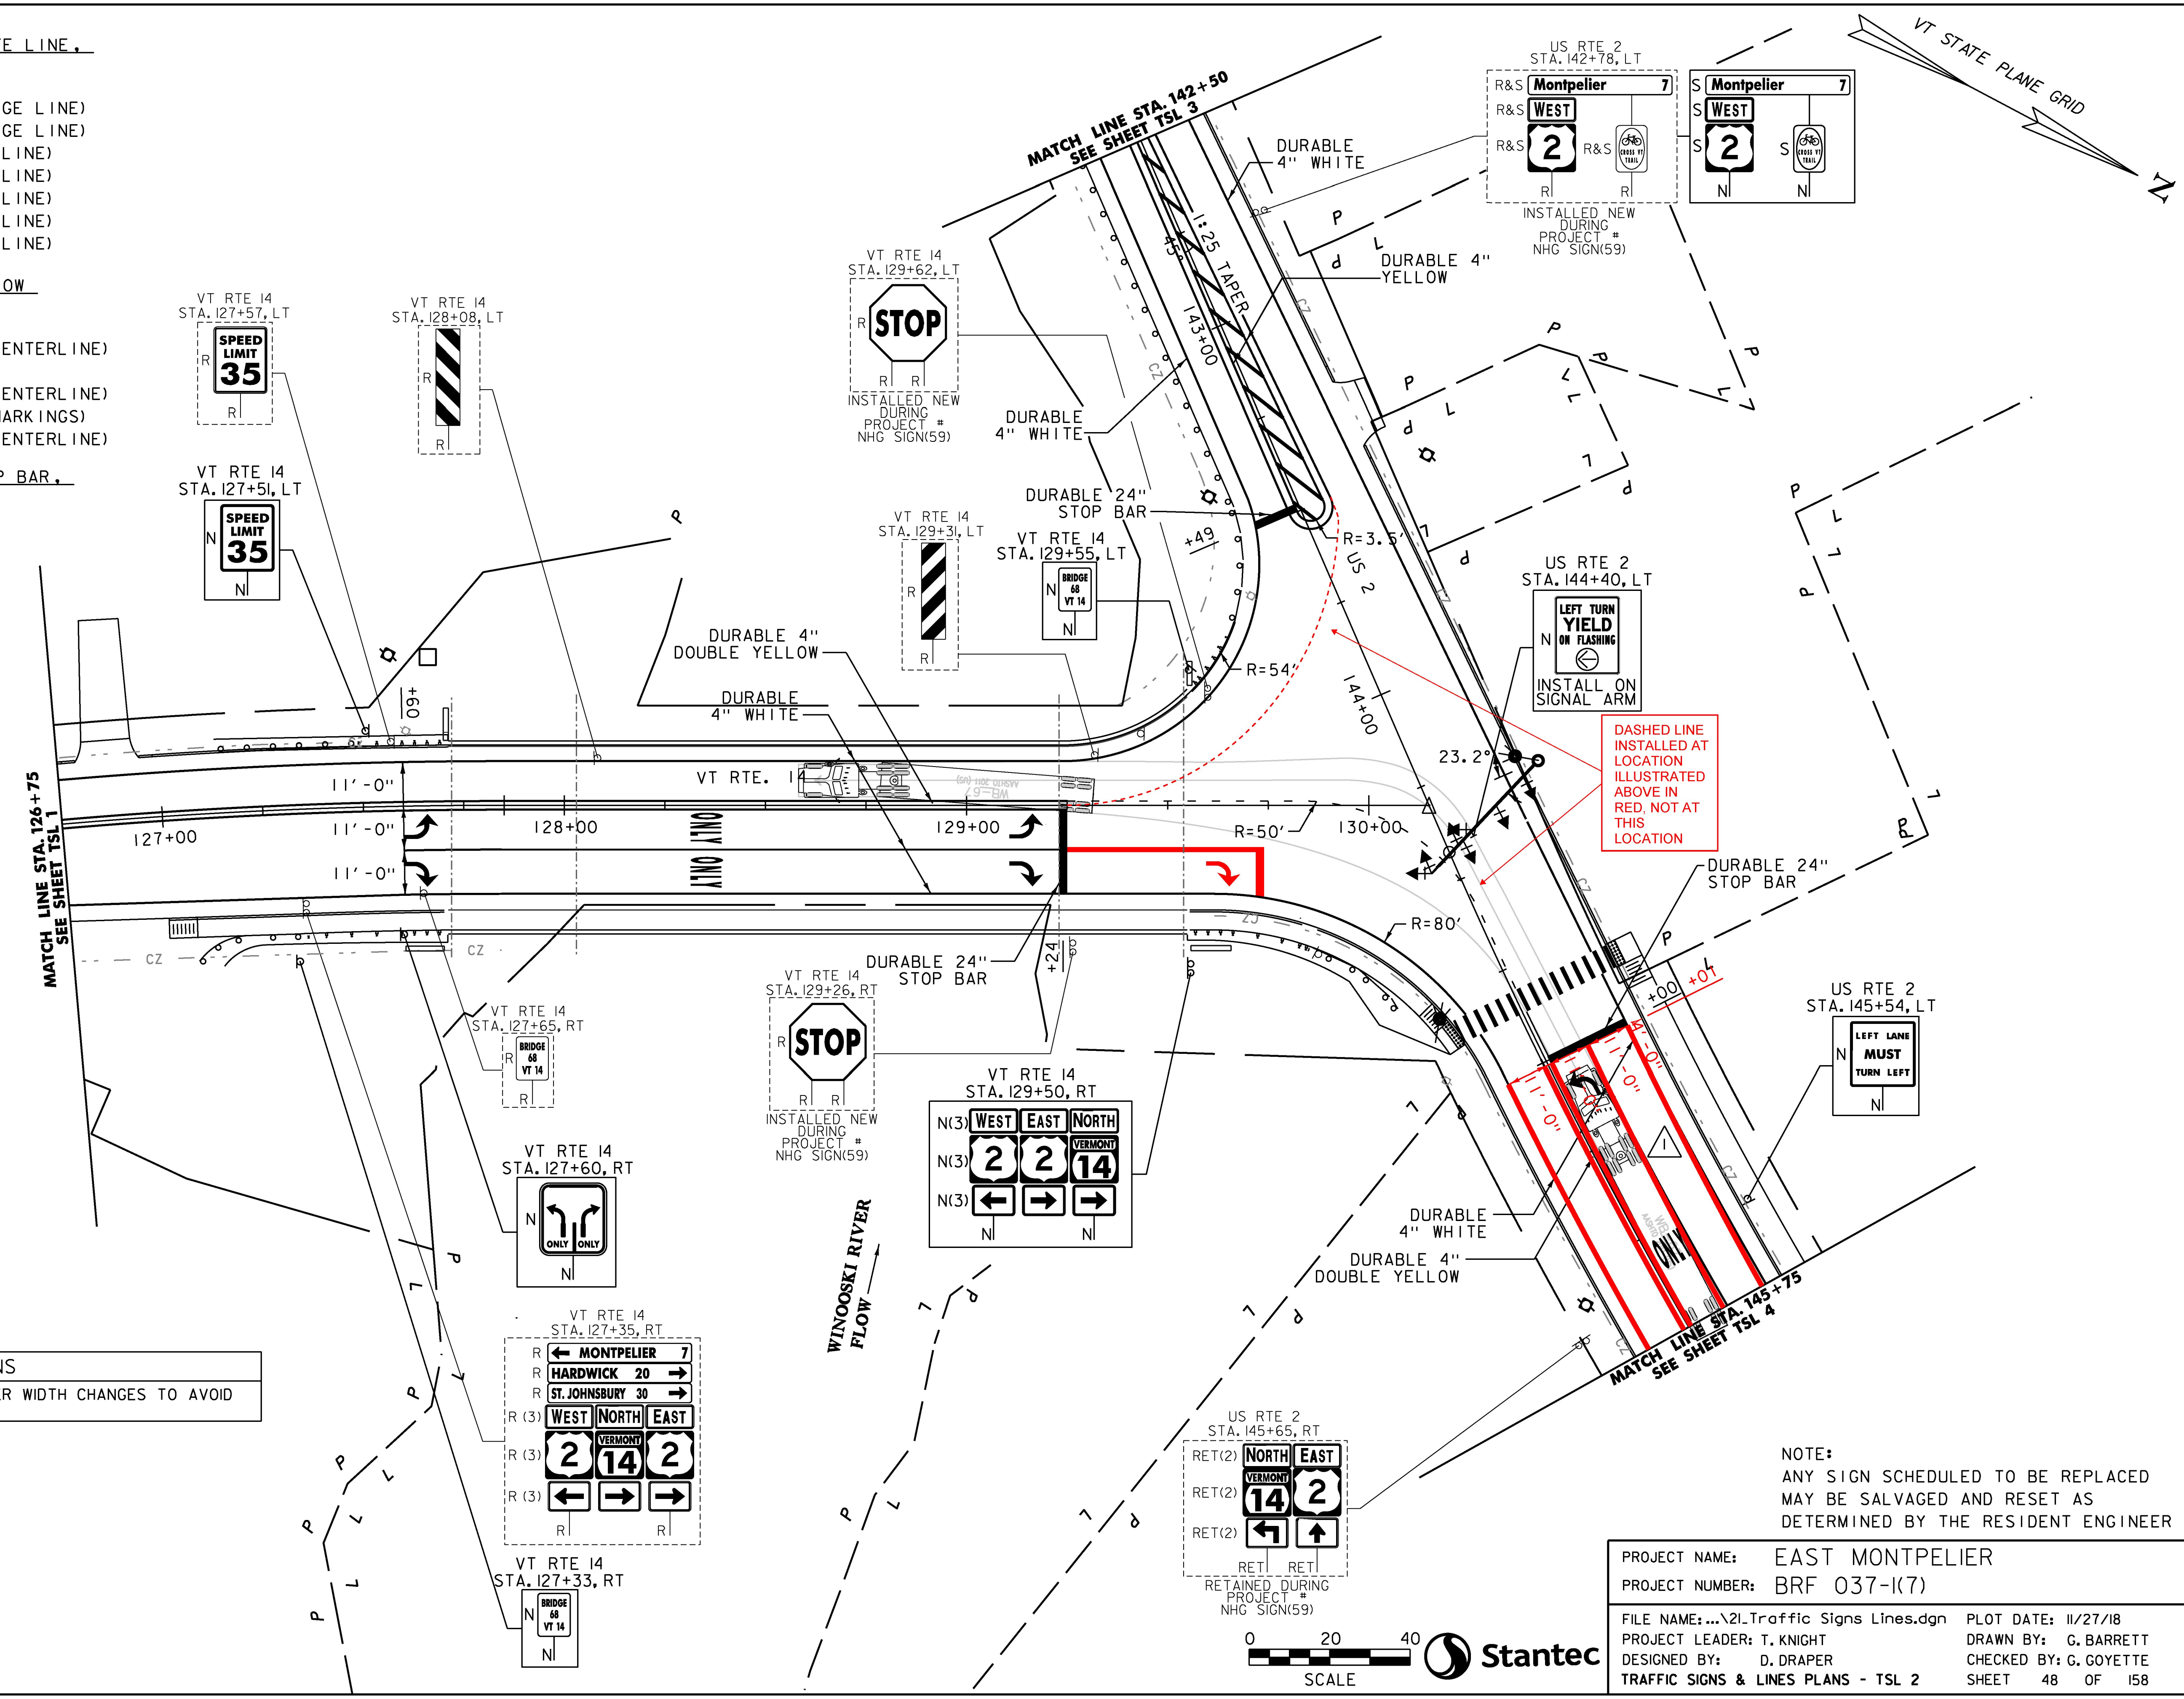

NOTE:
 ANY SIGN SCHEDULED TO BE REPLACED
 MAY BE SALVAGED AND RESET AS
 DETERMINED BY THE RESIDENT ENGINEER

PROJECT NAME:	EAST MONTPELIER
PROJECT NUMBER:	BRF 037-1(7)
FILE NAME:	...21-Traffic Signs Lines.dgn
PROJECT LEADER:	T. KNIGHT
DESIGNED BY:	D. DRAPER
TRAFFIC SIGNS & LINES PLANS - TSL 2	
PLOT DATE:	11/27/18
DRAWN BY:	G. BARRETT
CHECKED BY:	G. GOYETTE
SHEET	48 OF 158