


SECTION A-A  
SCALE: 1 1/2" = 1'-0"

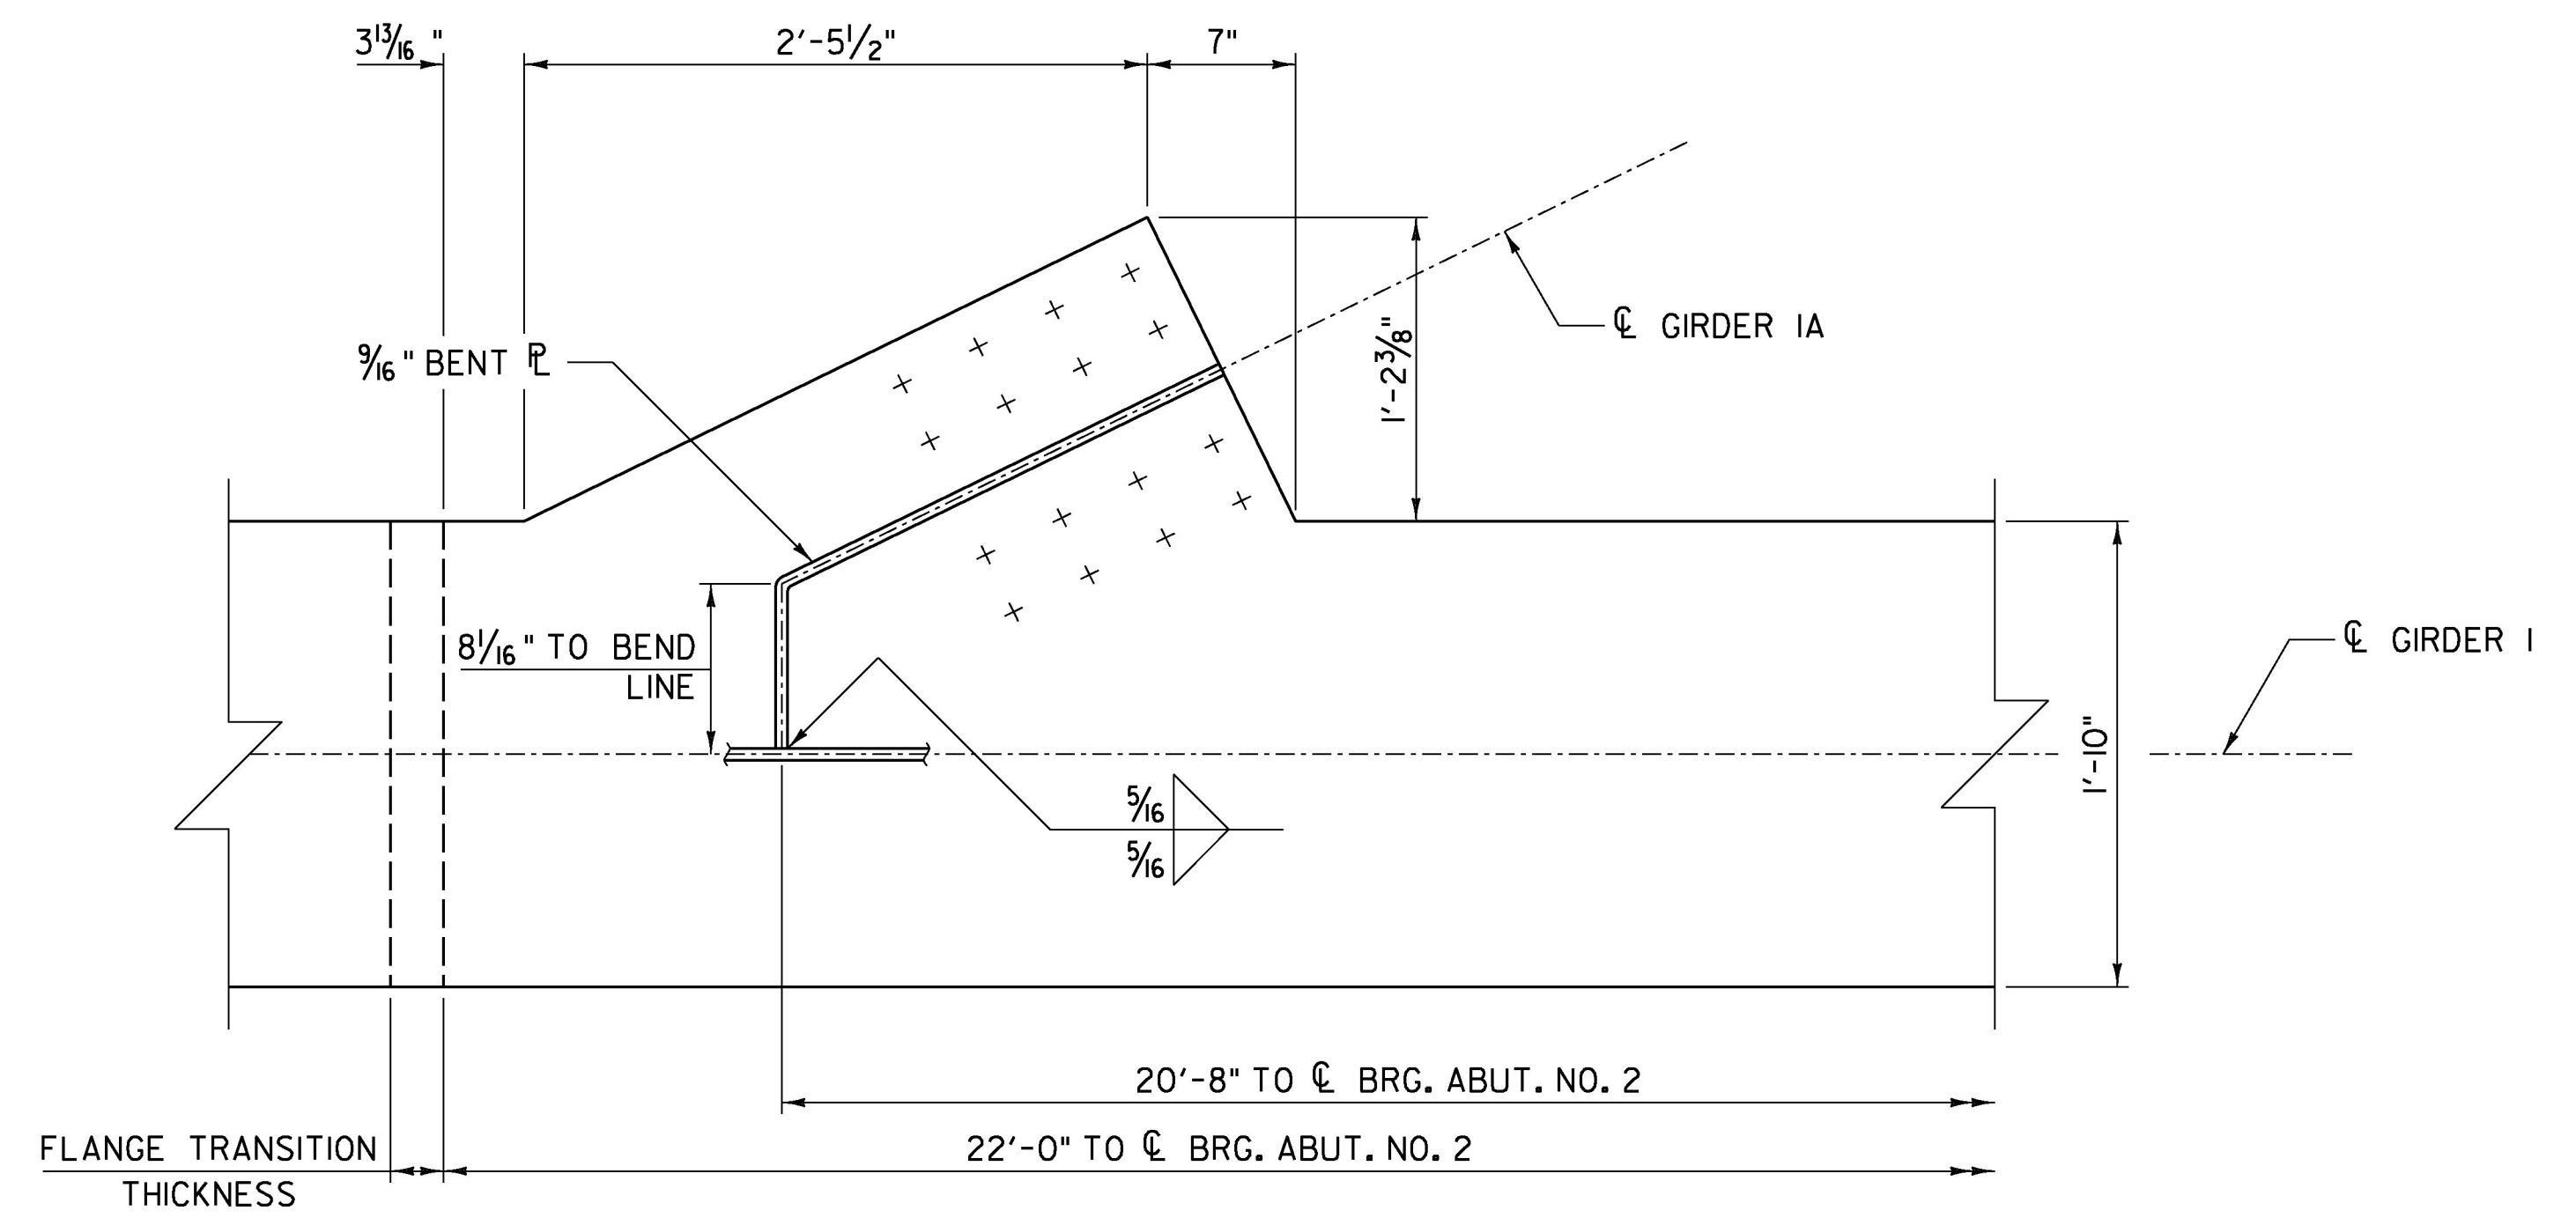

SECTION B-B  
SCALE: 1 1/2" = 1'-0"

NOTES:  
1. FOR SECTION A-A AND B-B LOCATIONS REFER TO GIRDER DETAILS I.

PROJECT NAME:	EAST MONTPELIER
PROJECT NUMBER:	BRF 037-1(7)
FILE NAME: z98b252fra.dgn	PLOT DATE: 2/17/2017
PROJECT LEADER: T. KNIGHT	DRAWN BY: L. BUXTON
DESIGNED BY: G. BOGUE	CHECKED BY: P. GREENBERG
GIRDER DETAILS 2	SHEET 81 OF 158

