



ABUTMENT NO. 1
SCALE: 3/4" = 1'-0"

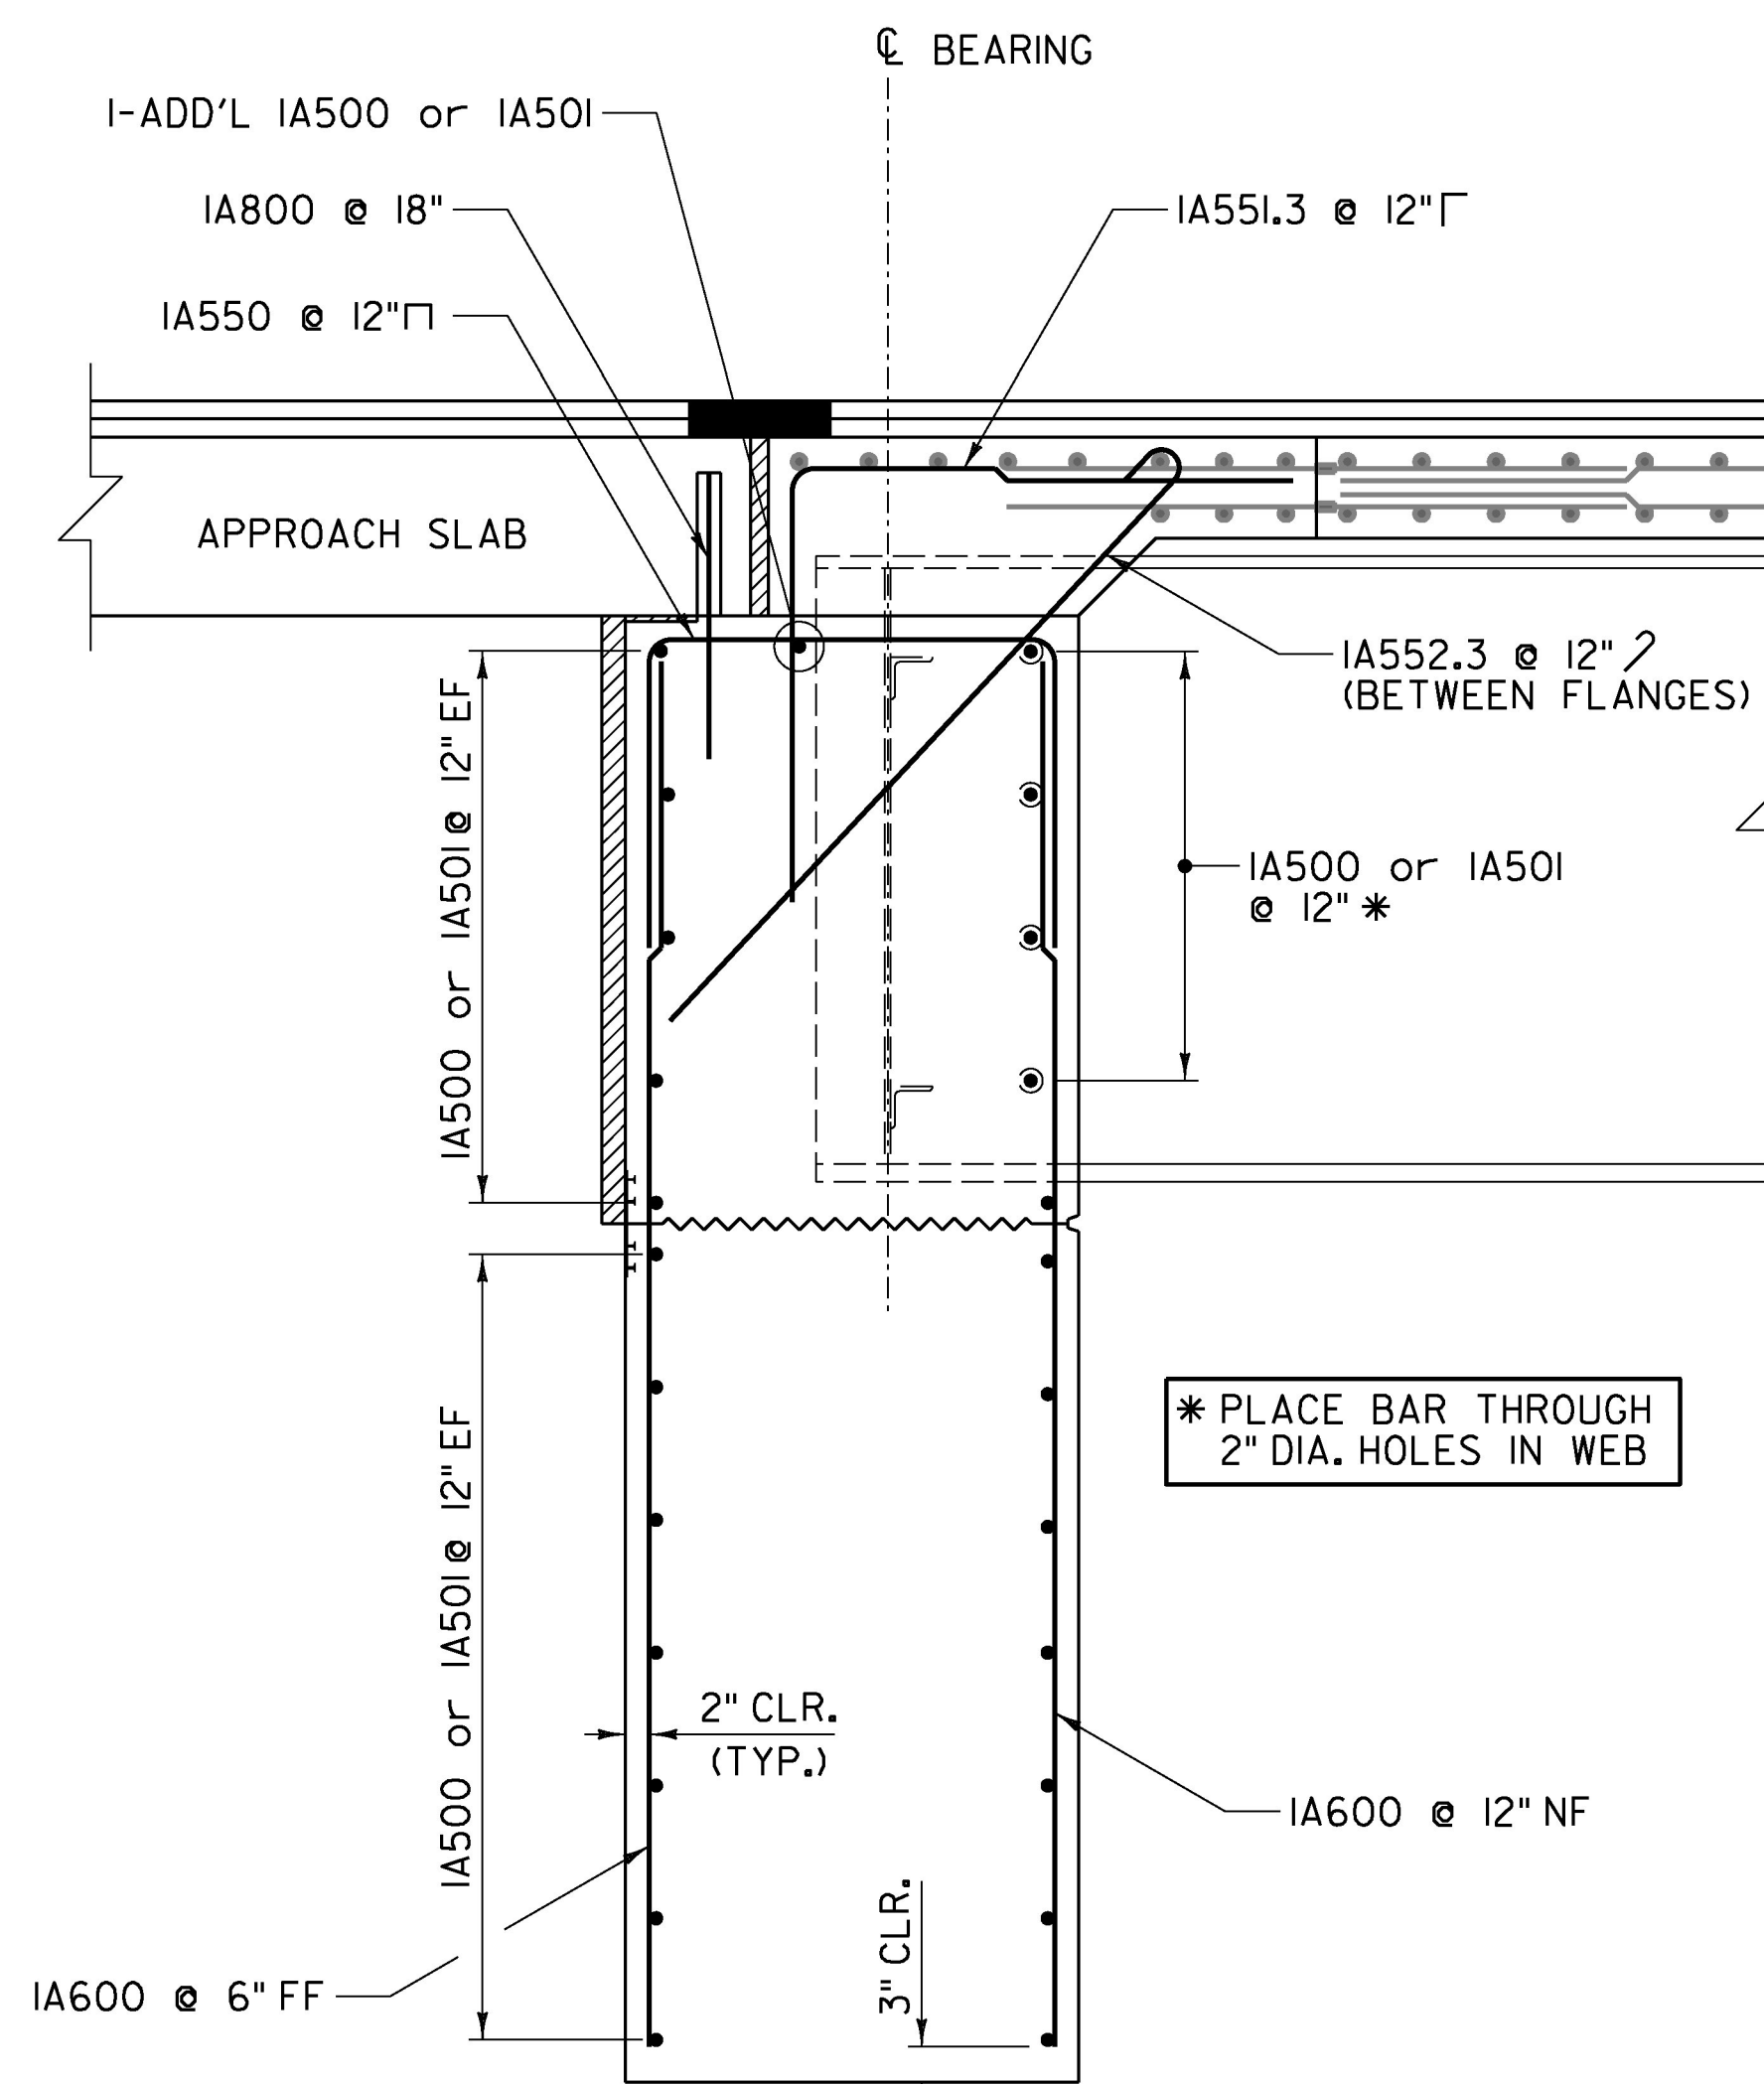

ABUTMENT NO. 1 REINFORCEMENT
SCALE: 3/4" = 1'-0"

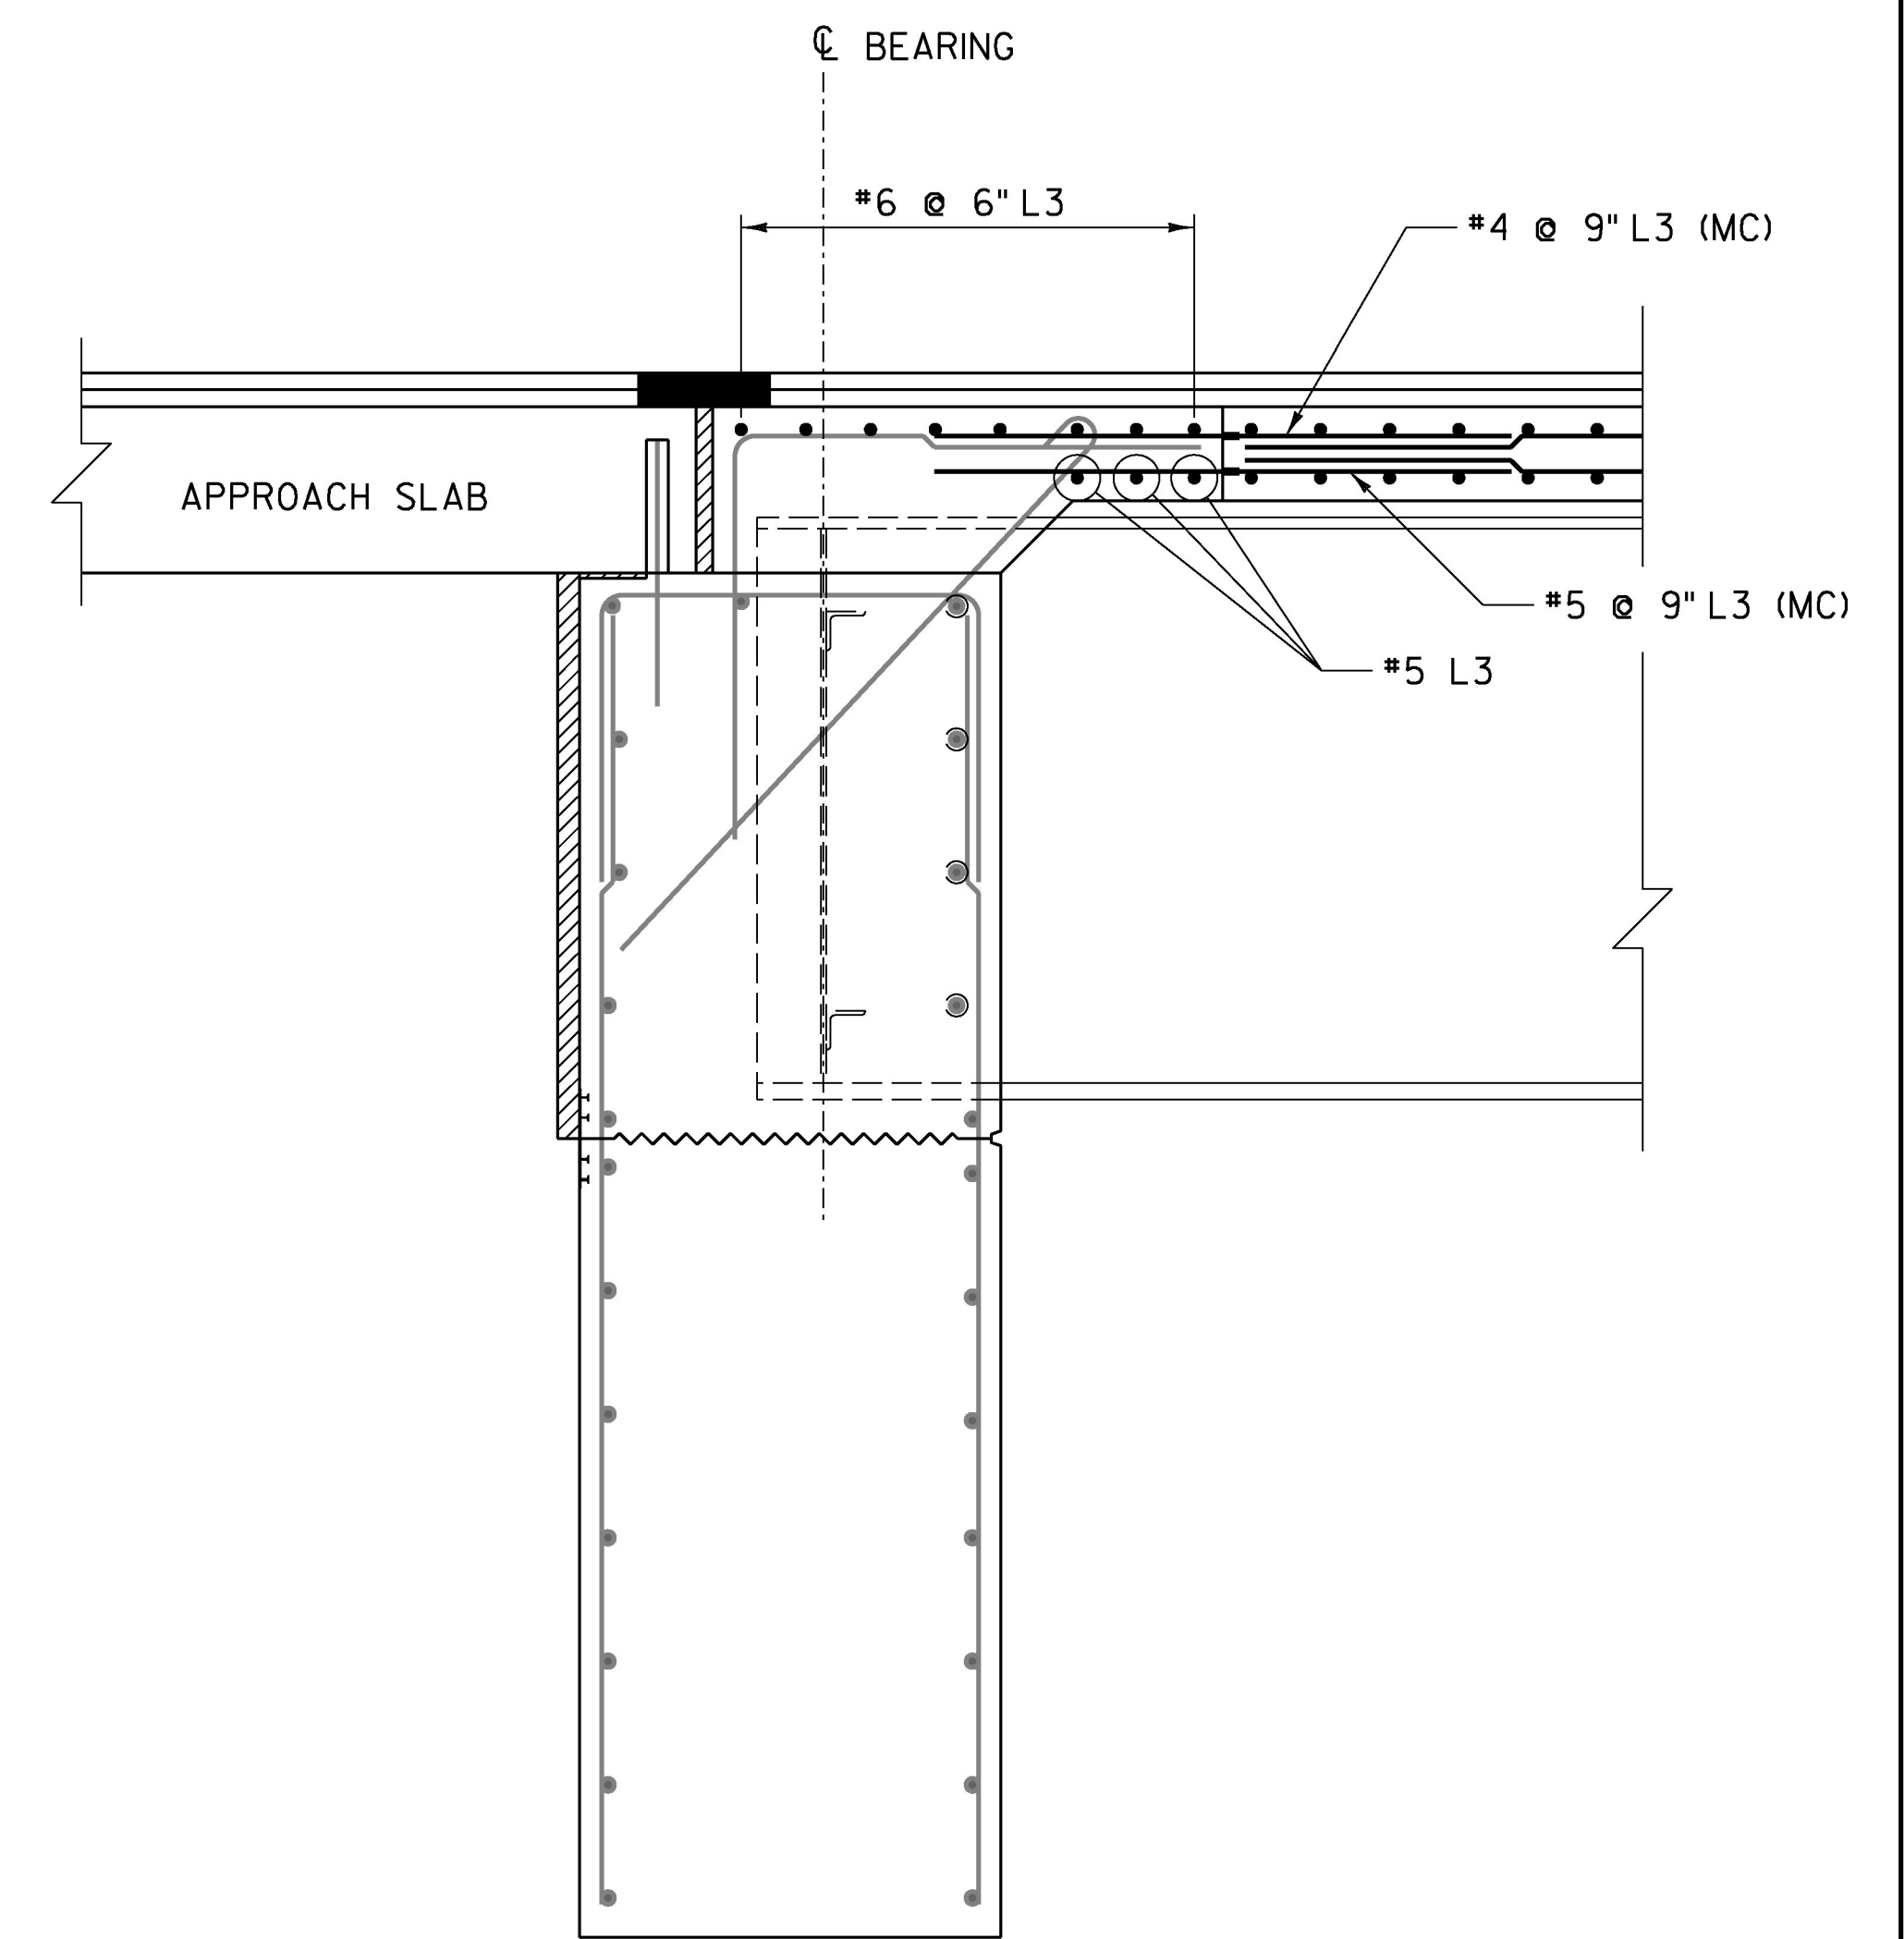

ABUTMENT NO. 1
END CLOSURE REINFORCEMENT
SCALE: 3/4" = 1'-0"

LEGEND:

- NF = NEAR FACE
- FF = FAR FACE
- EF = EACH FACE
- MID = MIDDLE
- (MC) = MECHANICAL CONNECTOR
- ▲ = CUT TO FIT IN FIELD

NOTES:

1. SPACE VERTICAL REINFORCEMENT TO AVOID GIRDERS.
2. ALL LAP SPLICES 2'-0" UNLESS NOTED OTHERWISE.



PROJECT NAME: EAST MONTPELIER	PLOT DATE: 2/17/2017
PROJECT NUMBER: BRF 037-(17)	DRAWN BY: J. SOTER
FILE NAME: z98b252abuts.dgn	DESIGNED BY: T. KNIGHT
PROJECT LEADER: T. KNIGHT	CHECKED BY: P. GREENBERG
ABUTMENT NO. 1 TYPICAL SECTIONS	SHEET 87 OF 158