


ABUTMENT NO. 2 PLAN
SCALE: 3/8" = 1'-0"

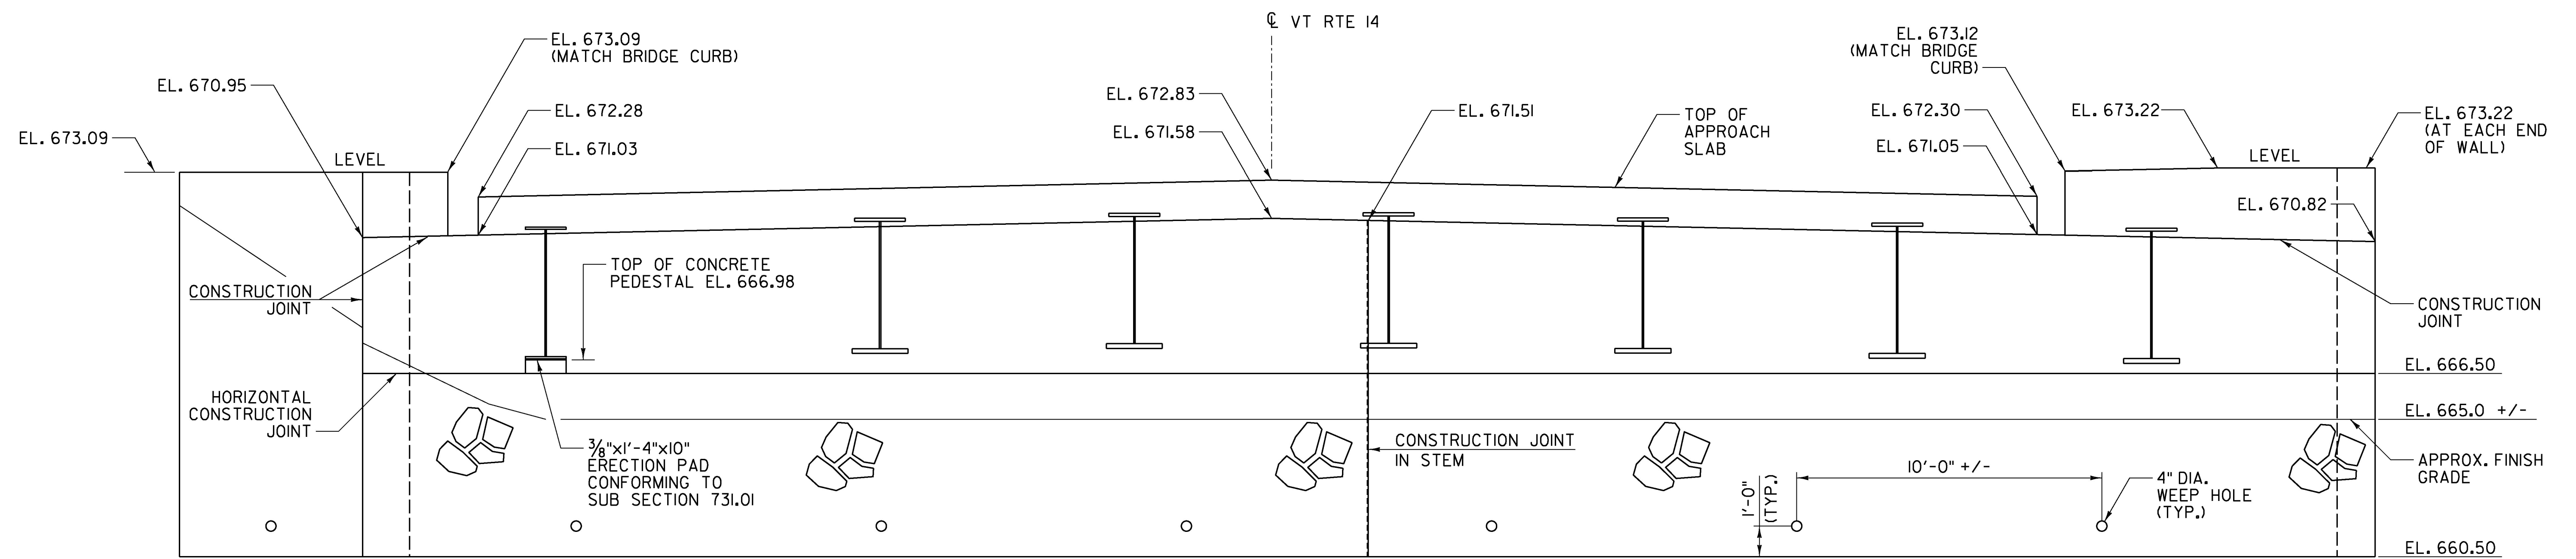

ABUTMENT NO. 2 ELEVATION
SCALE: 3/8" = 1'-0"

NOTE:

1. SEE ABUTMENT NO. 1 PLAN AND ELEVATION SHEET FOR ABUTMENT NOTE.



PROJECT NAME:	EAST MONTPELIER	FILE NAME:	z98b252abuts.dgn	PLOT DATE:	2/17/2017
PROJECT NUMBER:	BRF 037-1(7)	PROJECT LEADER:	T. KNIGHT	DRAWN BY:	J. SOTER
		DESIGNED BY:	T. KNIGHT	CHECKED BY:	P. GREENBERG
		ABUTMENT NO. 2 PLAN AND ELEVATION			SHEET 90 OF 158