

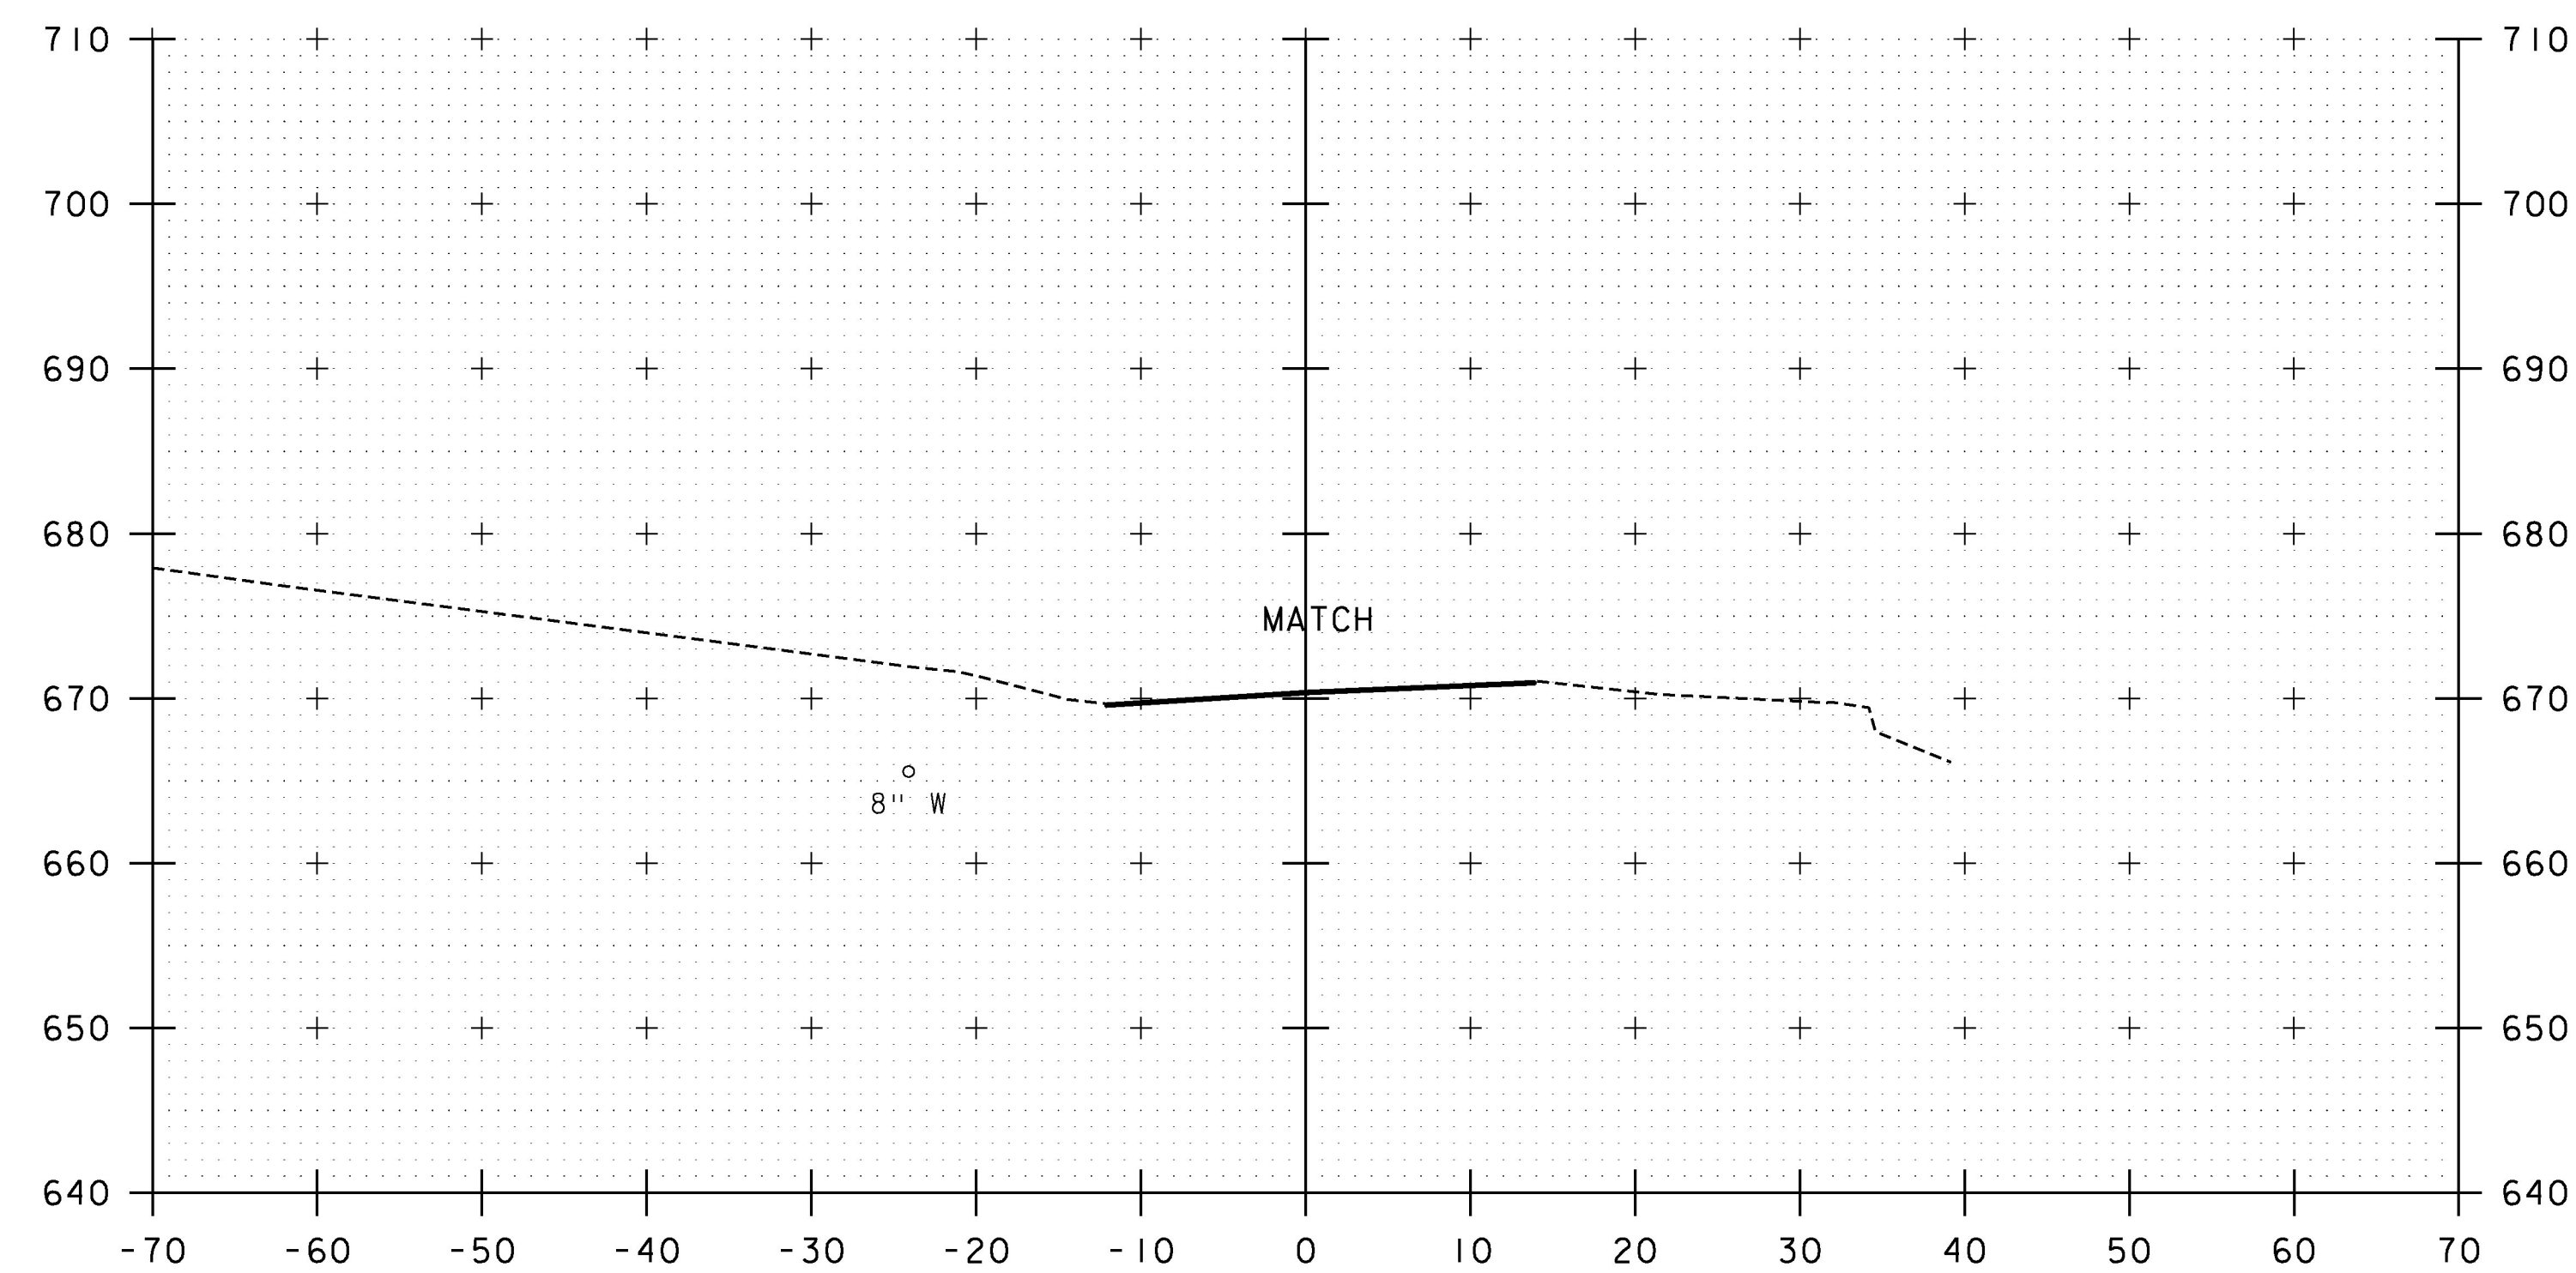


141+50

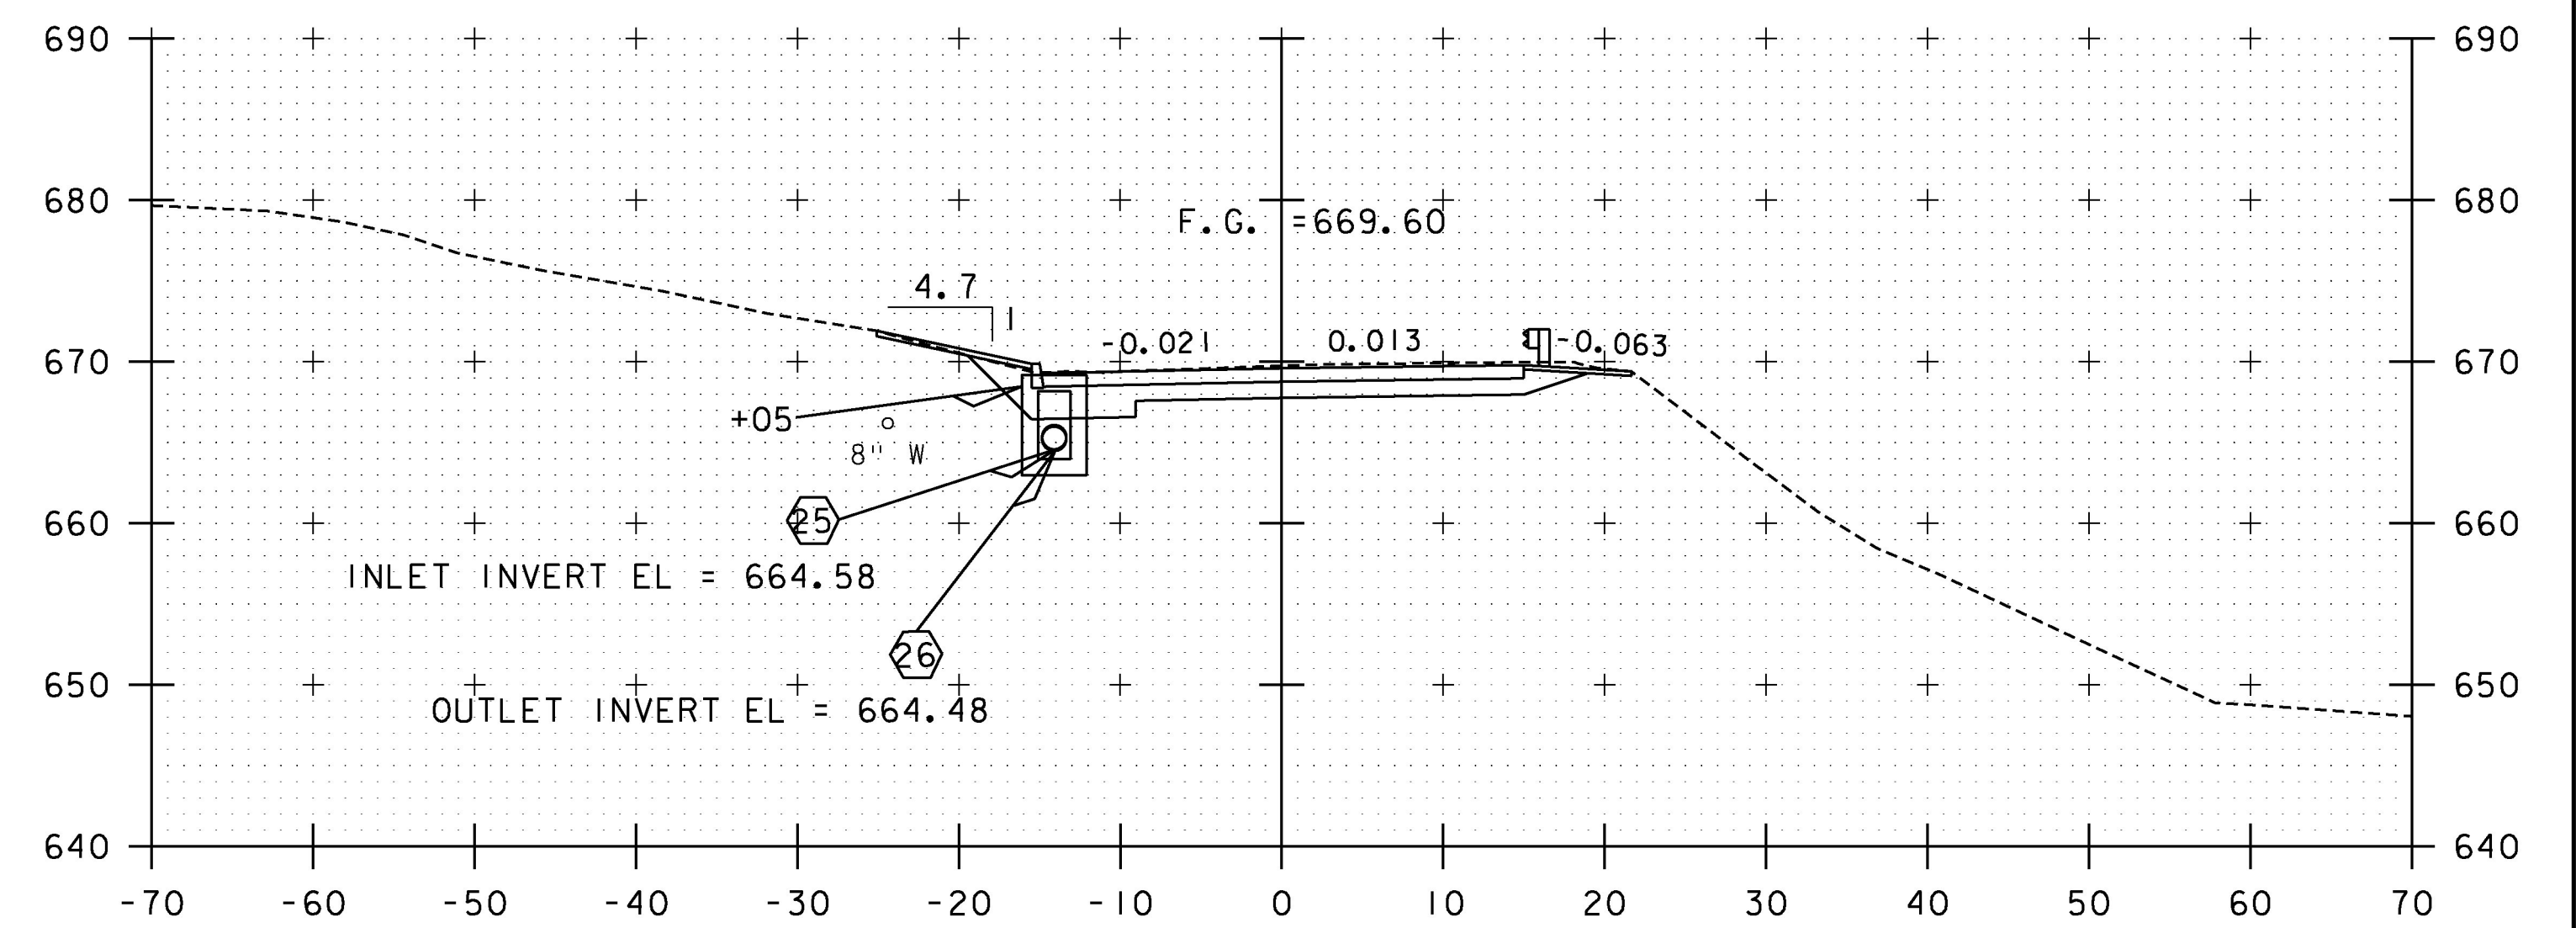


141+00
BEGIN APPROACH

NOTE:
DRAINAGE STRUCTURES AND TRANSVERSE PIPES ARE
PROJECTED TO THE NEAREST CROSS SECTION AND DRAWN AT
TRUE ELEVATION RELATIVE TO THE GRID AND AXIS, NOT
RELATIVE TO THE ROADWAY SURFACE ON THE CROSS SECTION.

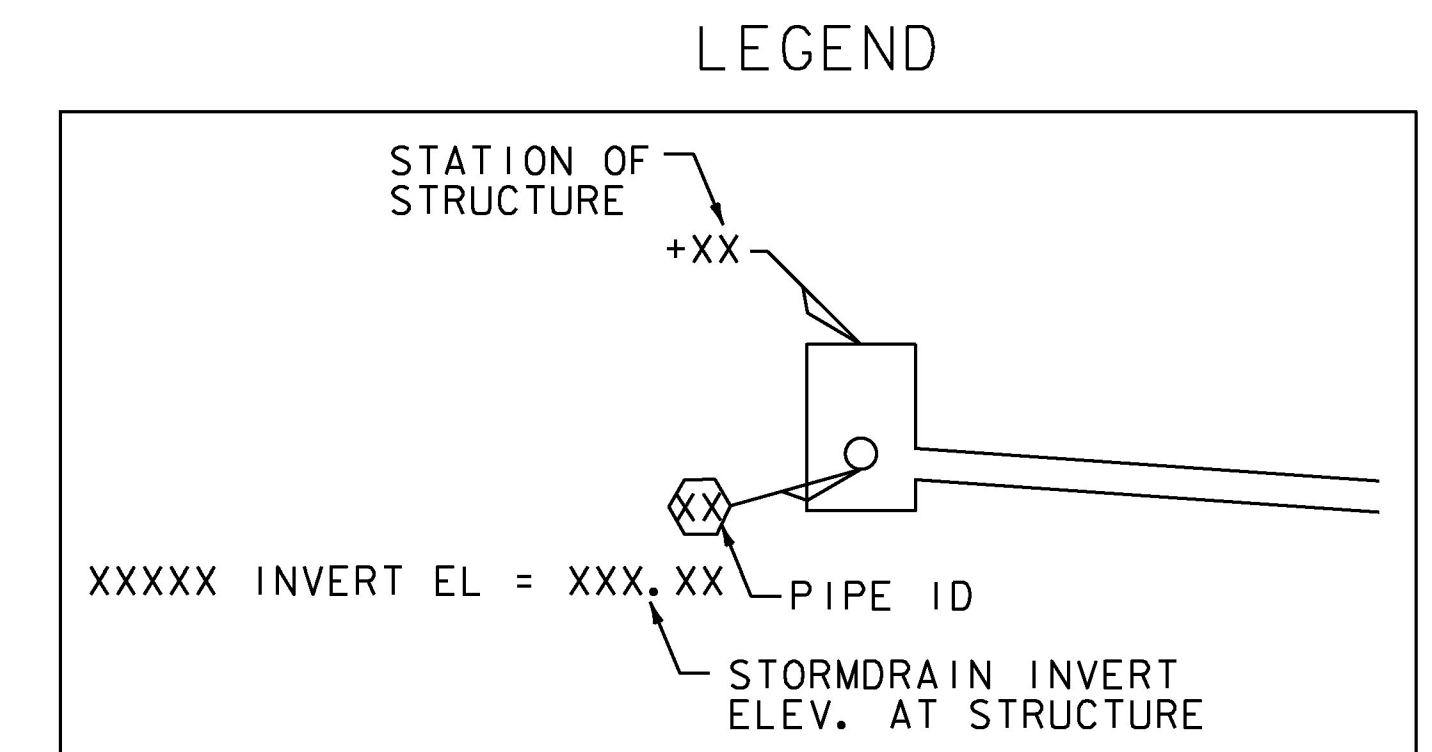

142+00

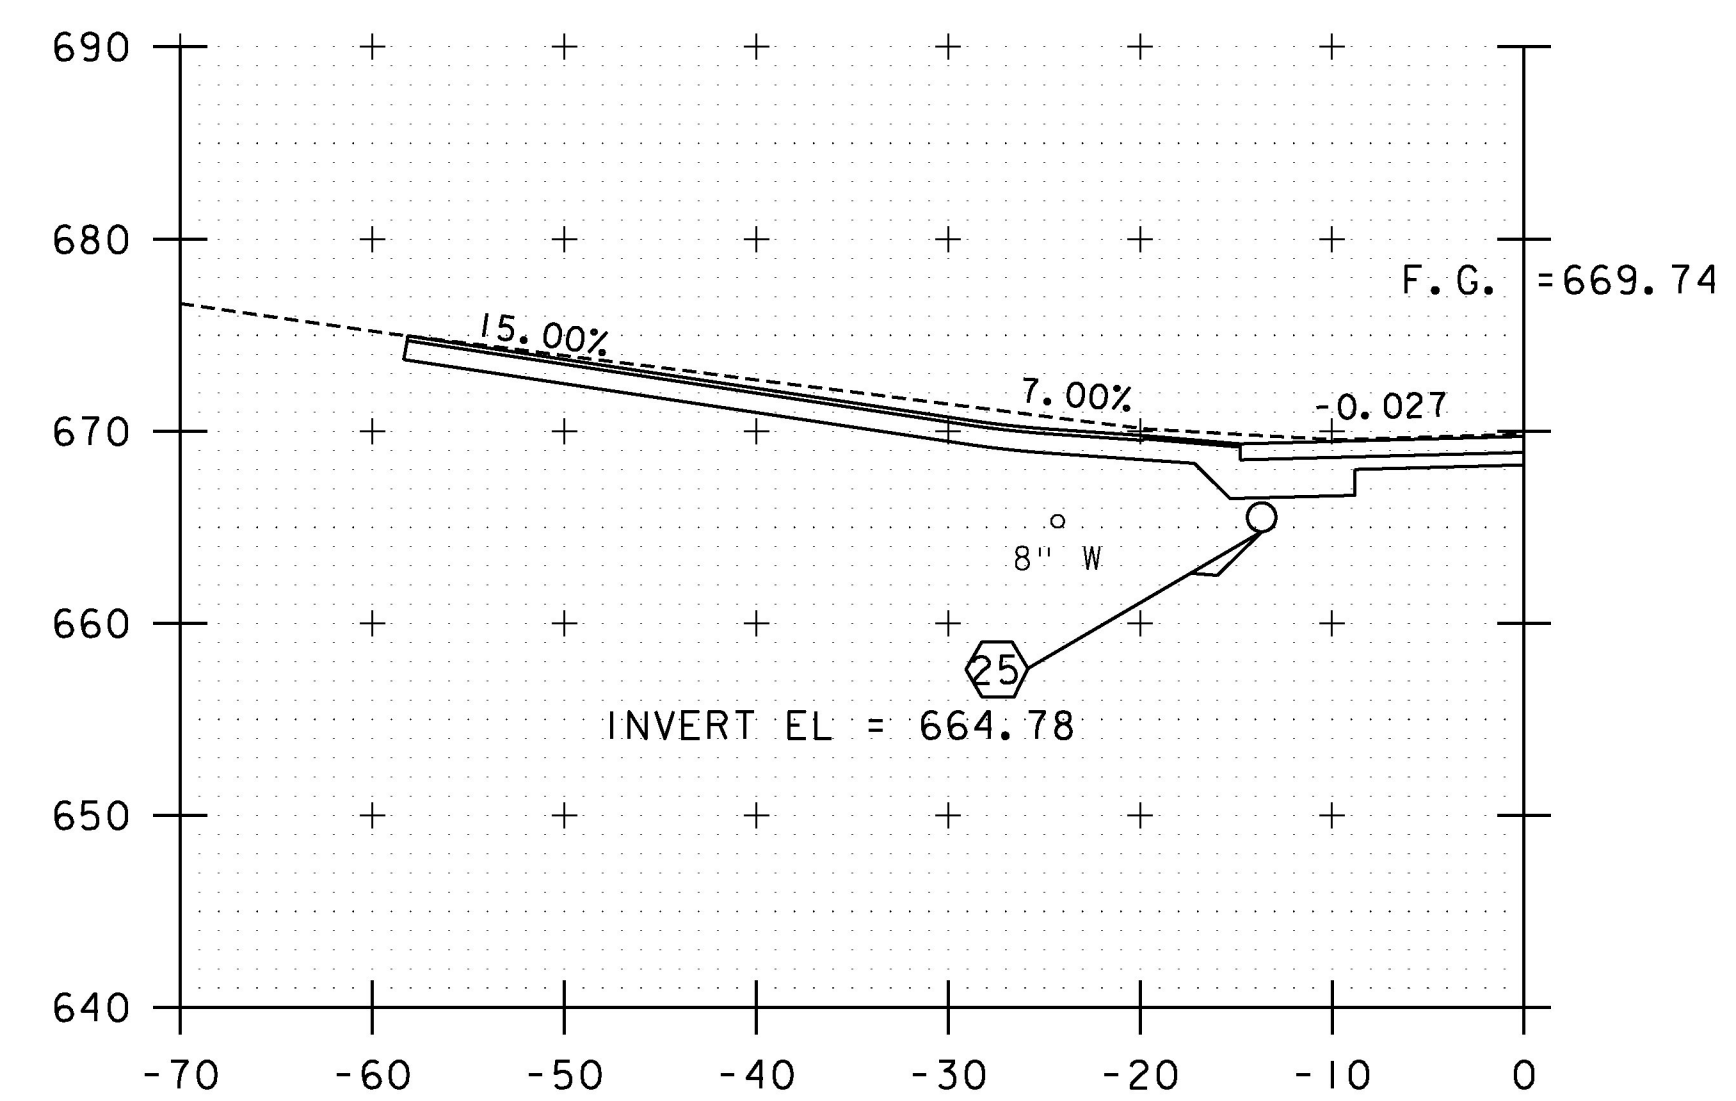


141+83
(DRIVE LEFT)

PROJECT NAME: EAST MONTPELIER
PROJECT NUMBER: BRF 037-(17)

FILE NAME: 32_Cross Sections.dgn
PROJECT LEADER: T. KNIGHT
DESIGNED BY: C. GENDRON
US 2 CROSS SECTIONS UXS-1

PLOT DATE: 2/17/2017
DRAWN BY: C. GENDRON
CHECKED BY: K. RICHARDSON
SHEET 102 OF 158

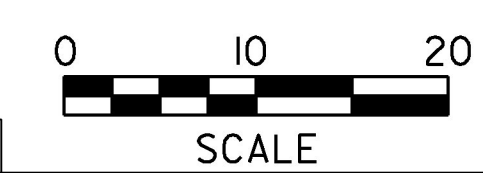

STA. 141+00 TO STA. 142+00