



148+00

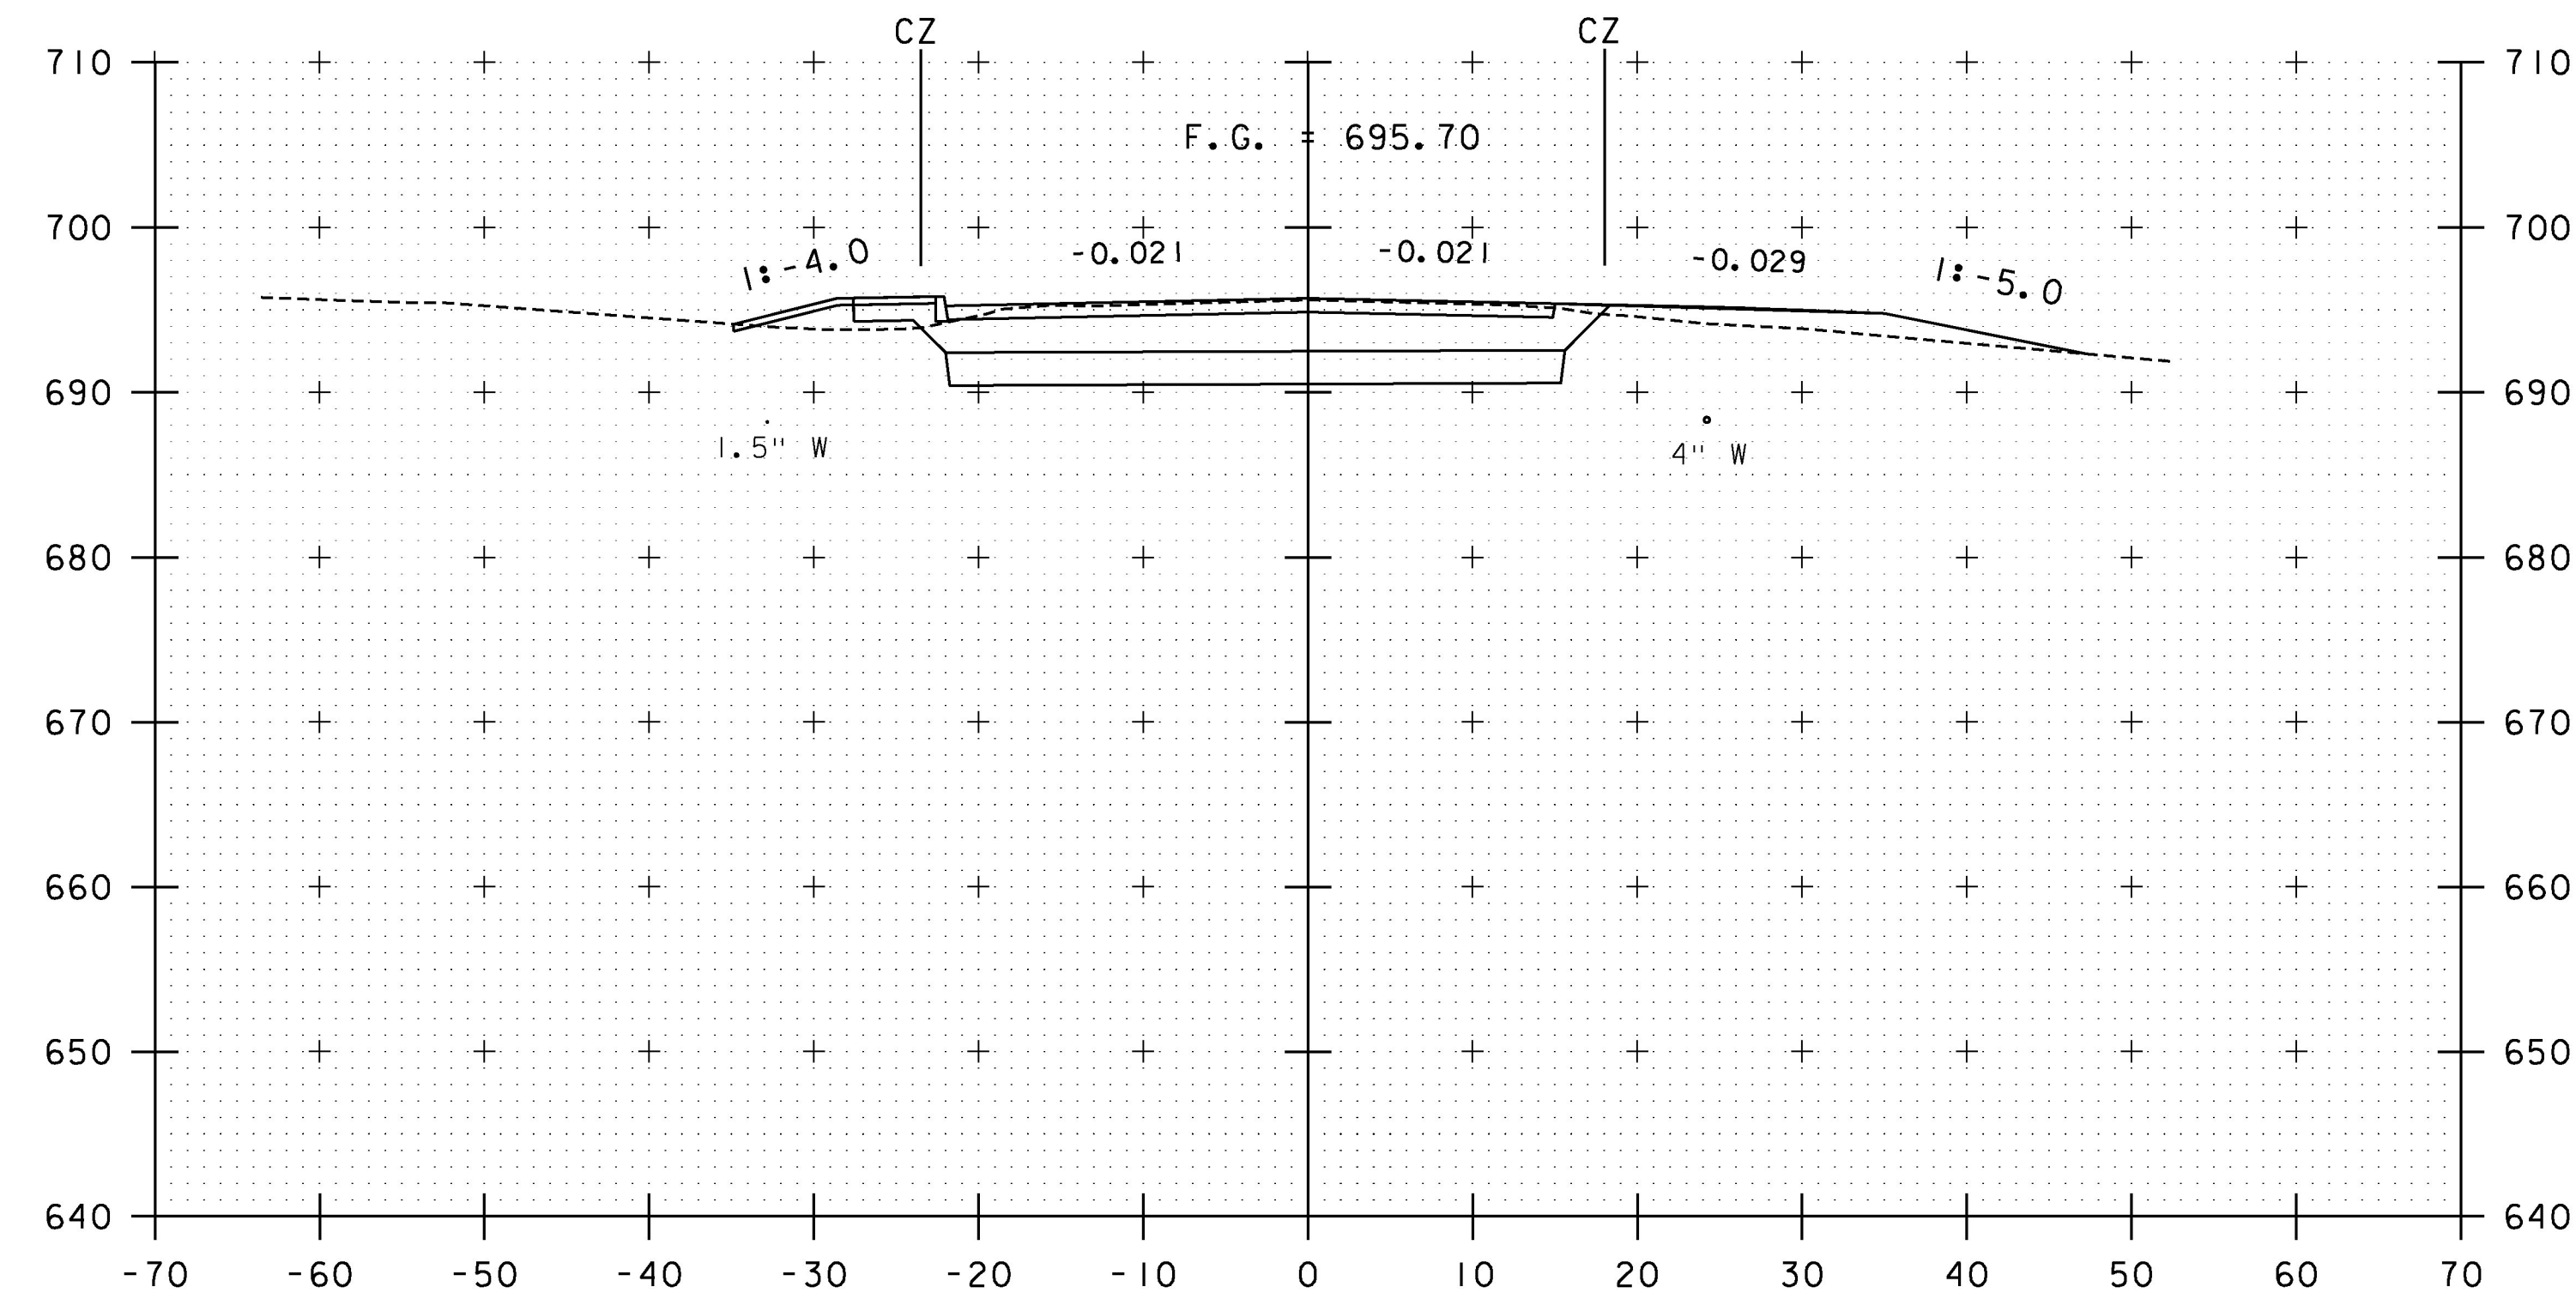


148+50

END PROJECT/BEGIN APPROACH

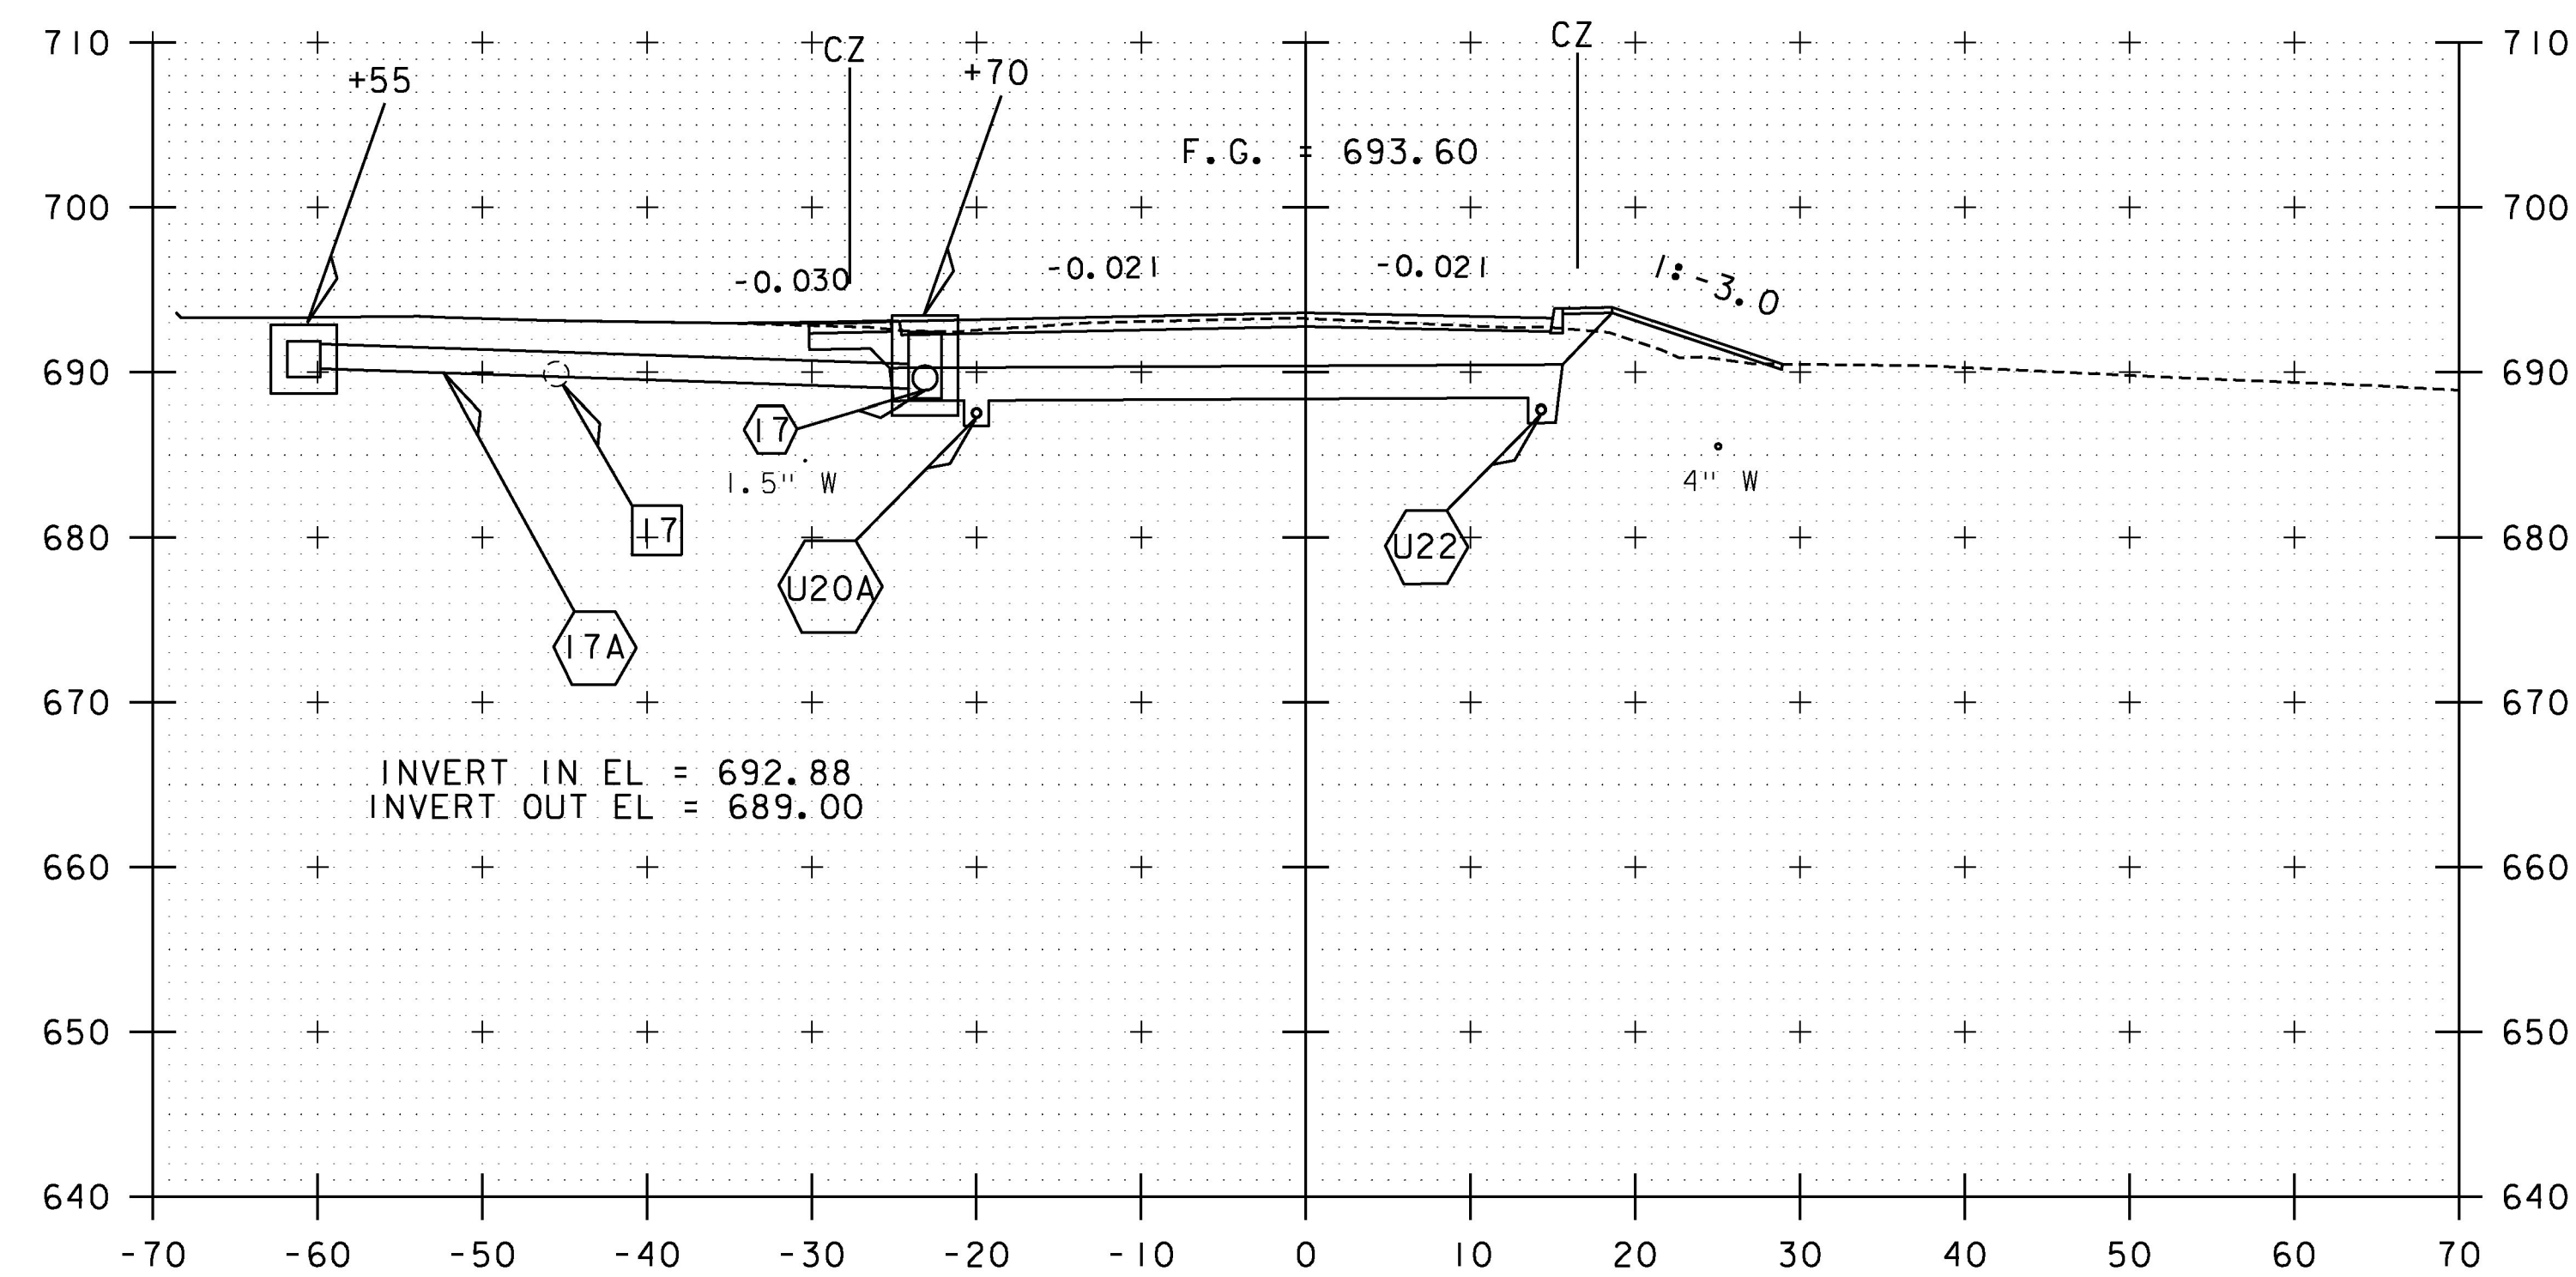


147+50

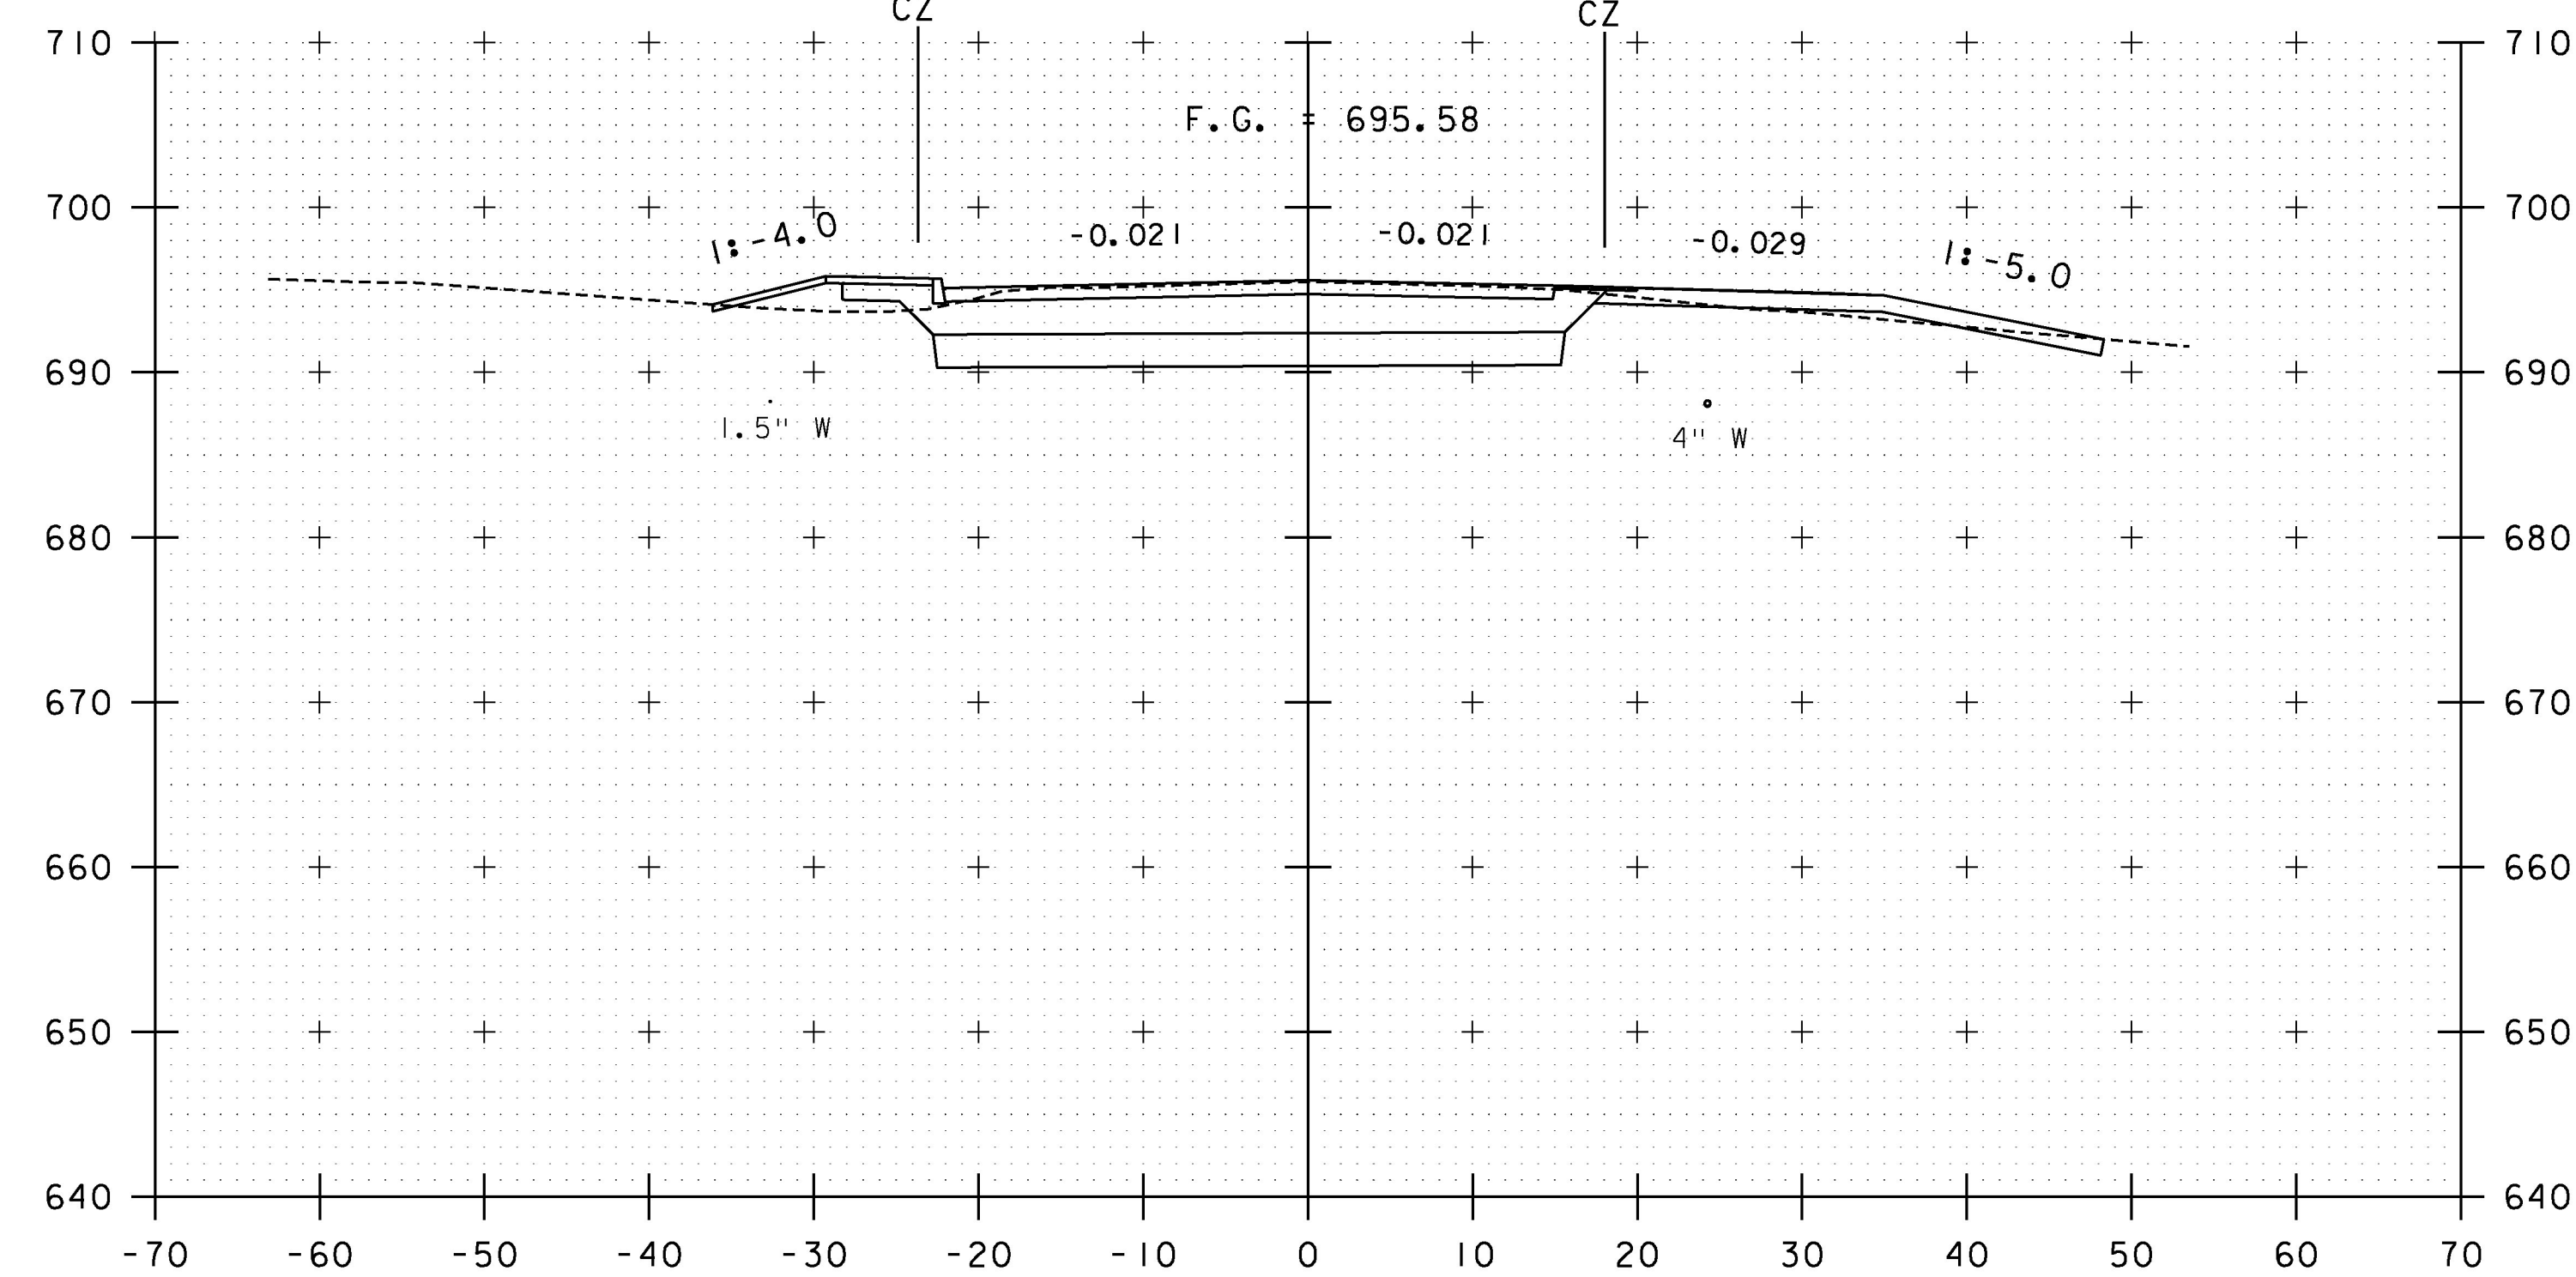

148+44

(DRIVE RIGHT)

PROJECT NAME:	EAST MONTPELIER
PROJECT NUMBER:	BRF 037-(17)
FILE NAME:	32_Cross Sections.dgn
PROJECT LEADER:	T. KNIGHT
DESIGNED BY:	C. GENDRON
US 2 CROSS SECTIONS UXS-6	
PLOT DATE:	2/17/2017
DRAWN BY:	C. GENDRON
CHECKED BY:	K. RICHARDSON
SHEET	107 OF 158

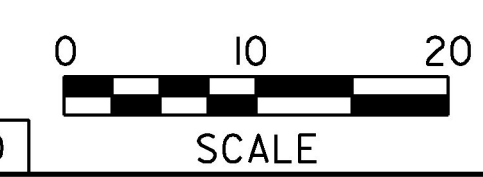

STA. 147+50 TO STA. 148+50