




126+00

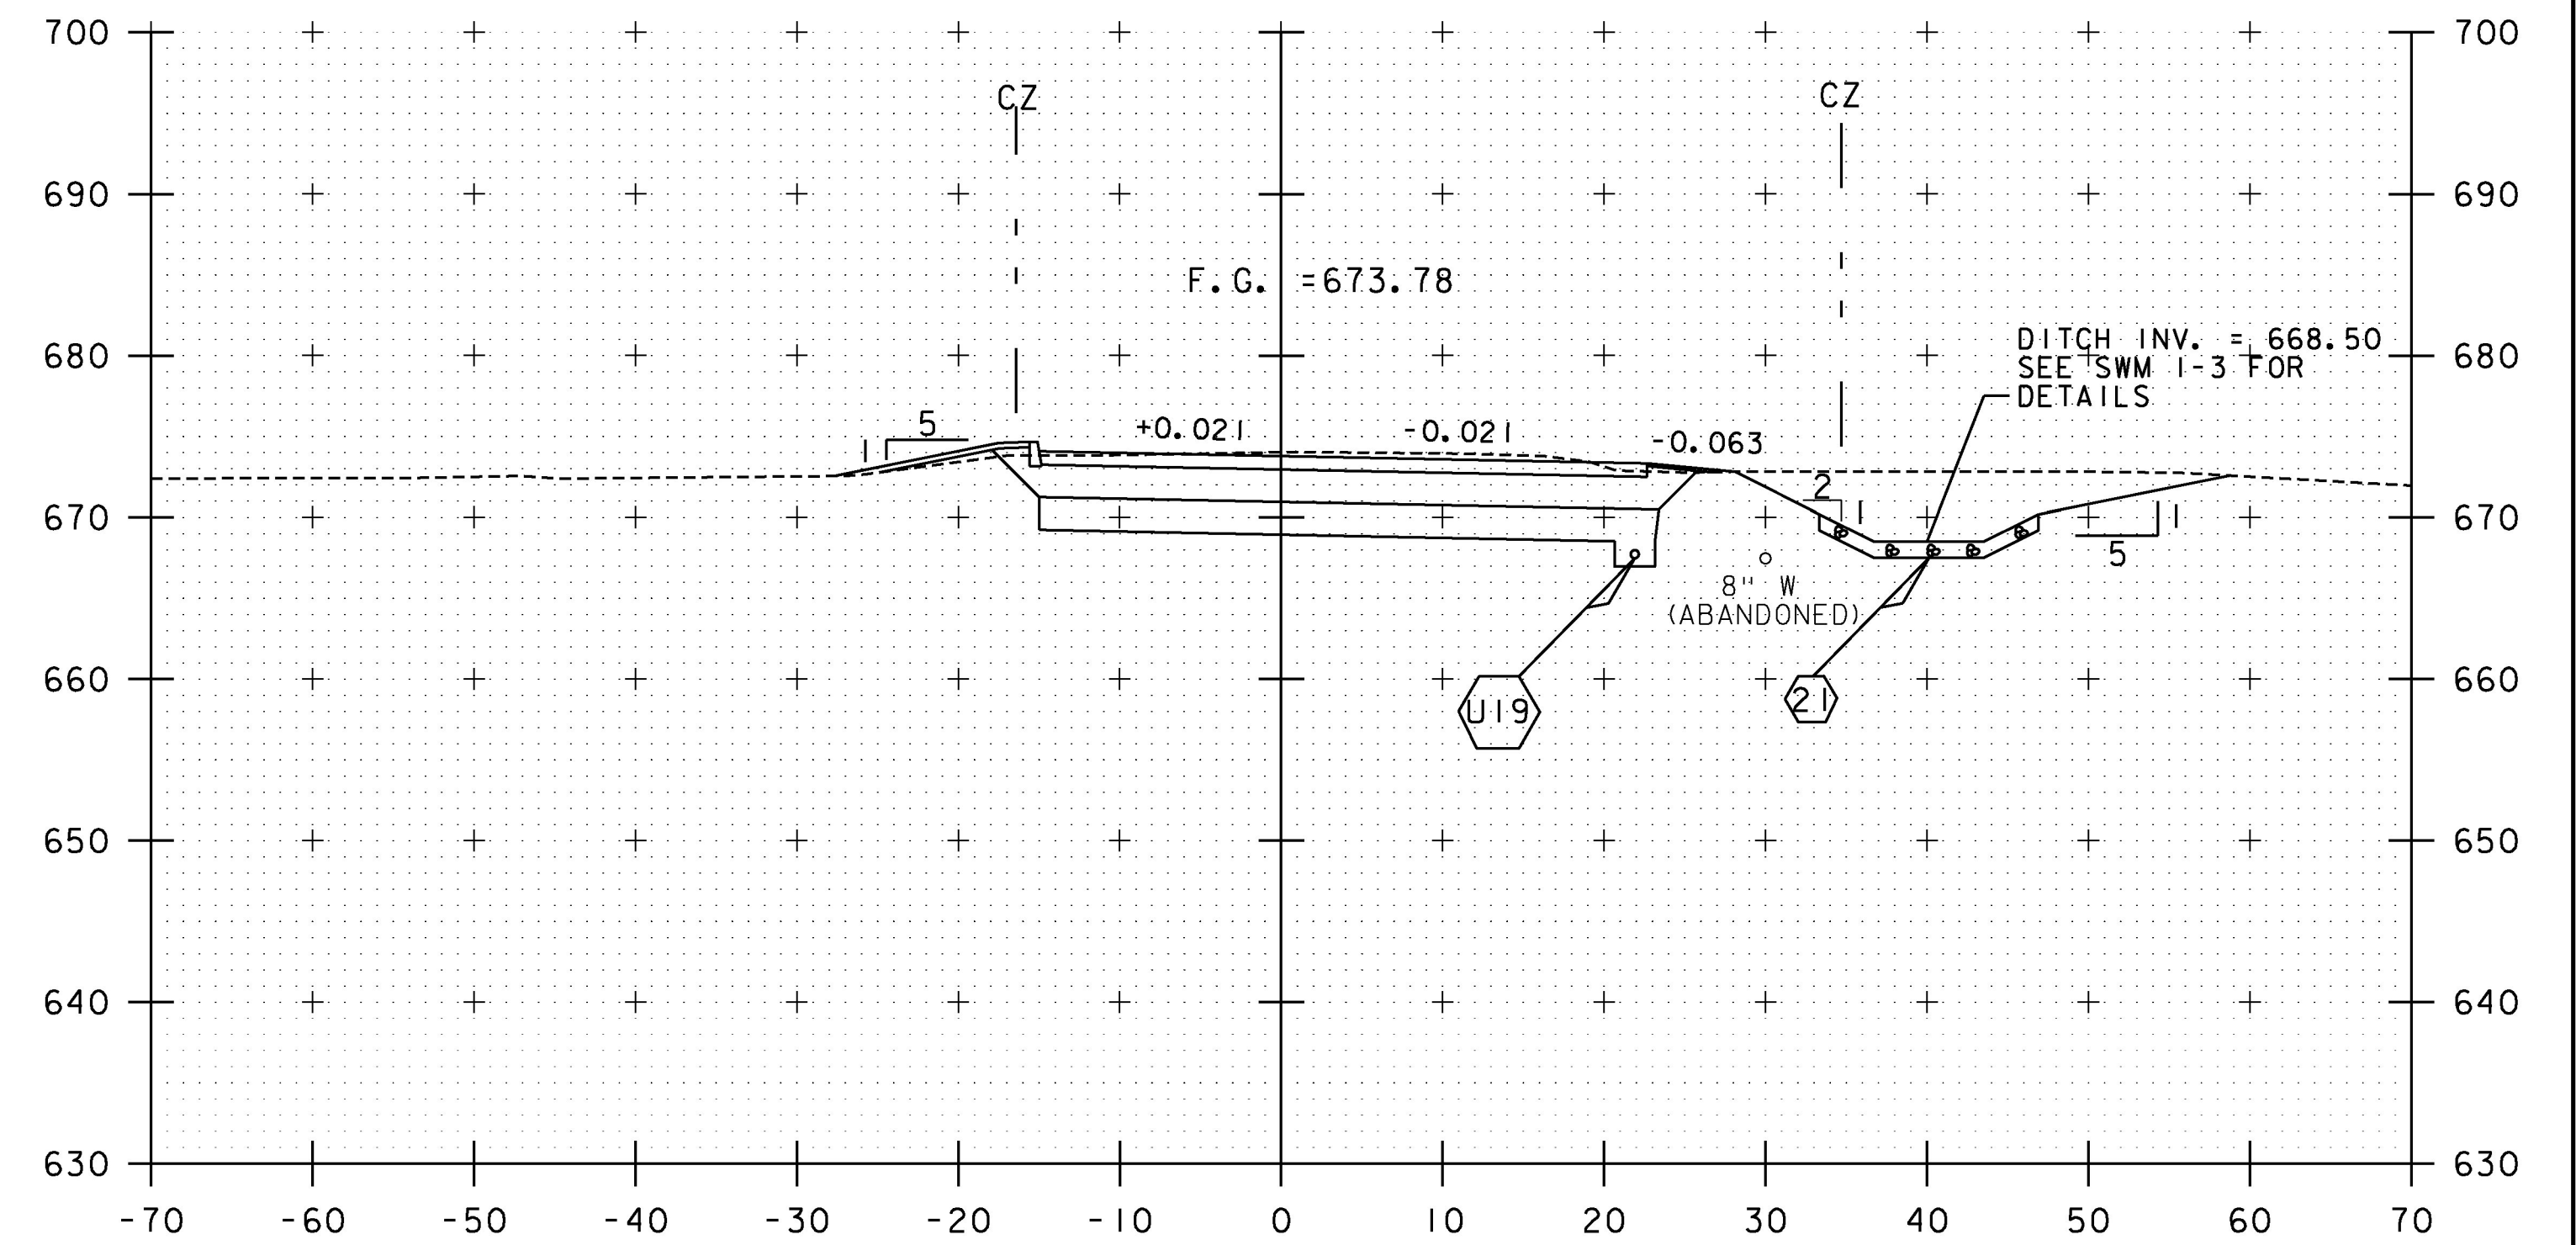


126+50

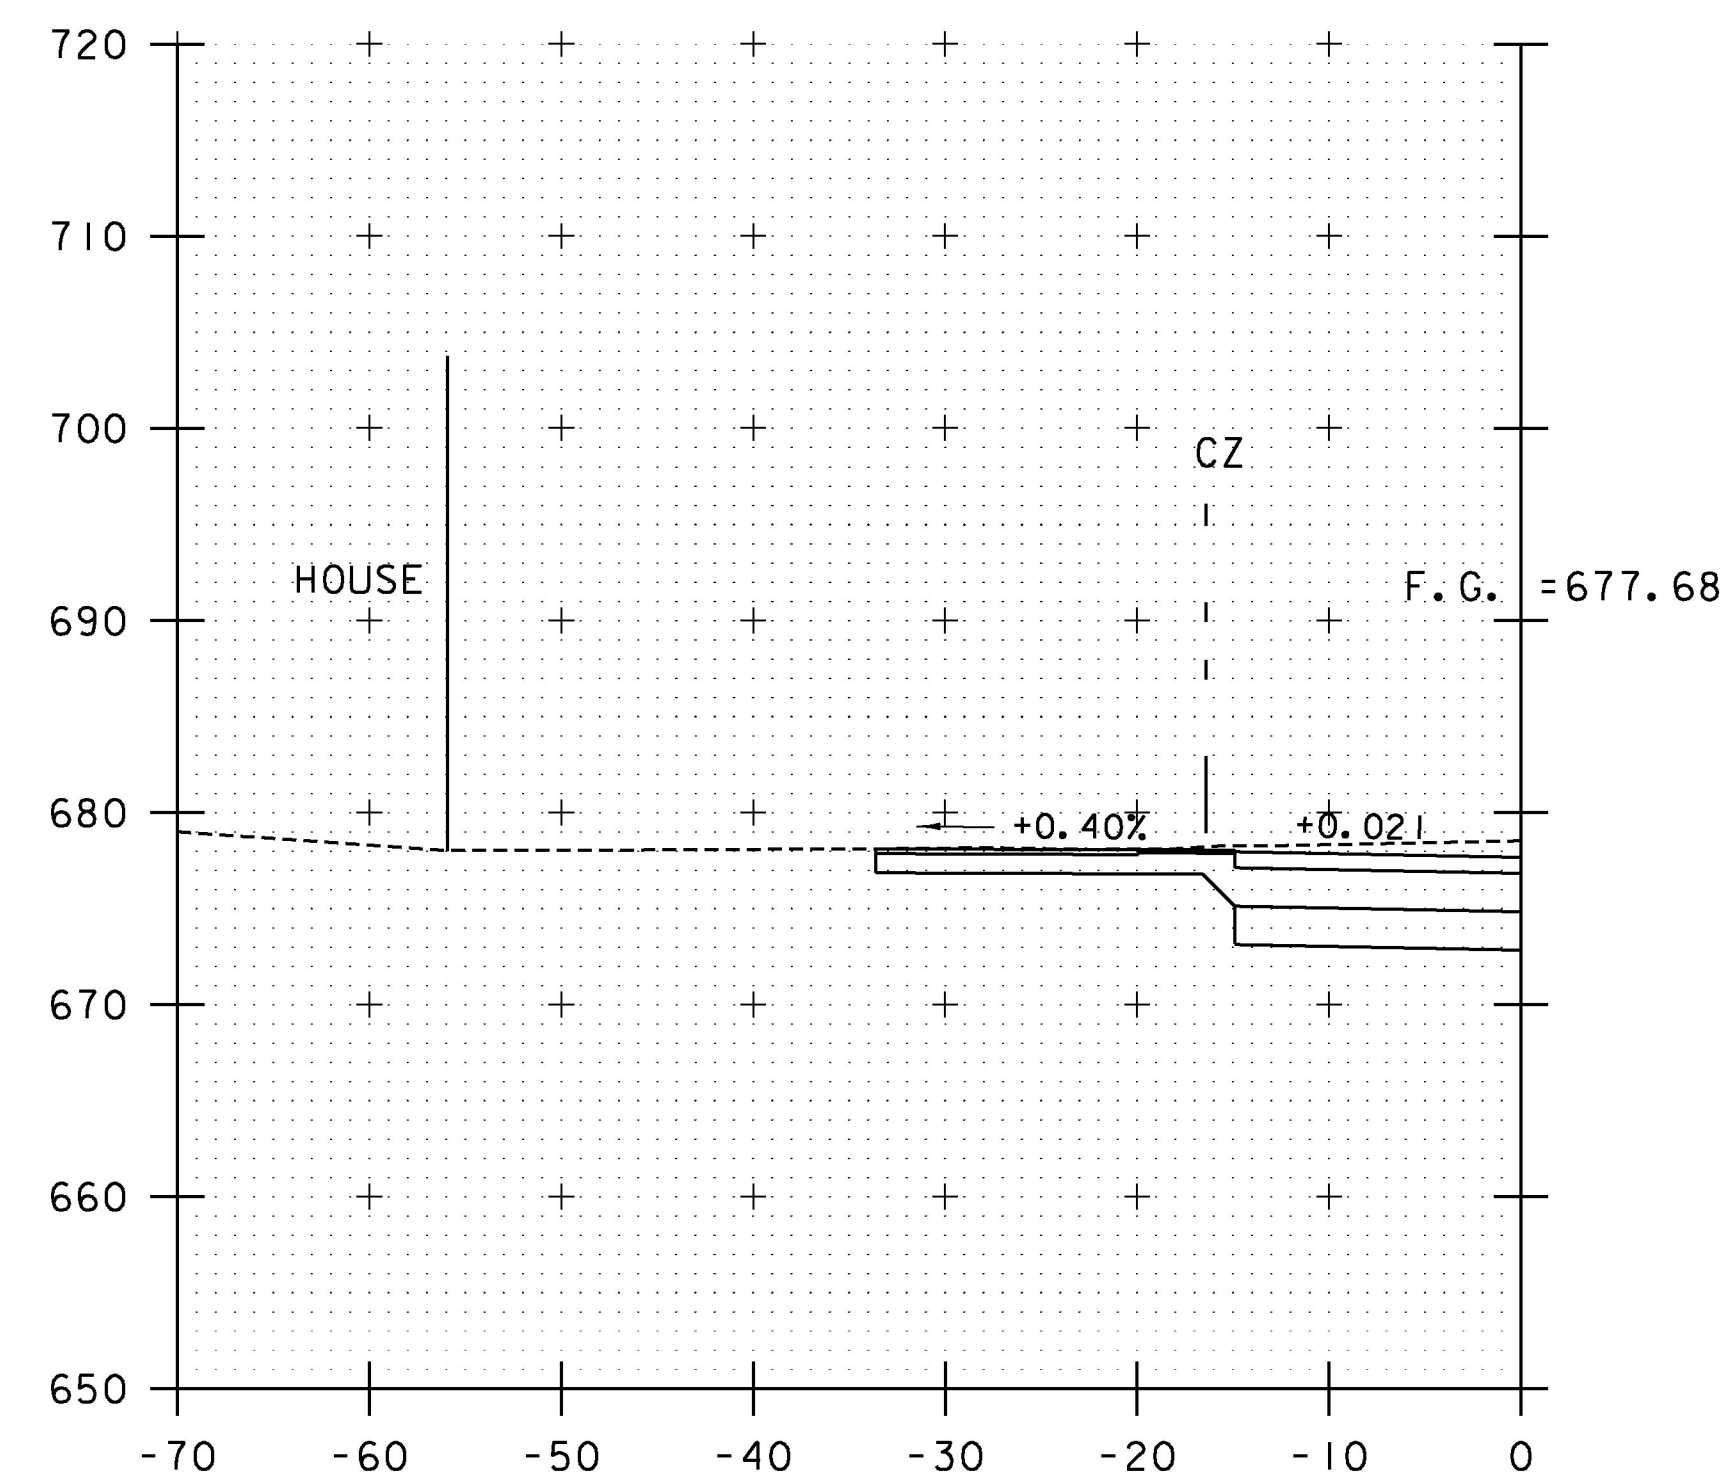

125+62
(DRIVE LEFT)

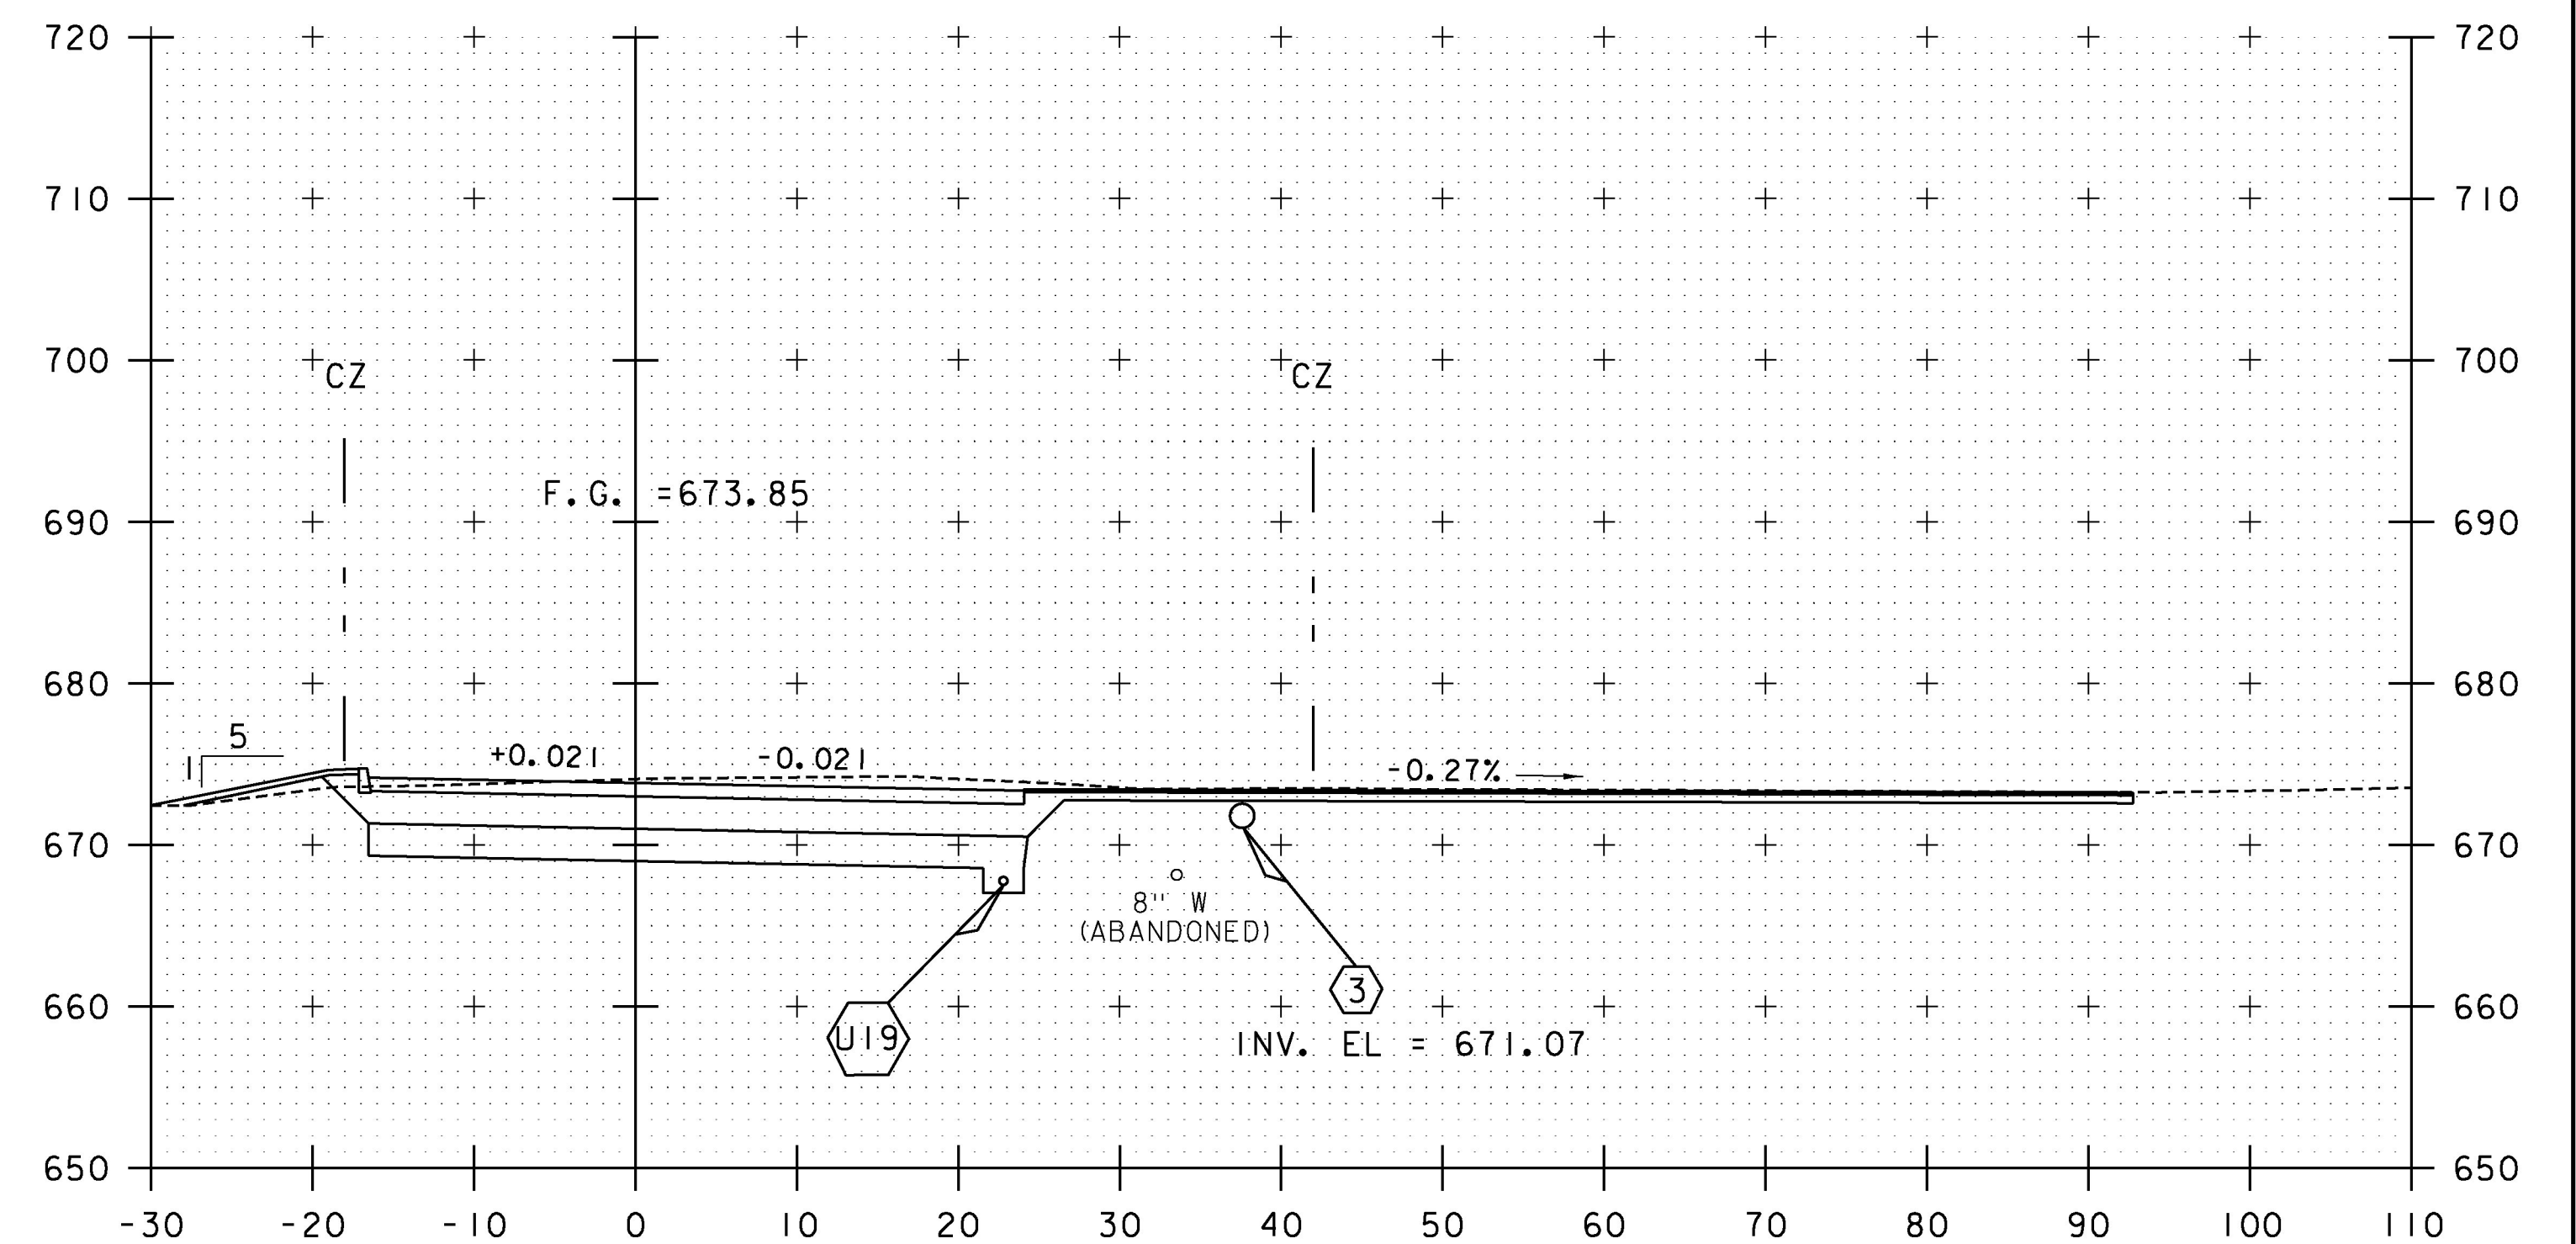

126+48
(DRIVE RIGHT-SKEWED SECTION @ 115° RT)

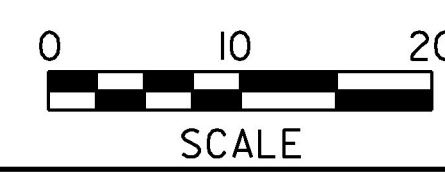

PROJECT NAME:	EAST MONTPELIER	PLOT DATE:	2/17/2017
PROJECT NUMBER:	BRF 037-(17)	DRAWN BY:	C. GENDRON
FILE NAME:	32_Cross Sections.dgn	DESIGNED BY:	C. GENDRON
PROJECT LEADER:	T. KNIGHT	CHECKED BY:	K. RICHARDSON
VT RTE 14 CROSS SECTIONS VXS-3			SHEET III OF 158