


STA. 126+87 TO STA. 128+00

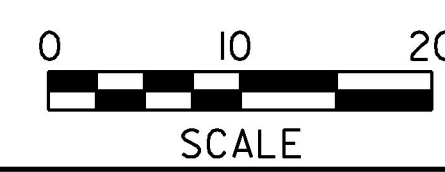

PROJECT NAME:	EAST MONTPELIER
PROJECT NUMBER:	BRF 037-(17)
FILE NAME:	32_Cross Sections.dgn
PROJECT LEADER:	T. KNIGHT
DESIGNED BY:	C. GENDRON
VT RTE 14 CROSS SECTIONS VXS-4	
PLOT DATE:	2/17/2017
DRAWN BY:	C. GENDRON
CHECKED BY:	K. RICHARDSON
SHEET	112 OF 158