




129+00

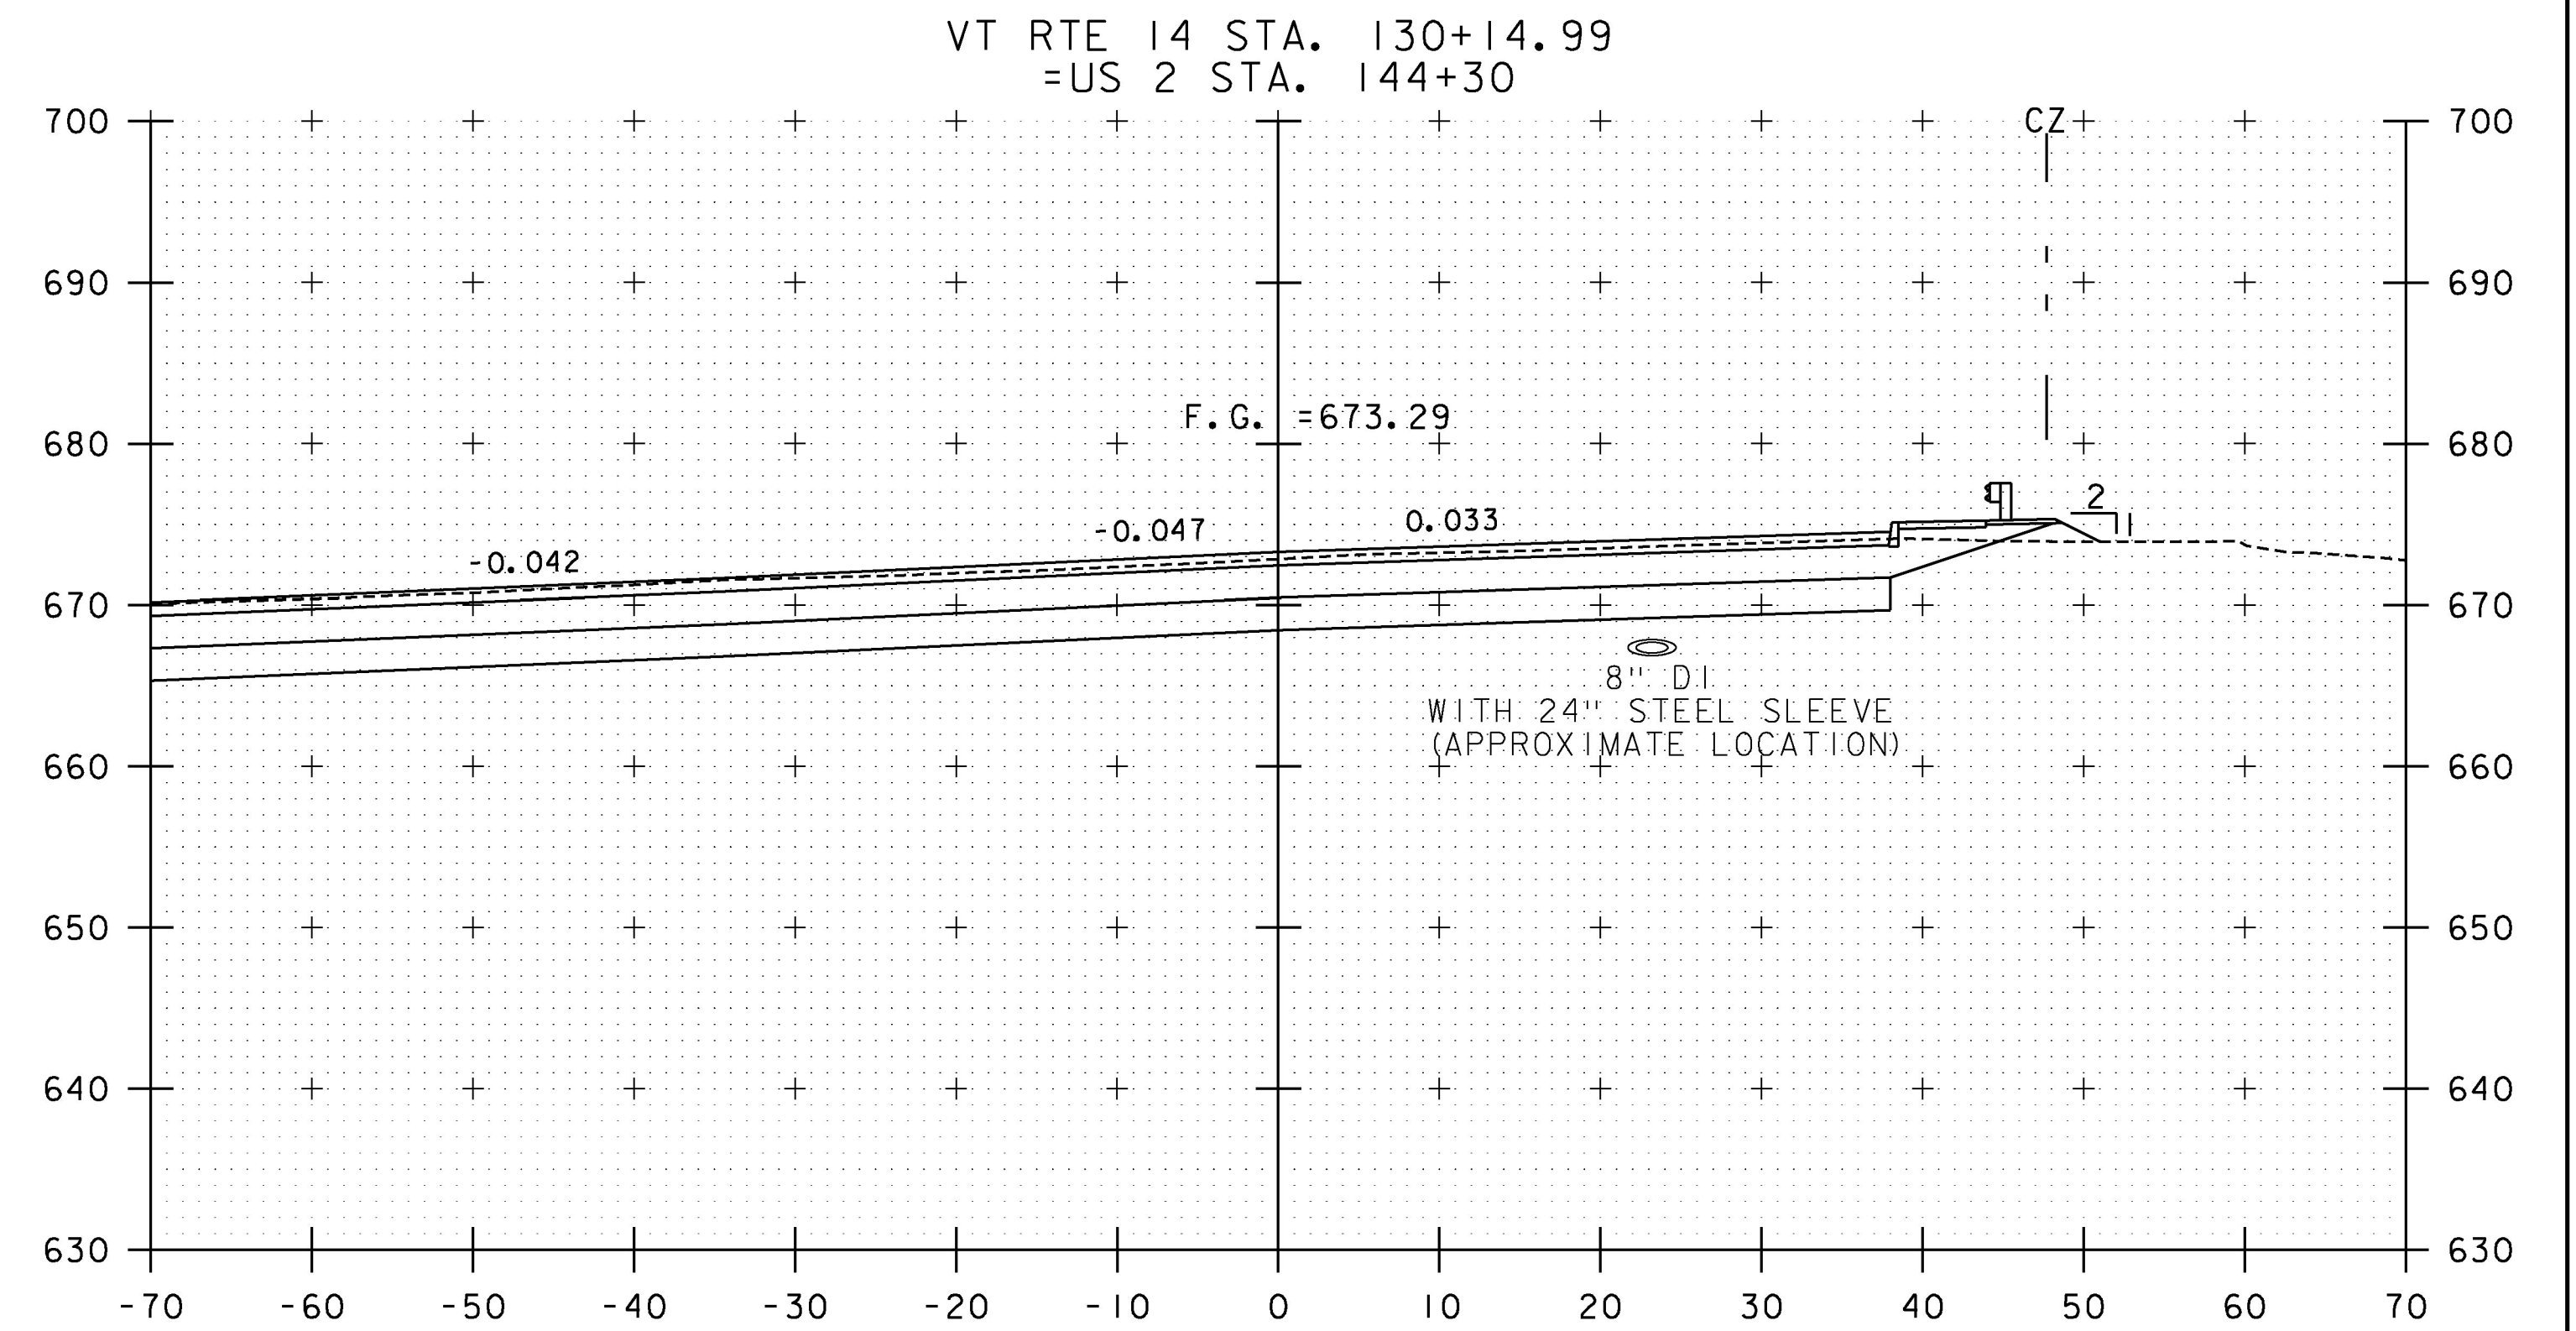

130+00
END BRIDGE
STA. 129+54.79

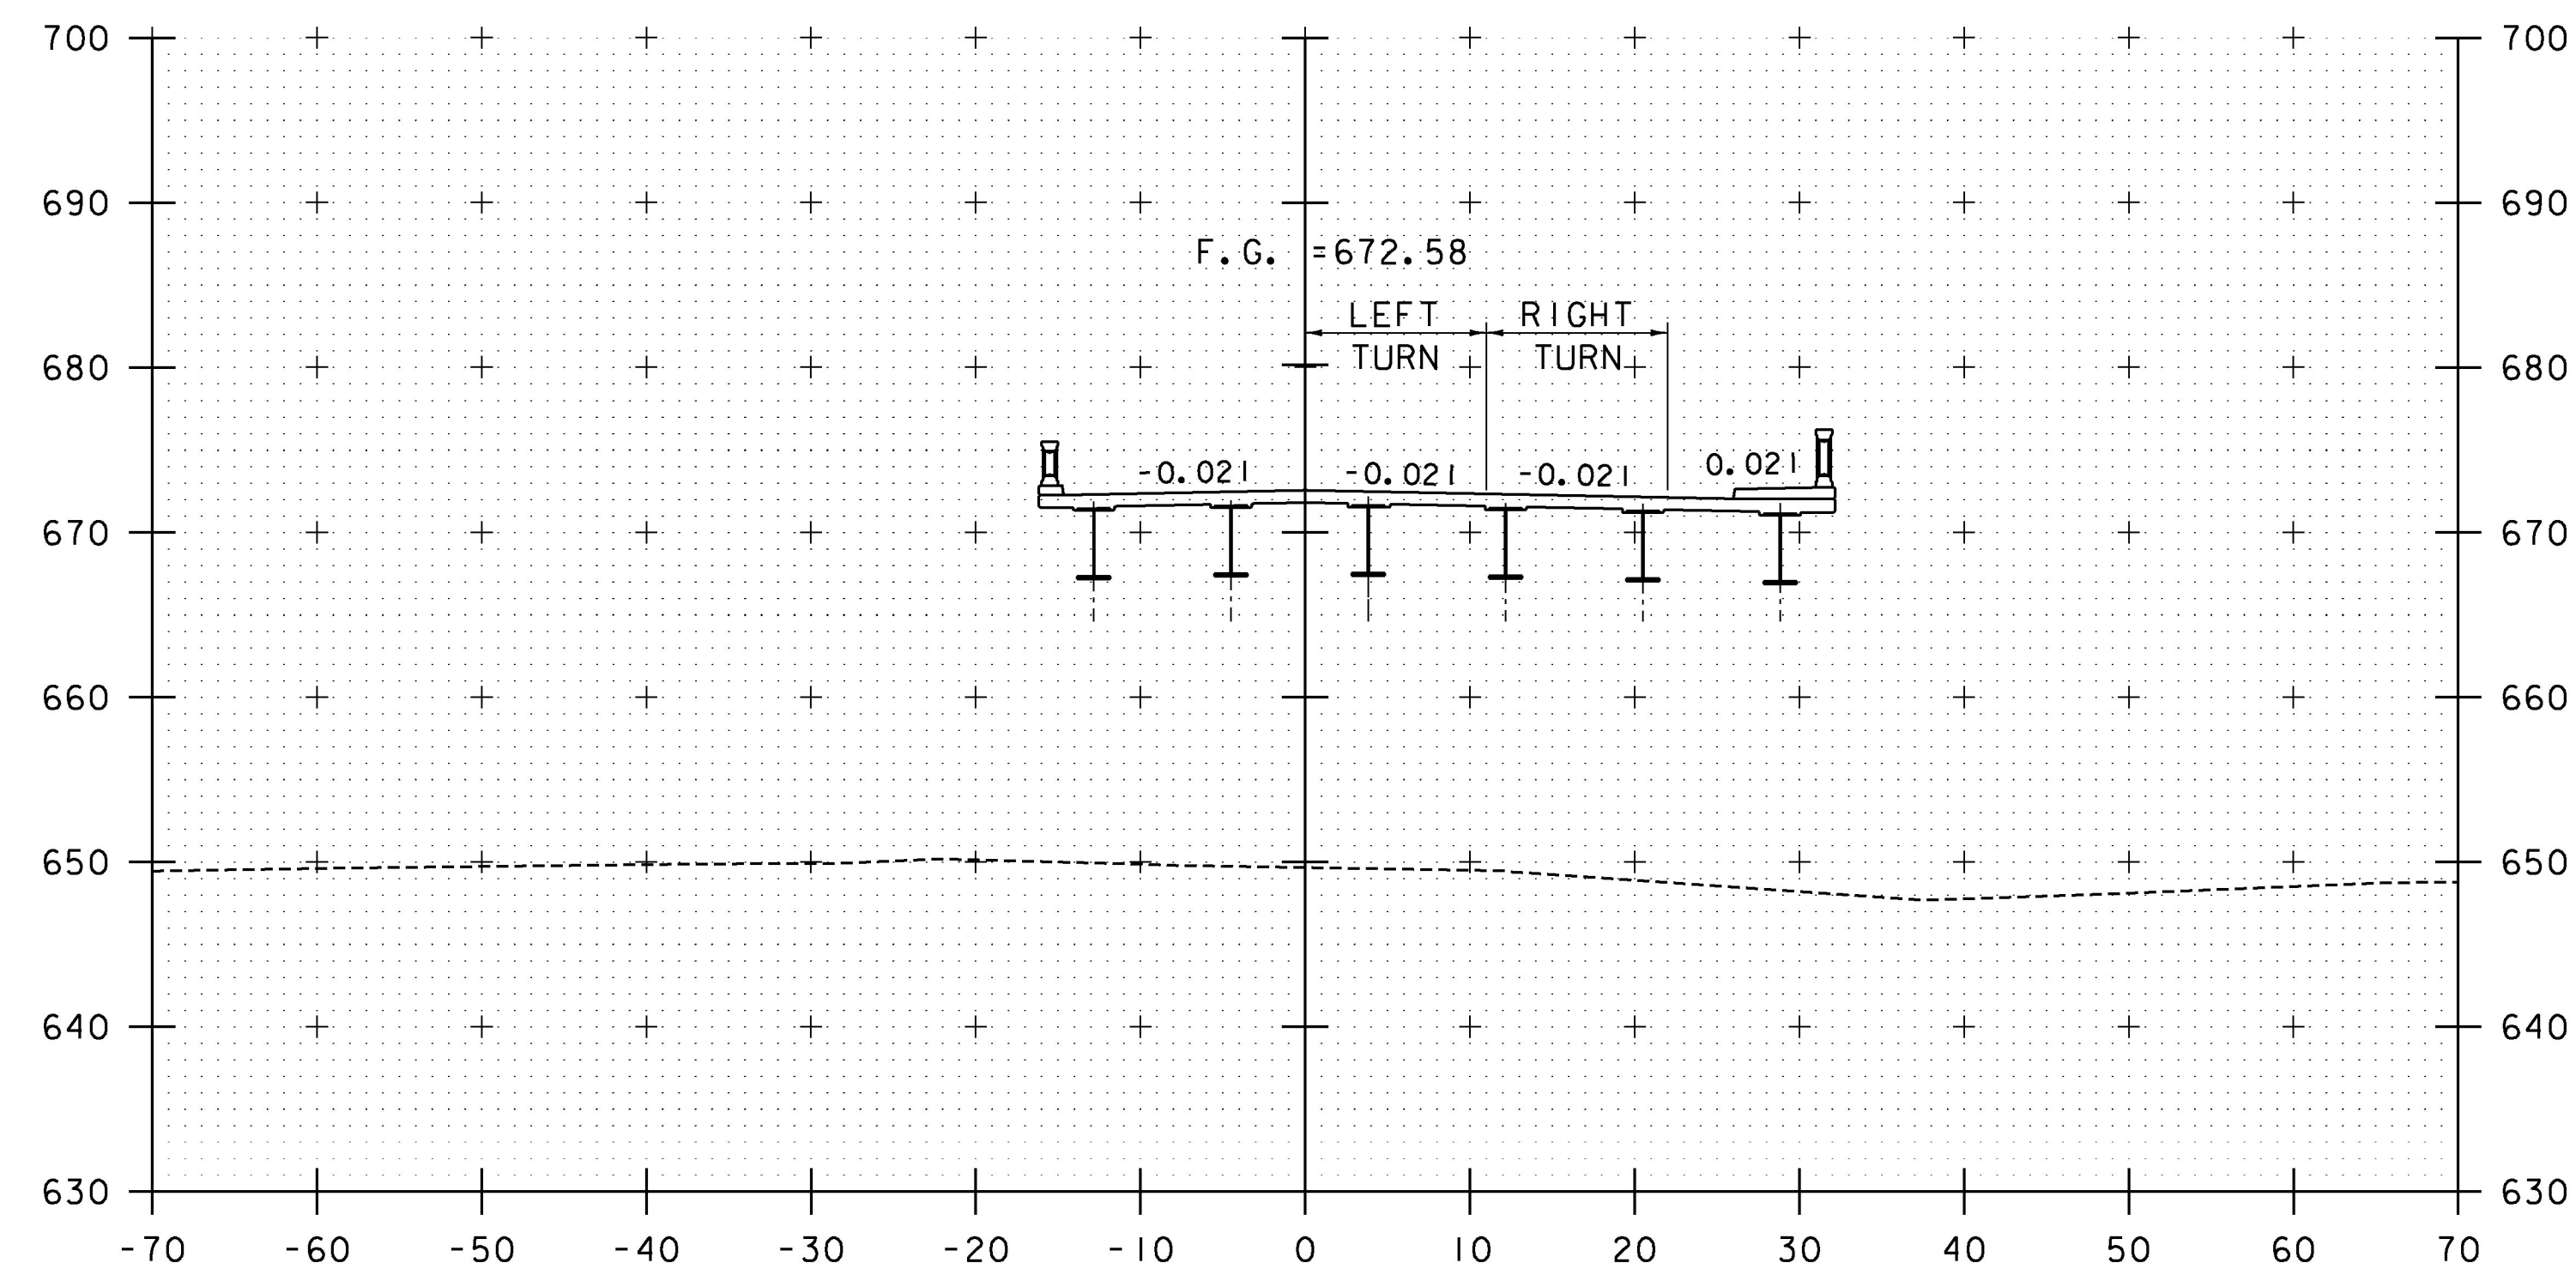


128+50

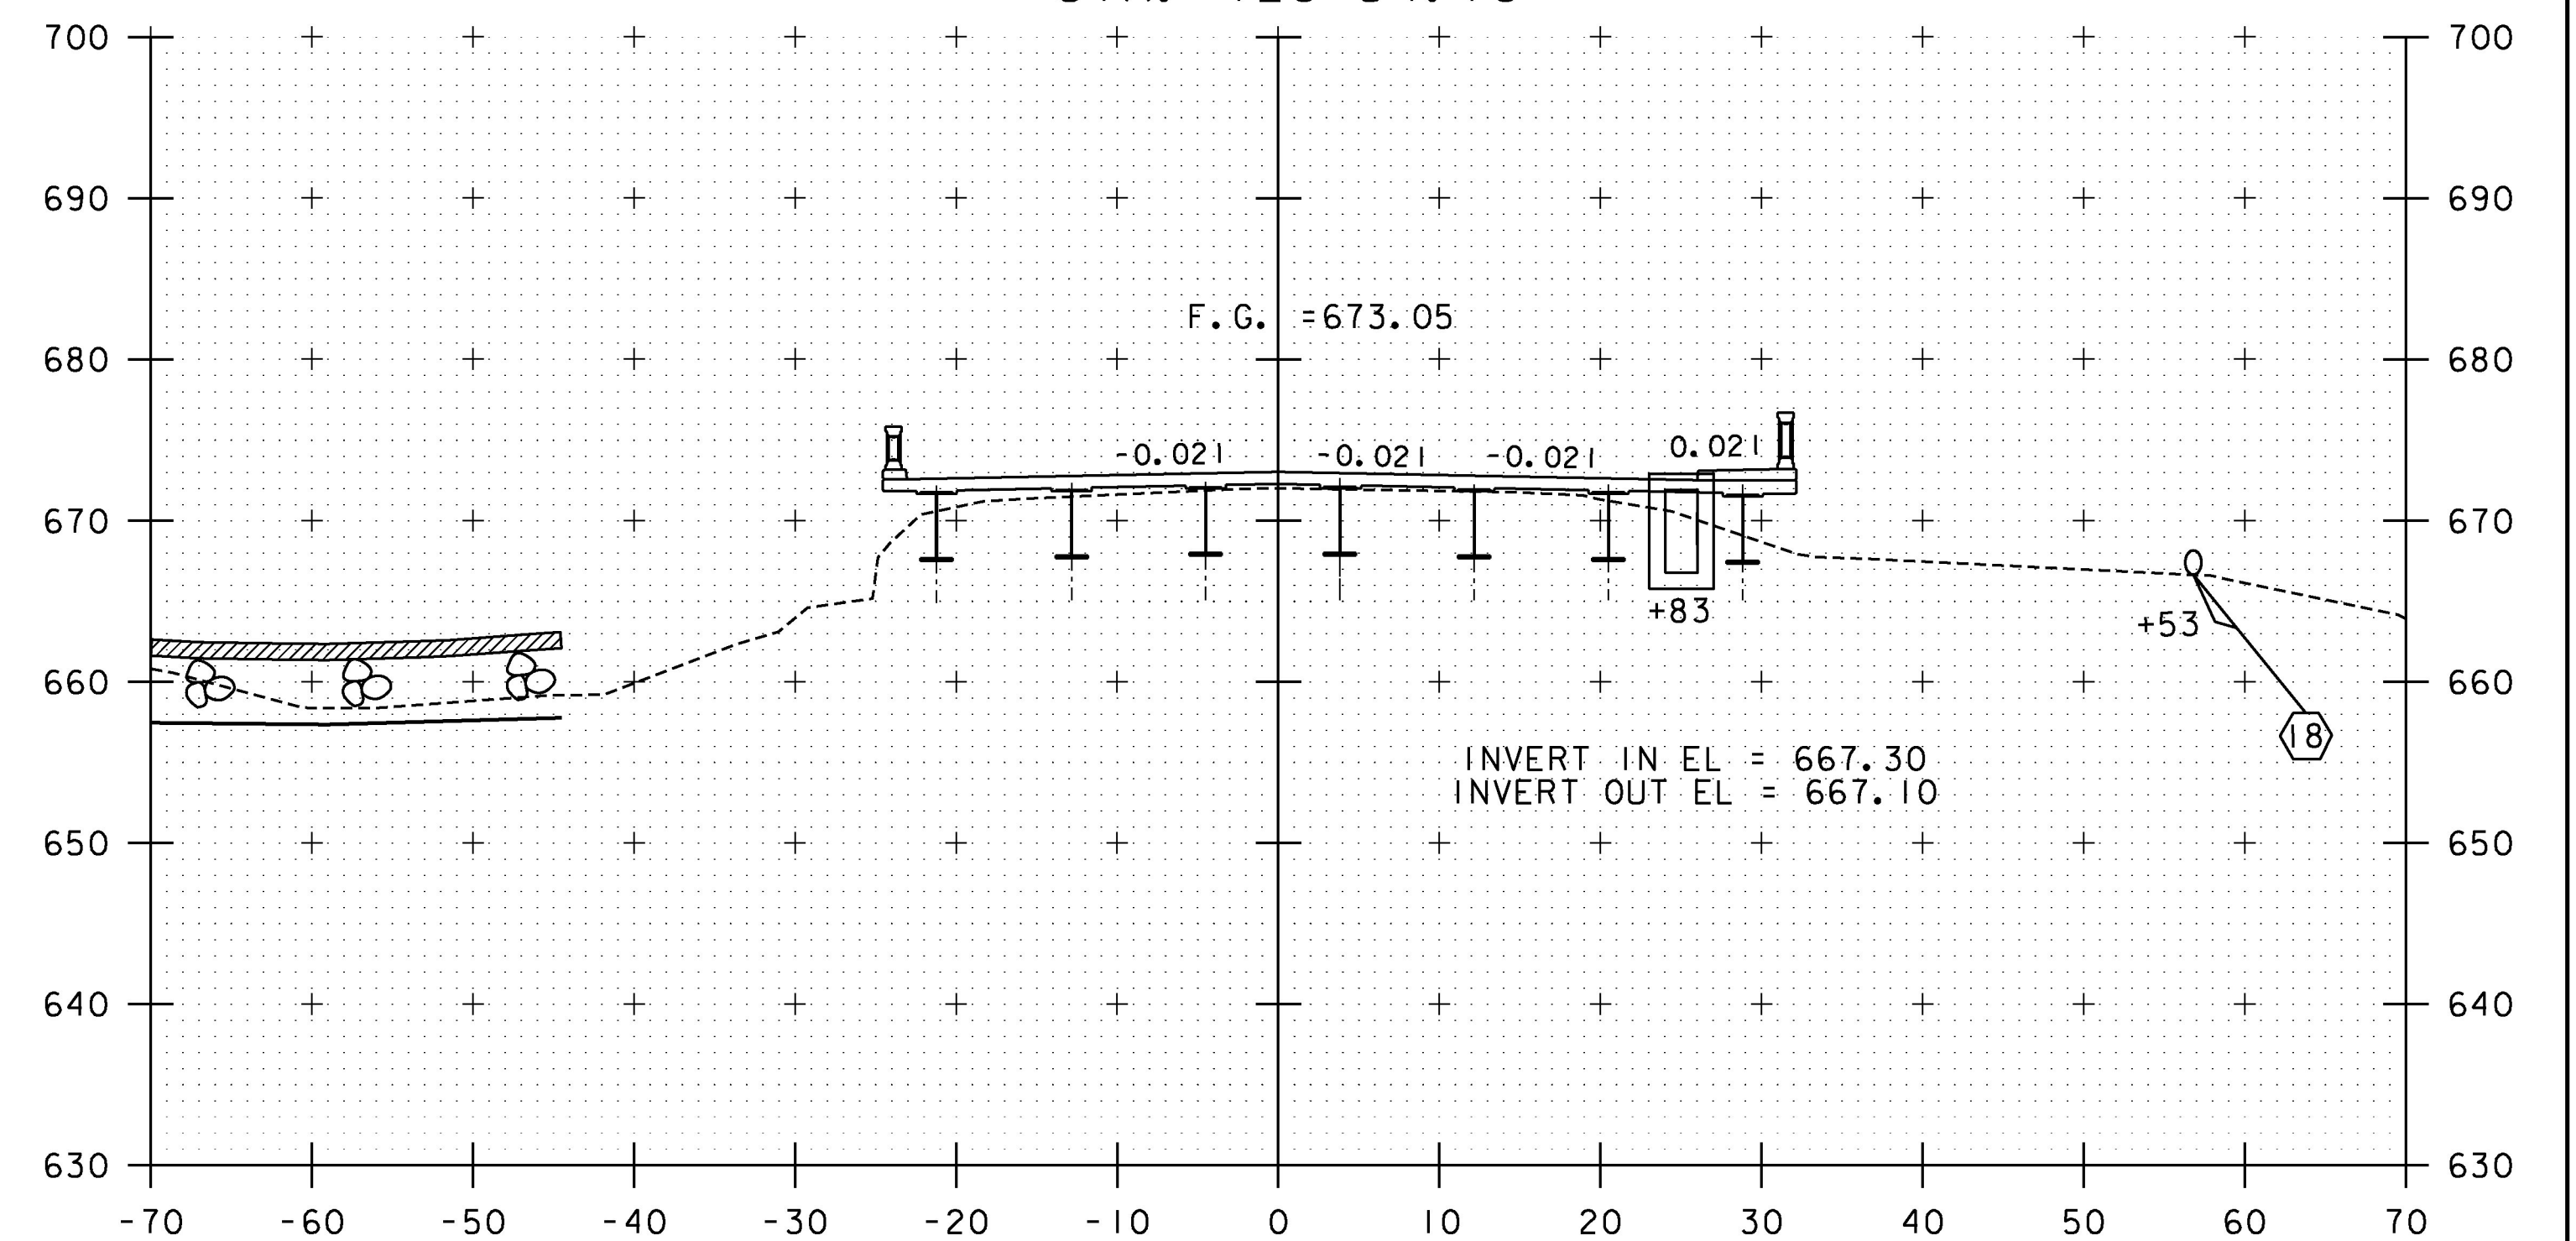

129+50

PROJECT NAME:	EAST MONTPELIER
PROJECT NUMBER:	BRF 037-(17)
FILE NAME:	32_Cross Sections.dgn
PROJECT LEADER:	T. KNIGHT
DESIGNED BY:	C. GENDRON
VT RTE 14 CROSS SECTIONS VXS-5	
PLOT DATE:	2/17/2017
DRAWN BY:	C. GENDRON
CHECKED BY:	K. RICHARDSON
SHEET	113 OF 158

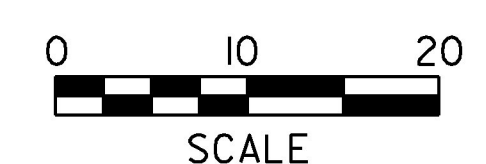

STA. 128+50 TO STA. 130+00