




1+00

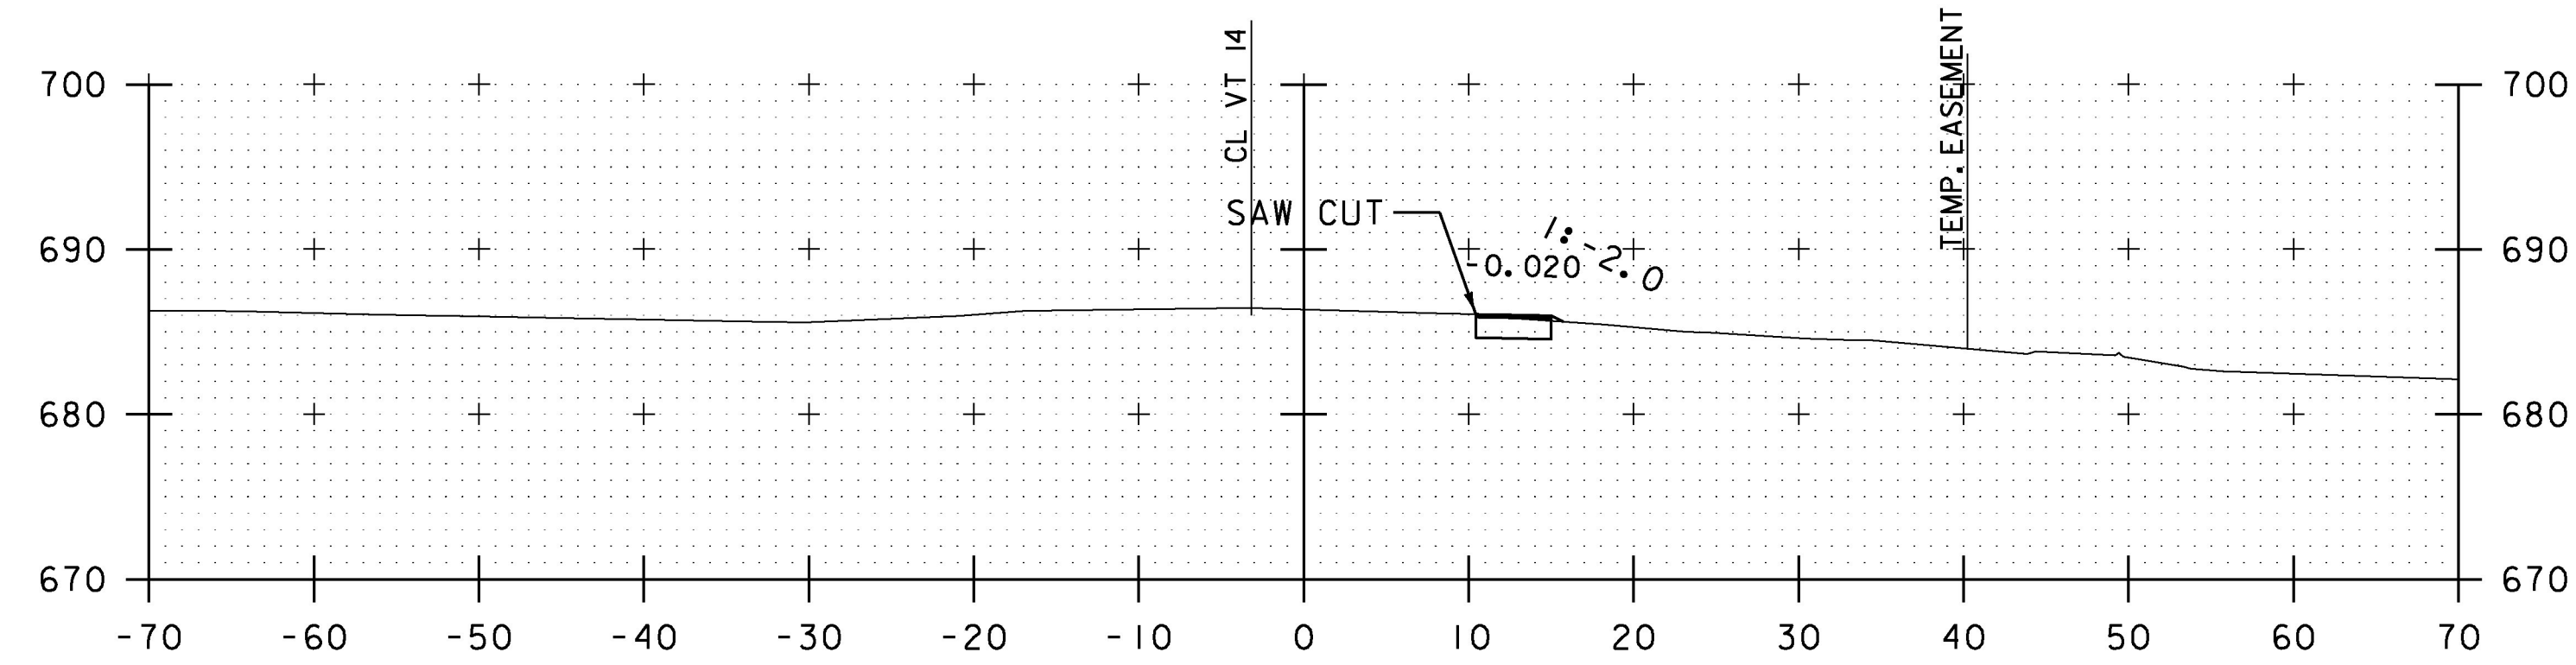


0+50

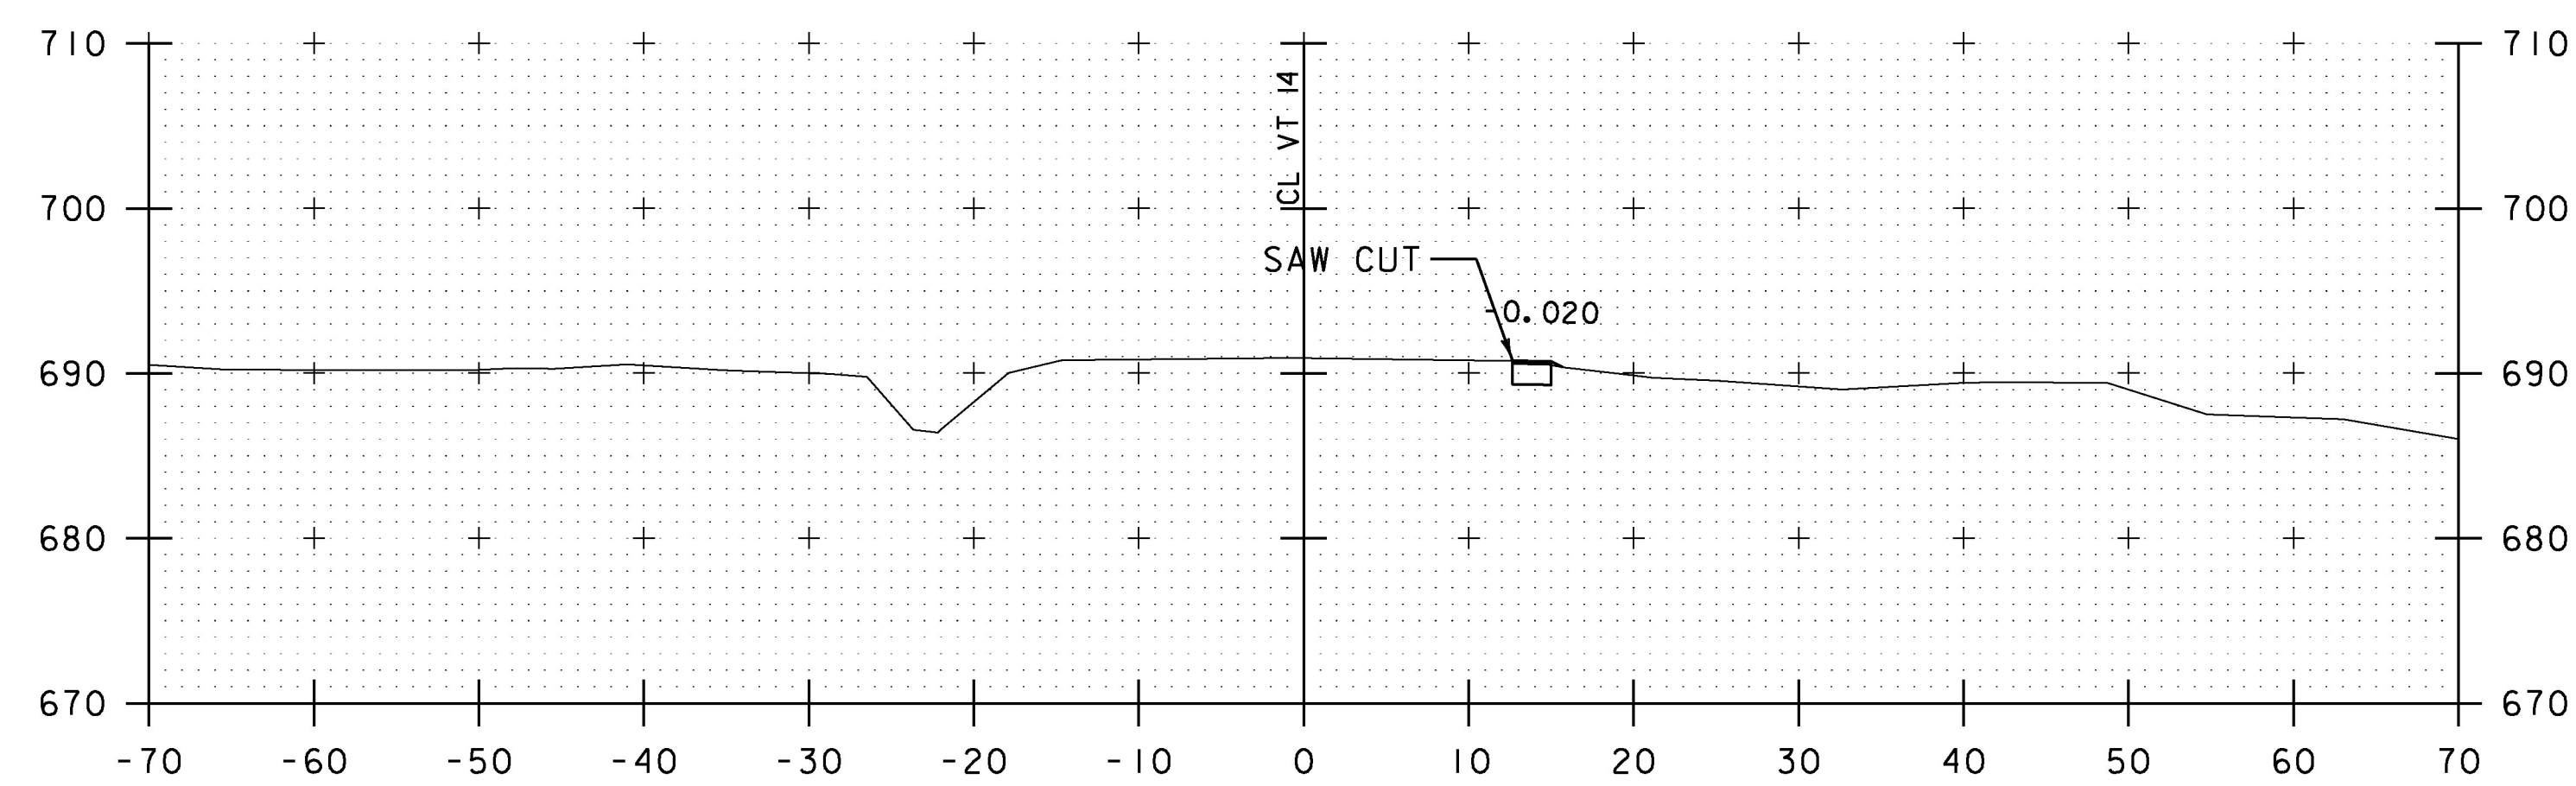


0+00

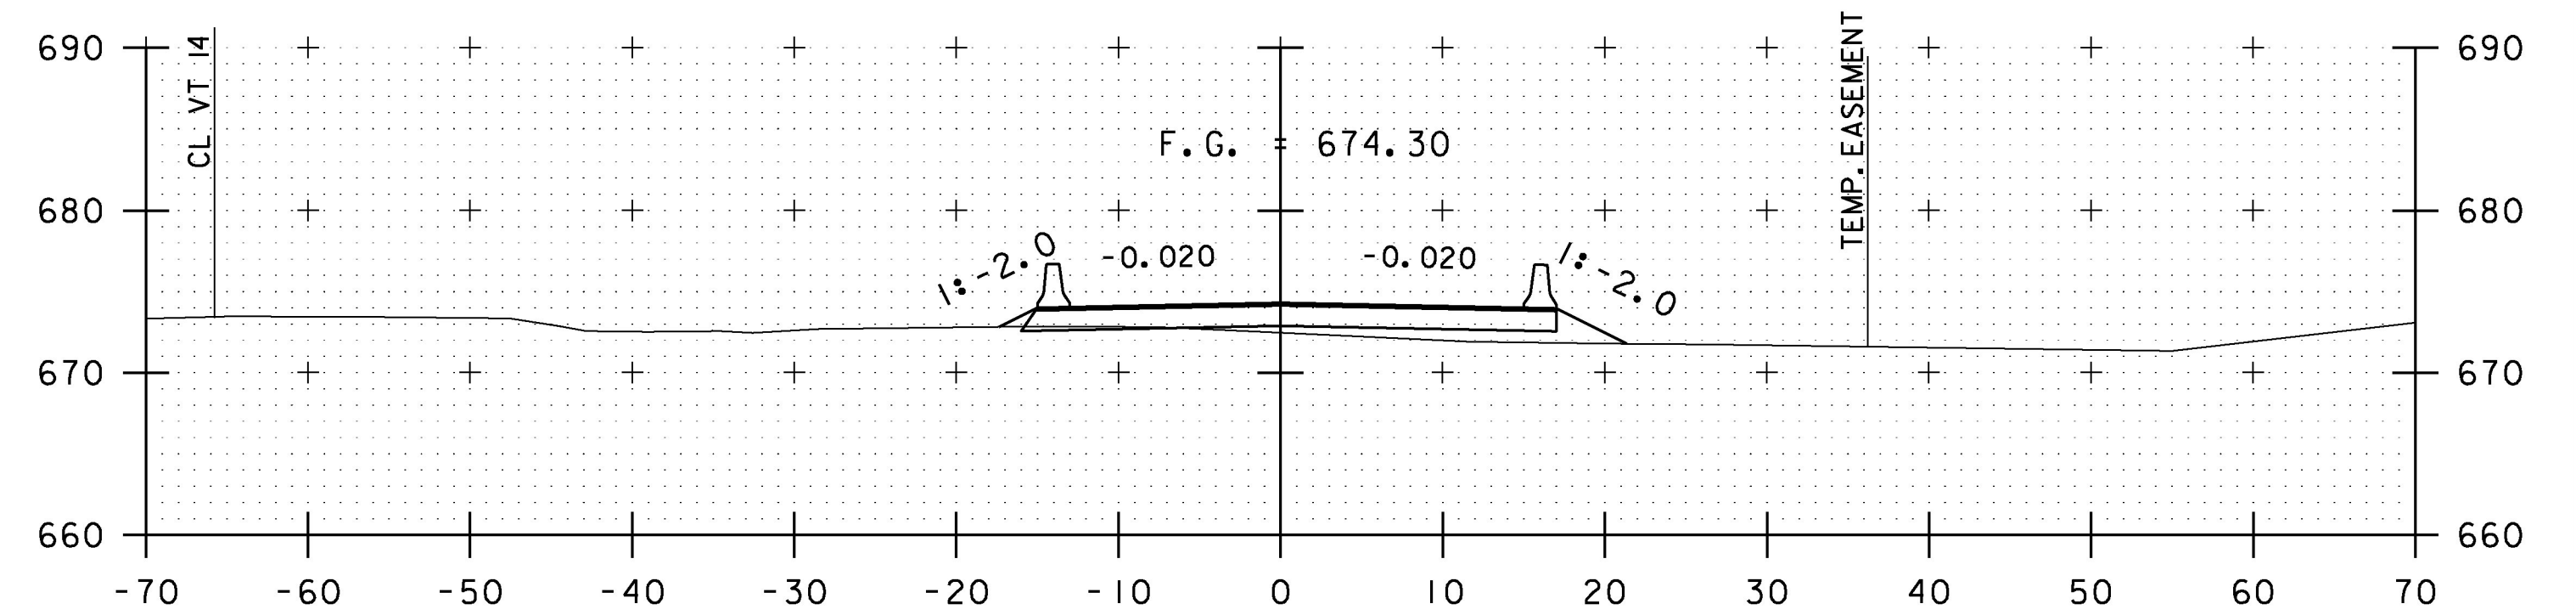

2+50

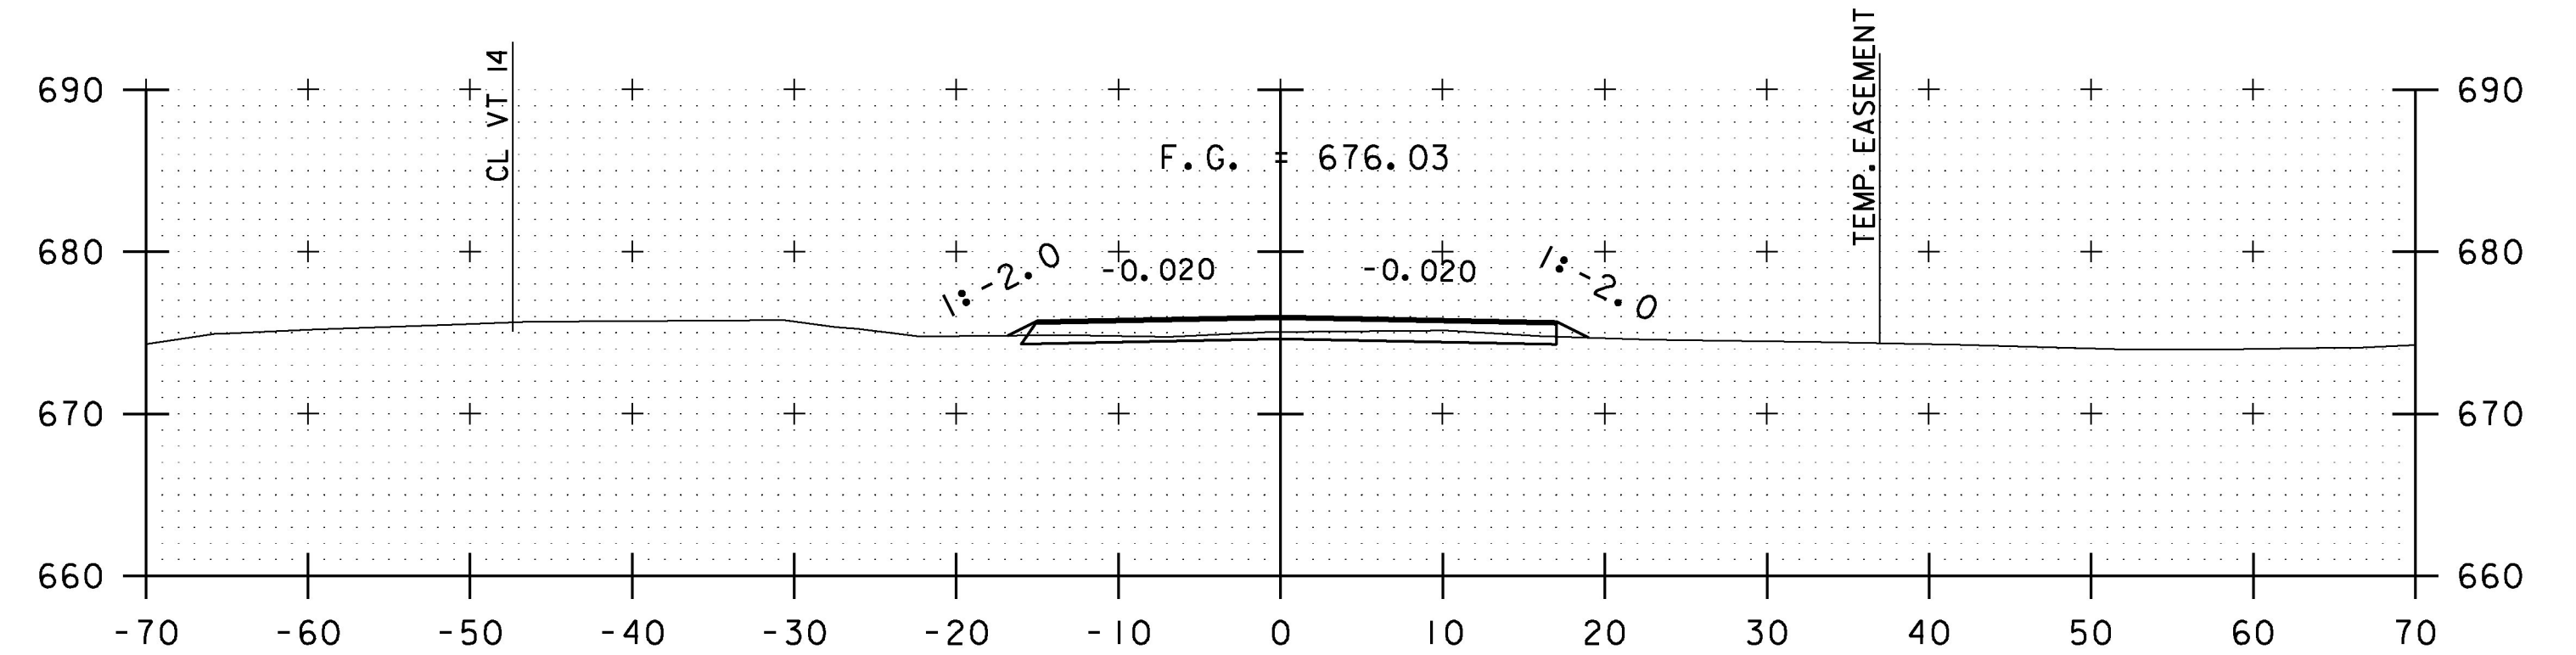

2+00

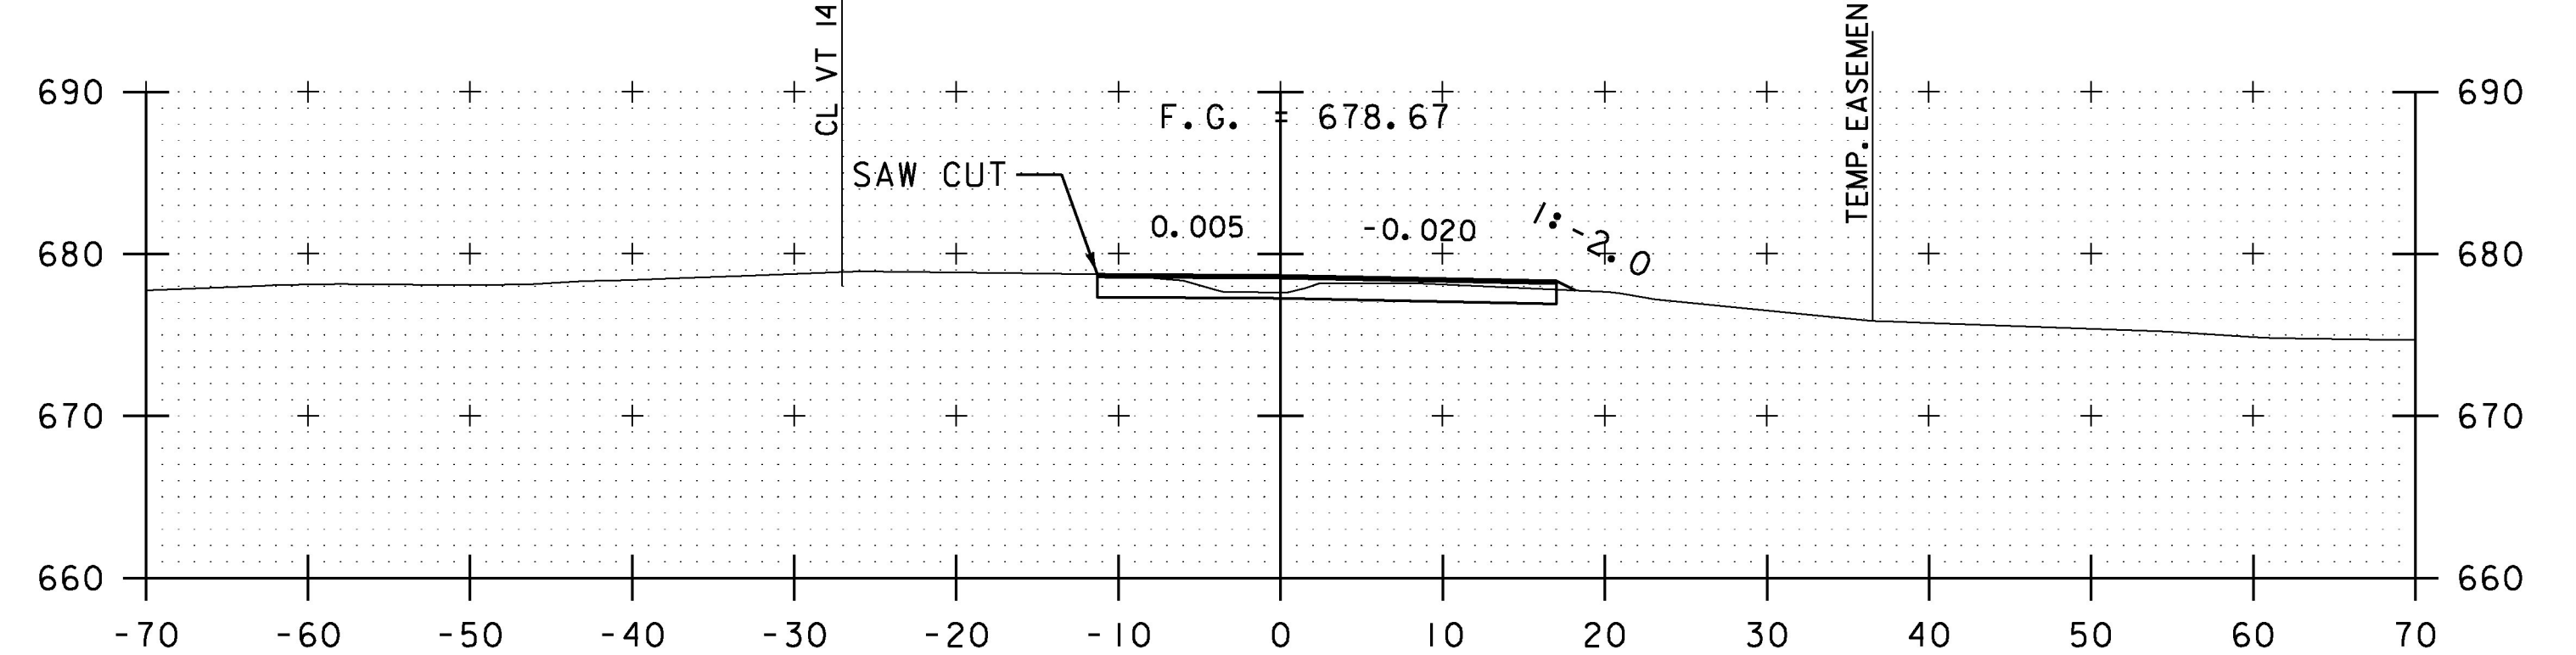

1+50

STA. 0+00 TO STA. 2+50



PROJECT NAME: EAST MONTPELIER	PLOT DATE: 2/17/2017
PROJECT NUMBER: BRF 037-1(7)	DRAWN BY: C. GENDRON
FILE NAME: 32_Cross Sections.dgn	CHECKED BY: K. RICHARDSON
DESIGNED BY: C. GENDRON	SHEET 114 OF 158
TEMPORARY CROSS SECTIONS TXS-1	