




3+50

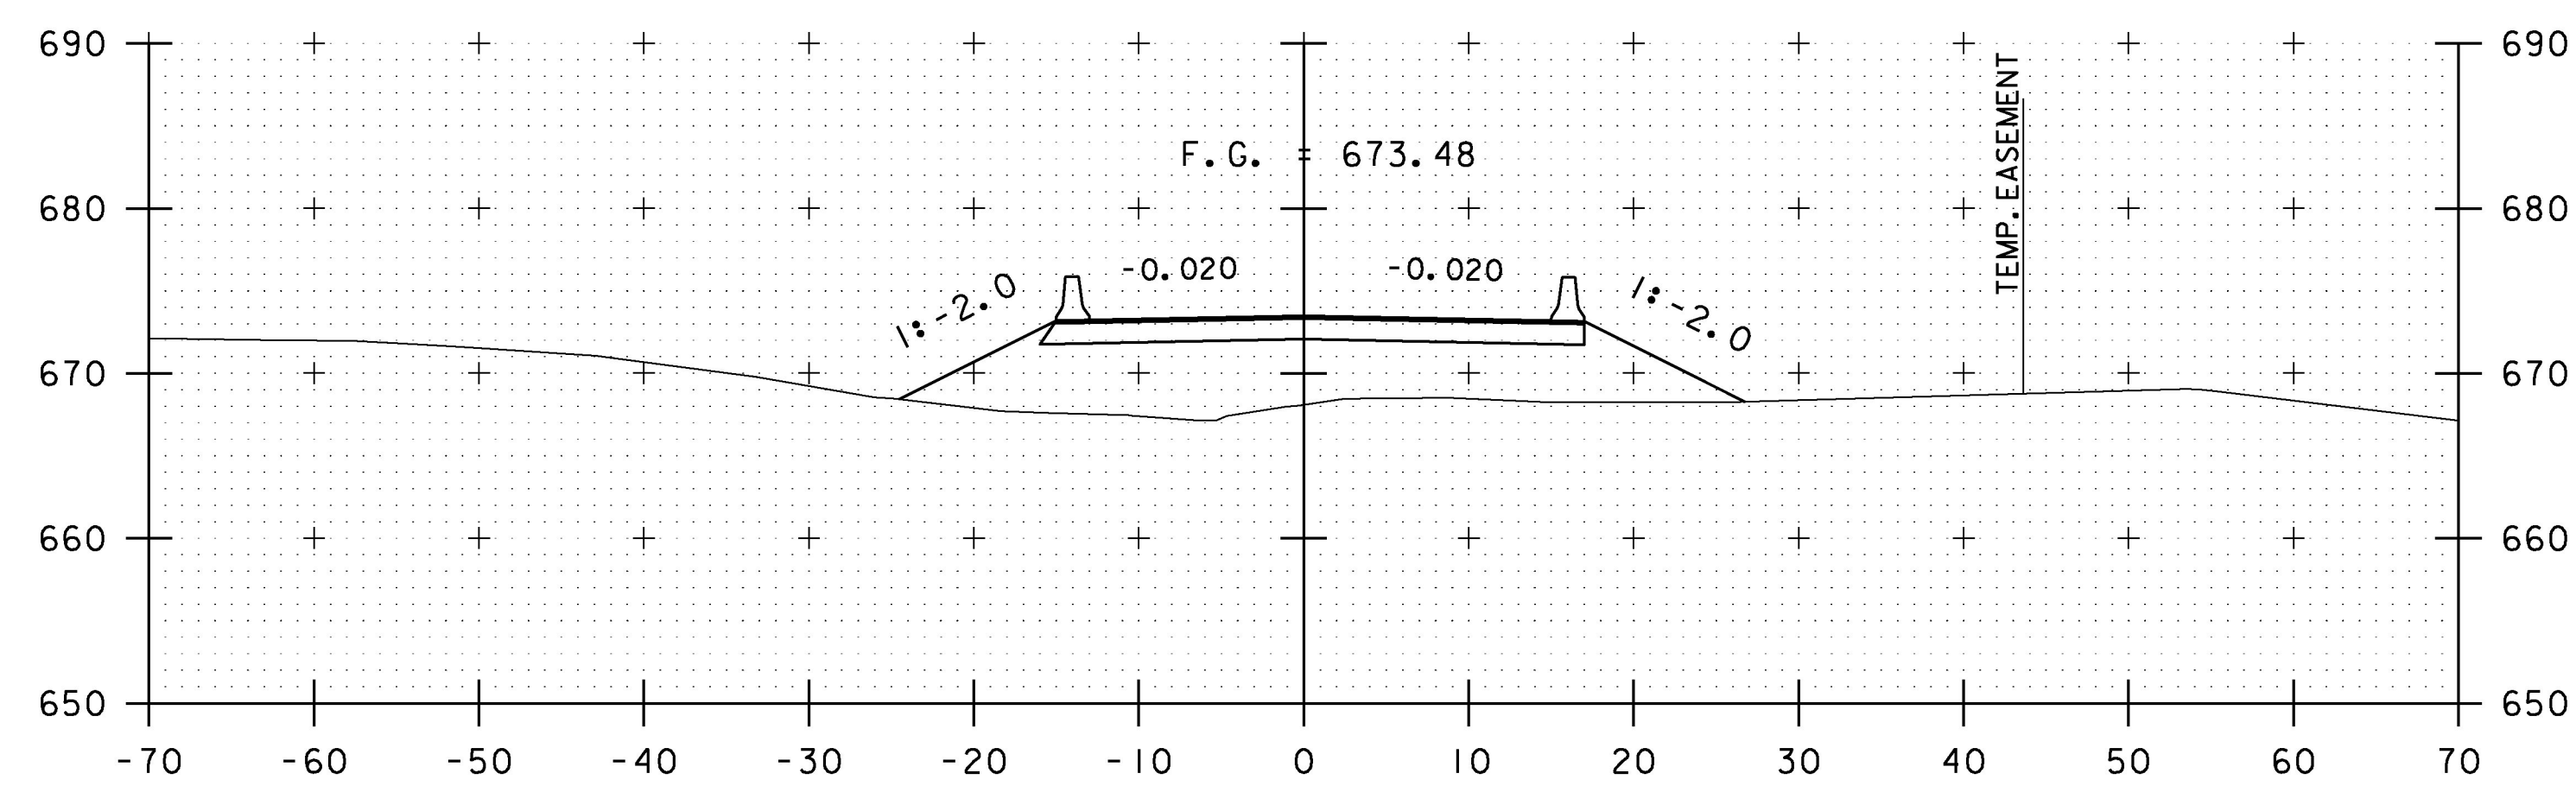

3+00

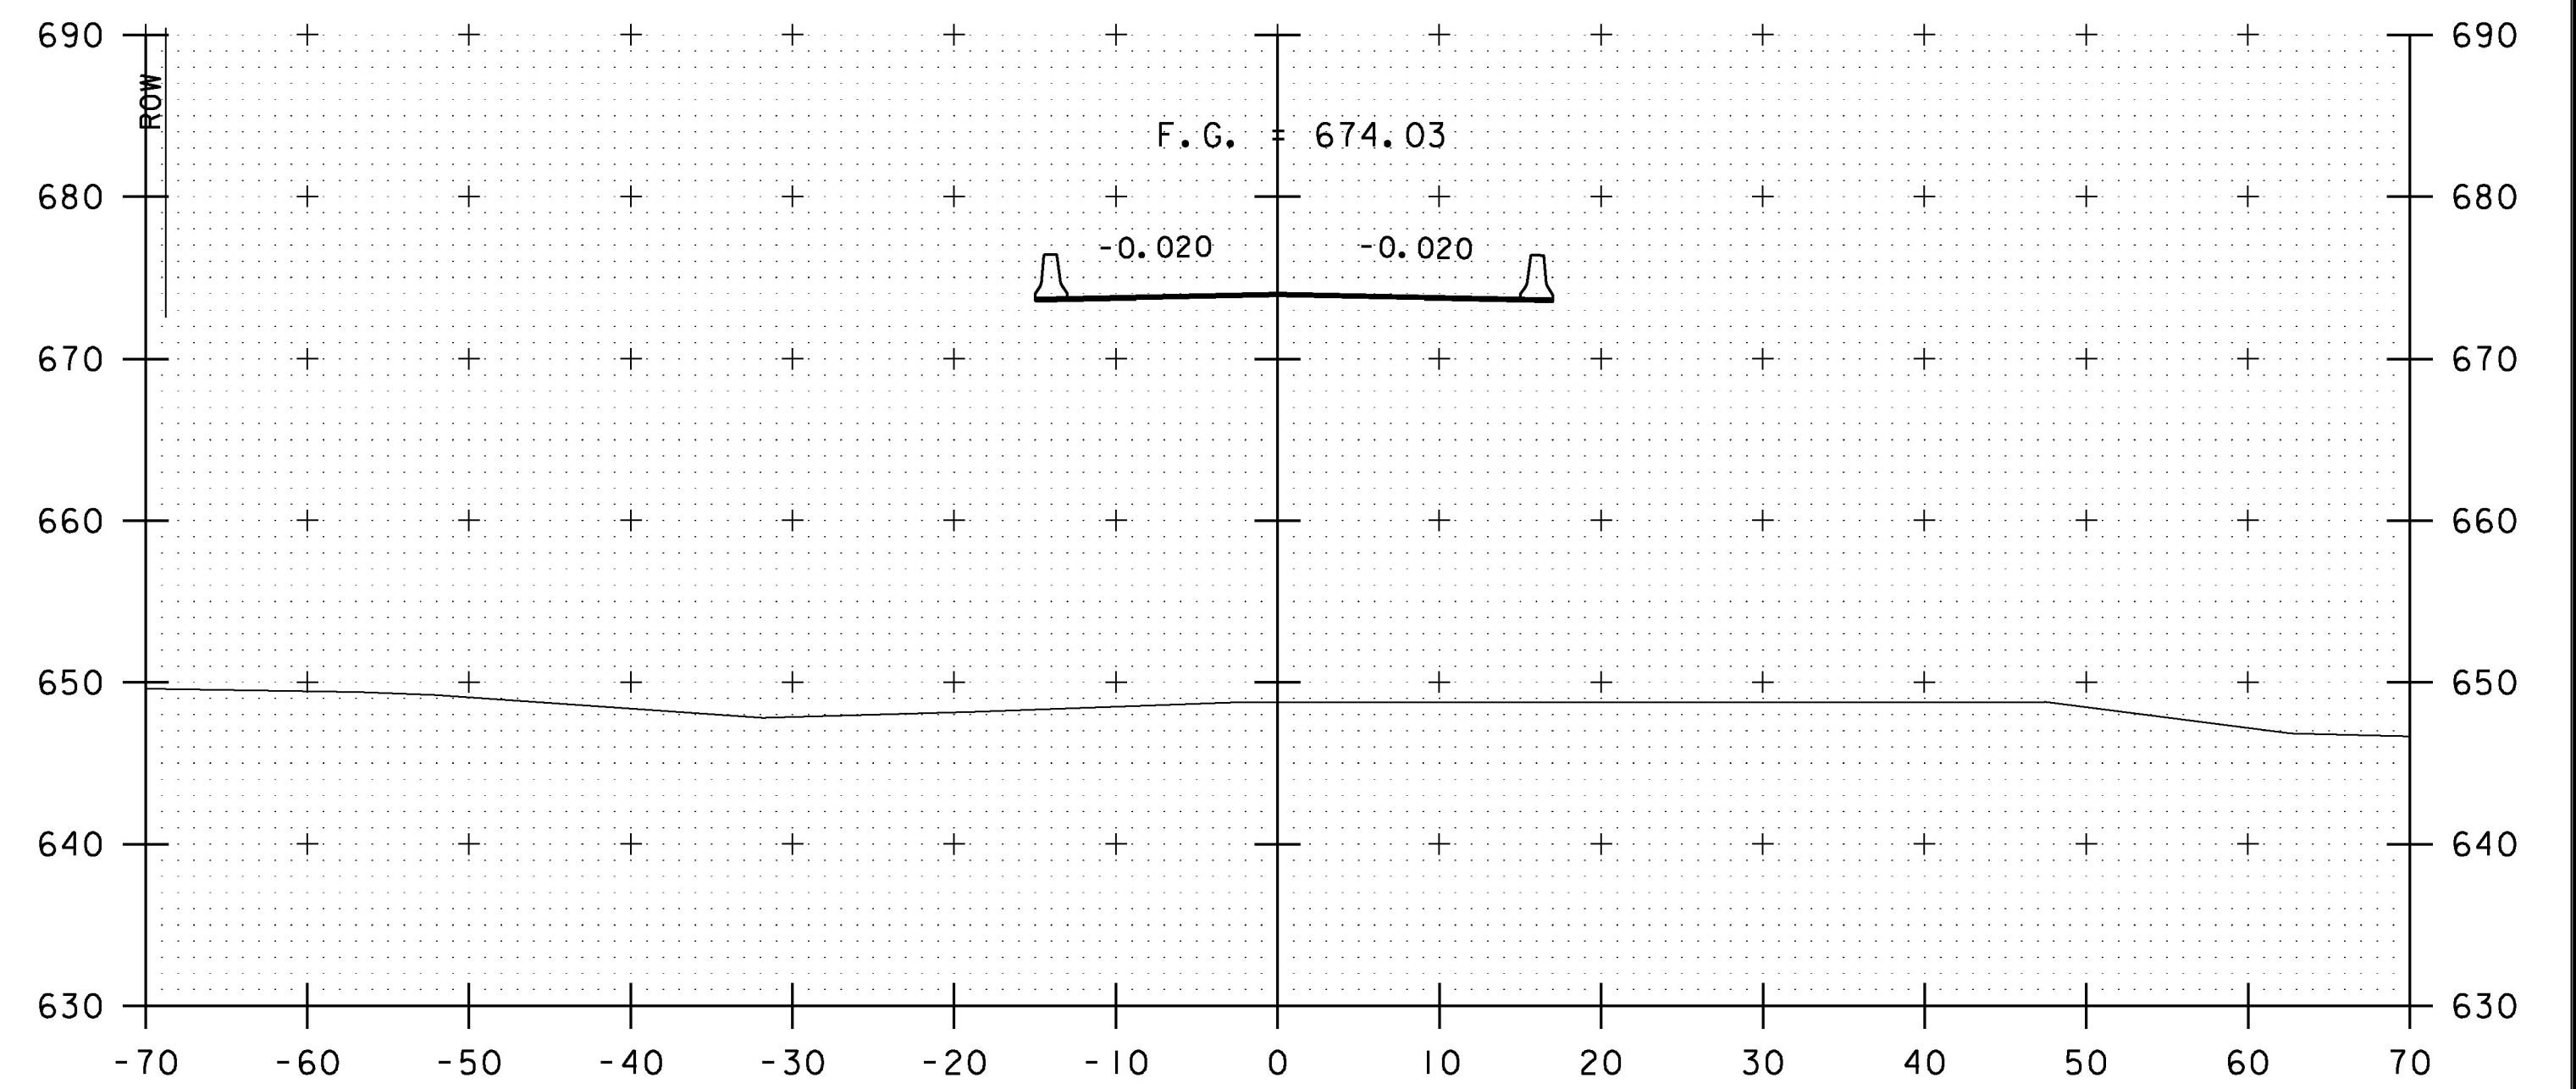

4+50

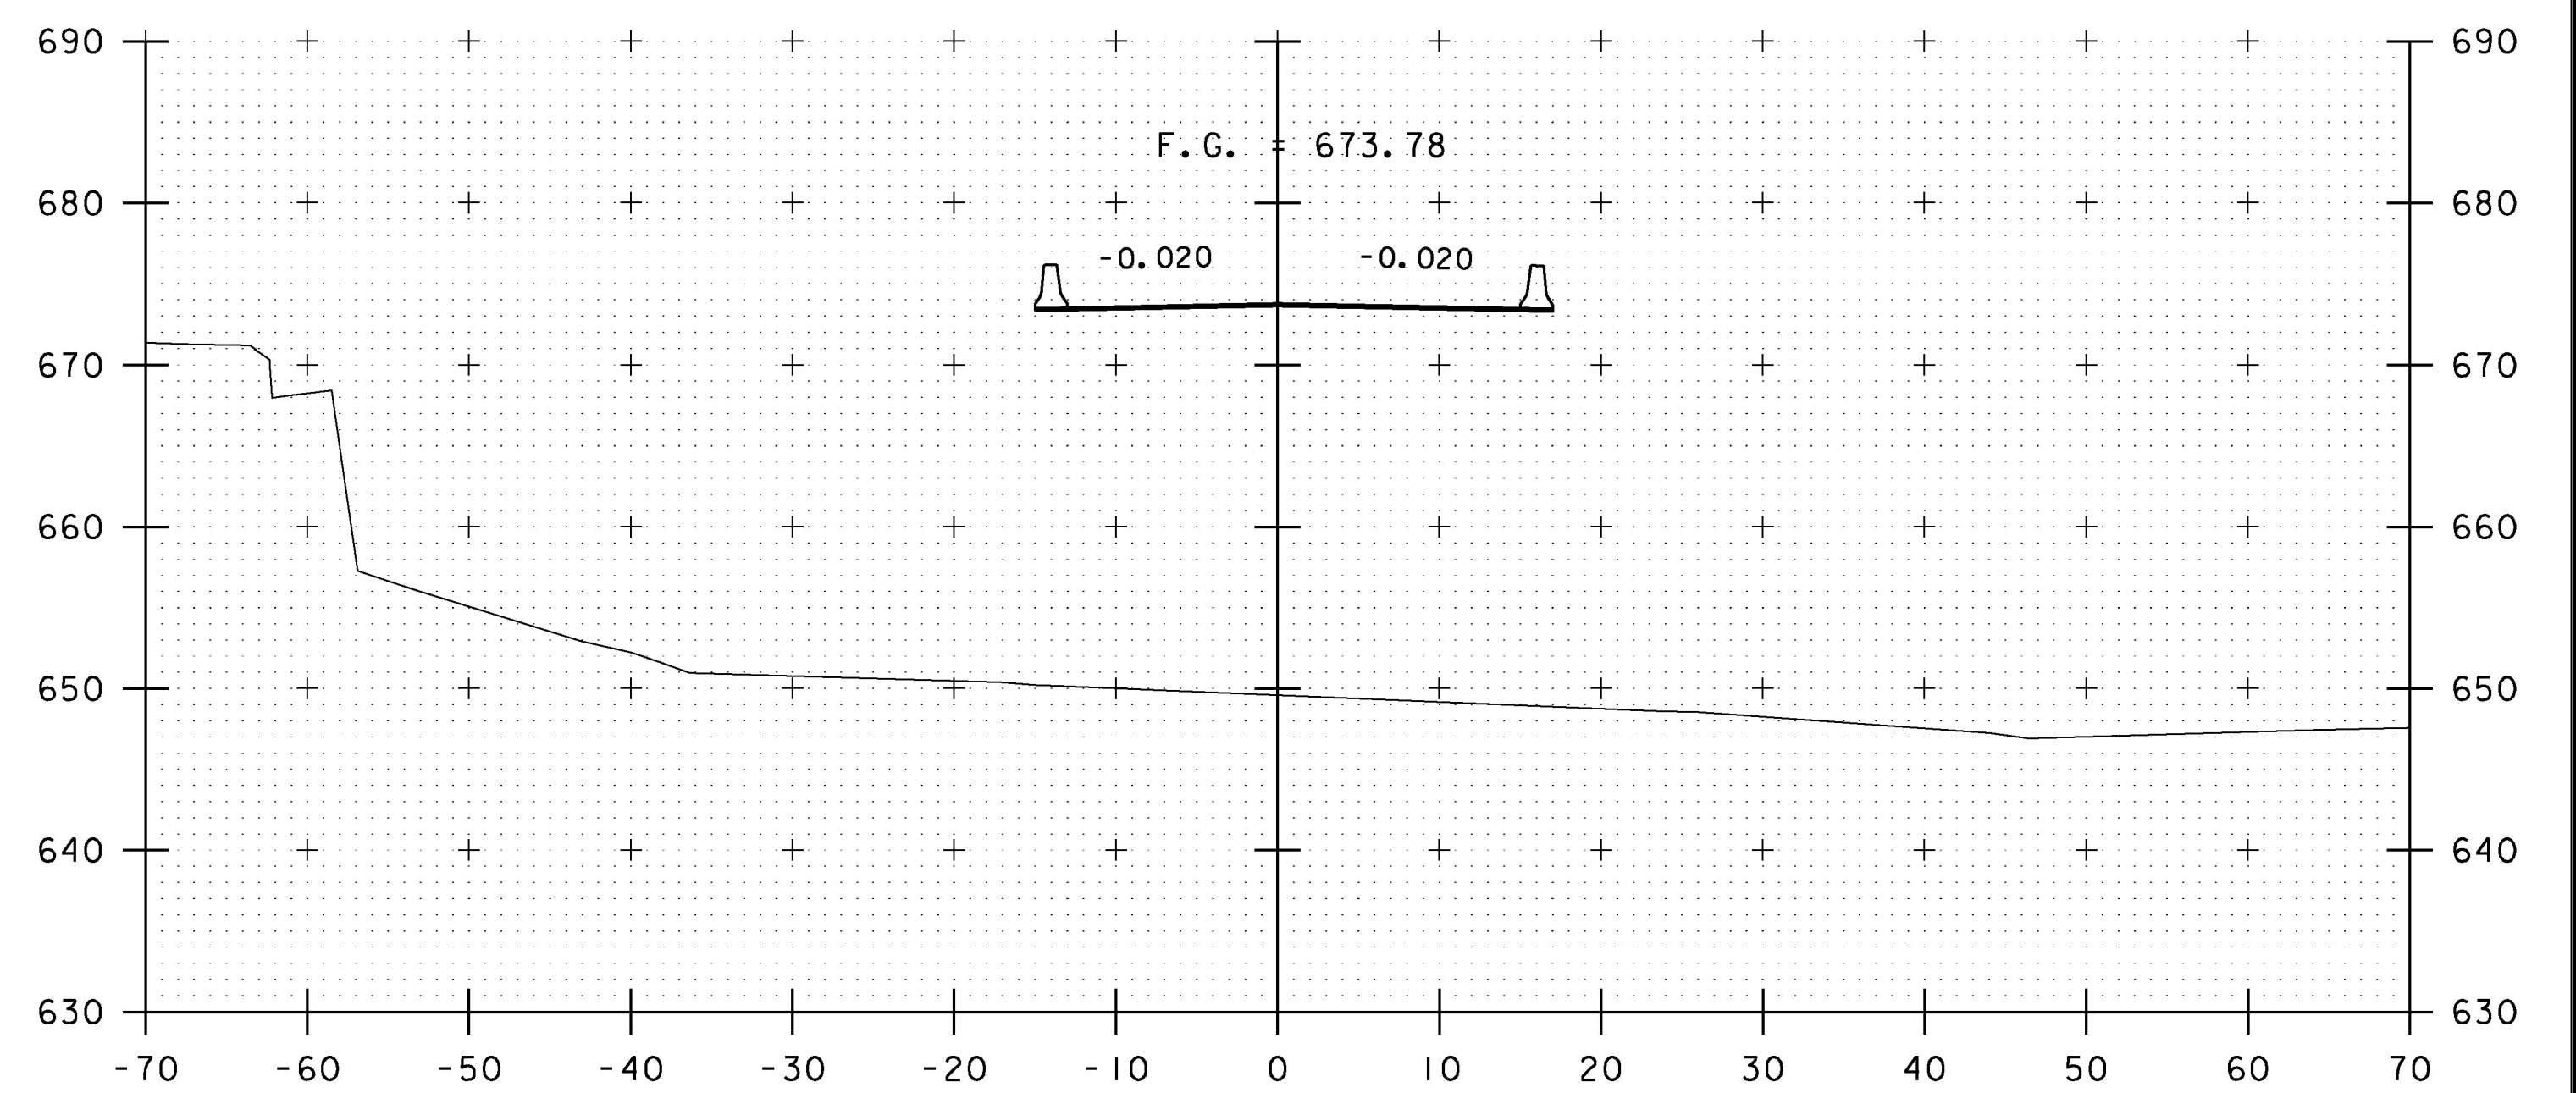

4+00

STA. 3+00 TO STA. 4+50



PROJECT NAME: EAST MONTPELIER	PLOT DATE: 2/17/2017
PROJECT NUMBER: BRF 037-1(7)	DRAWN BY: C. GENDRON
FILE NAME: 32_Cross Sections.dgn	CHECKED BY: K. RICHARDSON
PROJECT LEADER: T. KNIGHT	SHEET 115 OF 158
DESIGNED BY: C. GENDRON	
TEMPORARY CROSS SECTIONS TXS-2	