



9+75

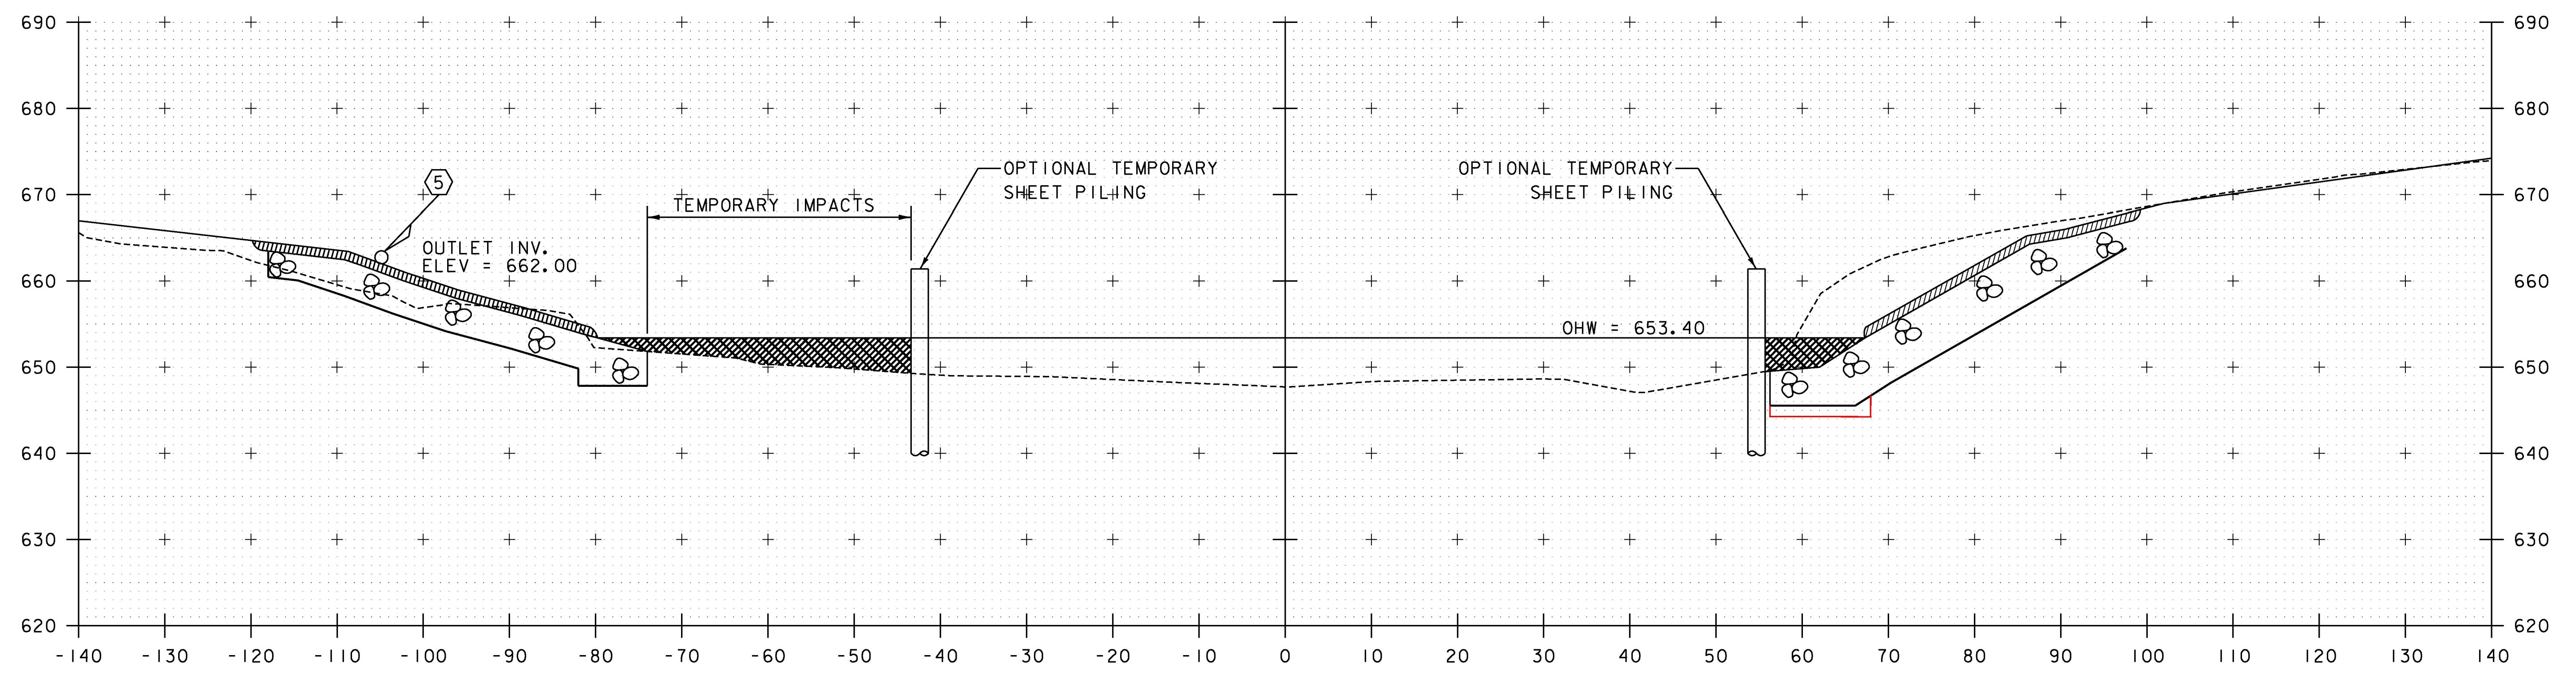

9+50

STA 9+35 LT
 BEGIN UNCLASSIFIED CHANNEL EXCAVATION
 BEGIN GEOTEXTILE UNDER STONE FILL
 BEGIN STONE FILL TYPE IV
 BEGIN GRUBBING MATERIAL

STA. 9+50 TO STA. 9+75

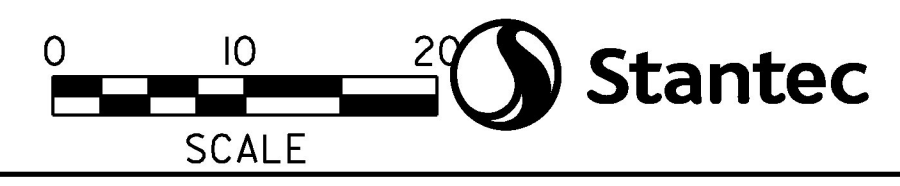

PROJECT NAME:	EAST MONTPELIER
PROJECT NUMBER:	BRF 037-I(7)
FILE NAME:	32_Cross Sections.dgn
PROJECT LEADER:	T. KNIGHT
DESIGNED BY:	C. GENDRON
CHANNEL CROSS SECTIONS:	CXS-2
PLOT DATE:	2/17/2017
DRAWN BY:	C. GENDRON
CHECKED BY:	K. RICHARDSON
SHEET:	118 OF 158