



10+25

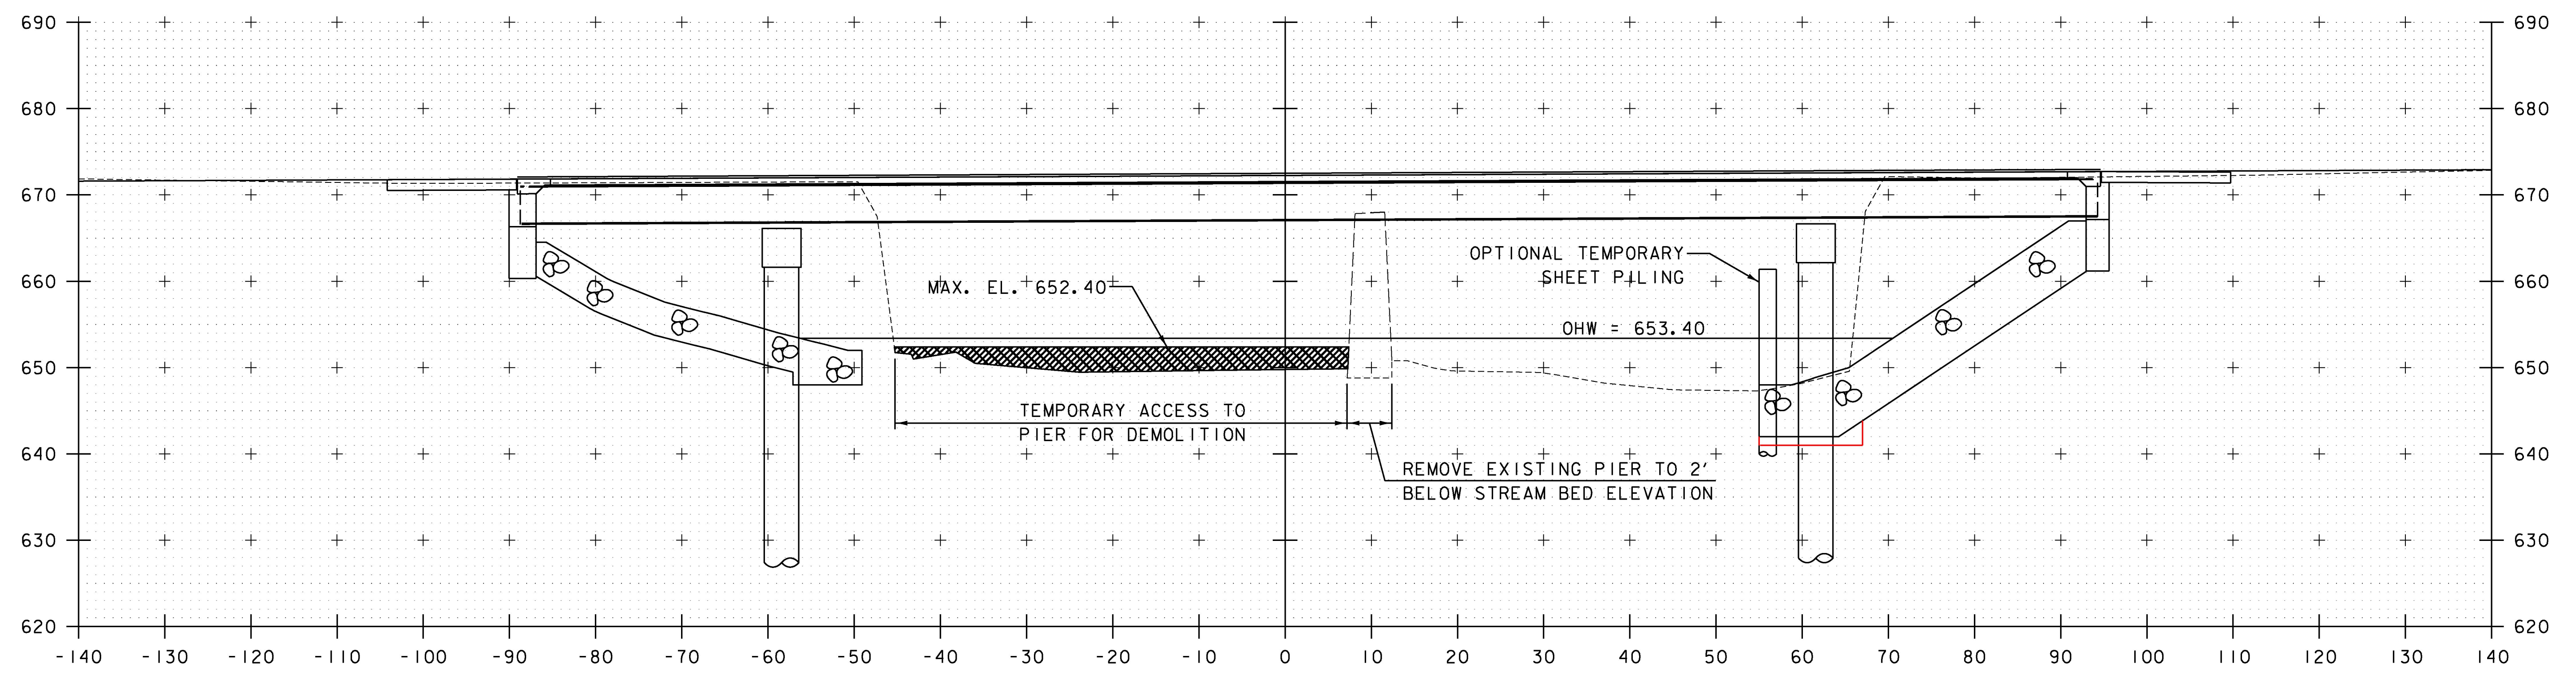

10+00

STA. 10+00 TO STA. 10+25

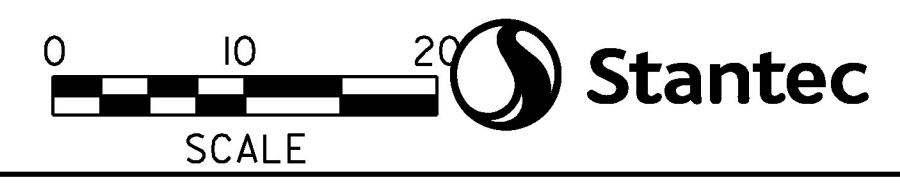

PROJECT NAME:	EAST MONTPELIER
PROJECT NUMBER:	BRF 037-I(7)
FILE NAME:	32_Cross Sections.dgn
PROJECT LEADER:	T. KNIGHT
DESIGNED BY:	C. GENDRON
CHANNEL CROSS SECTIONS:	CXS-3
PLOT DATE:	2/17/2017
DRAWN BY:	C. GENDRON
CHECKED BY:	K. RICHARDSON
SHEET:	119 OF 158