



STA 10+55 LT
 END UNCLASSIFIED CHANNEL EXCAVATION
 END GEOTEXTILE UNDER STONE FILL
 END STONE FILL TYPE IV
 END GRUBBING MATERIAL

10+75

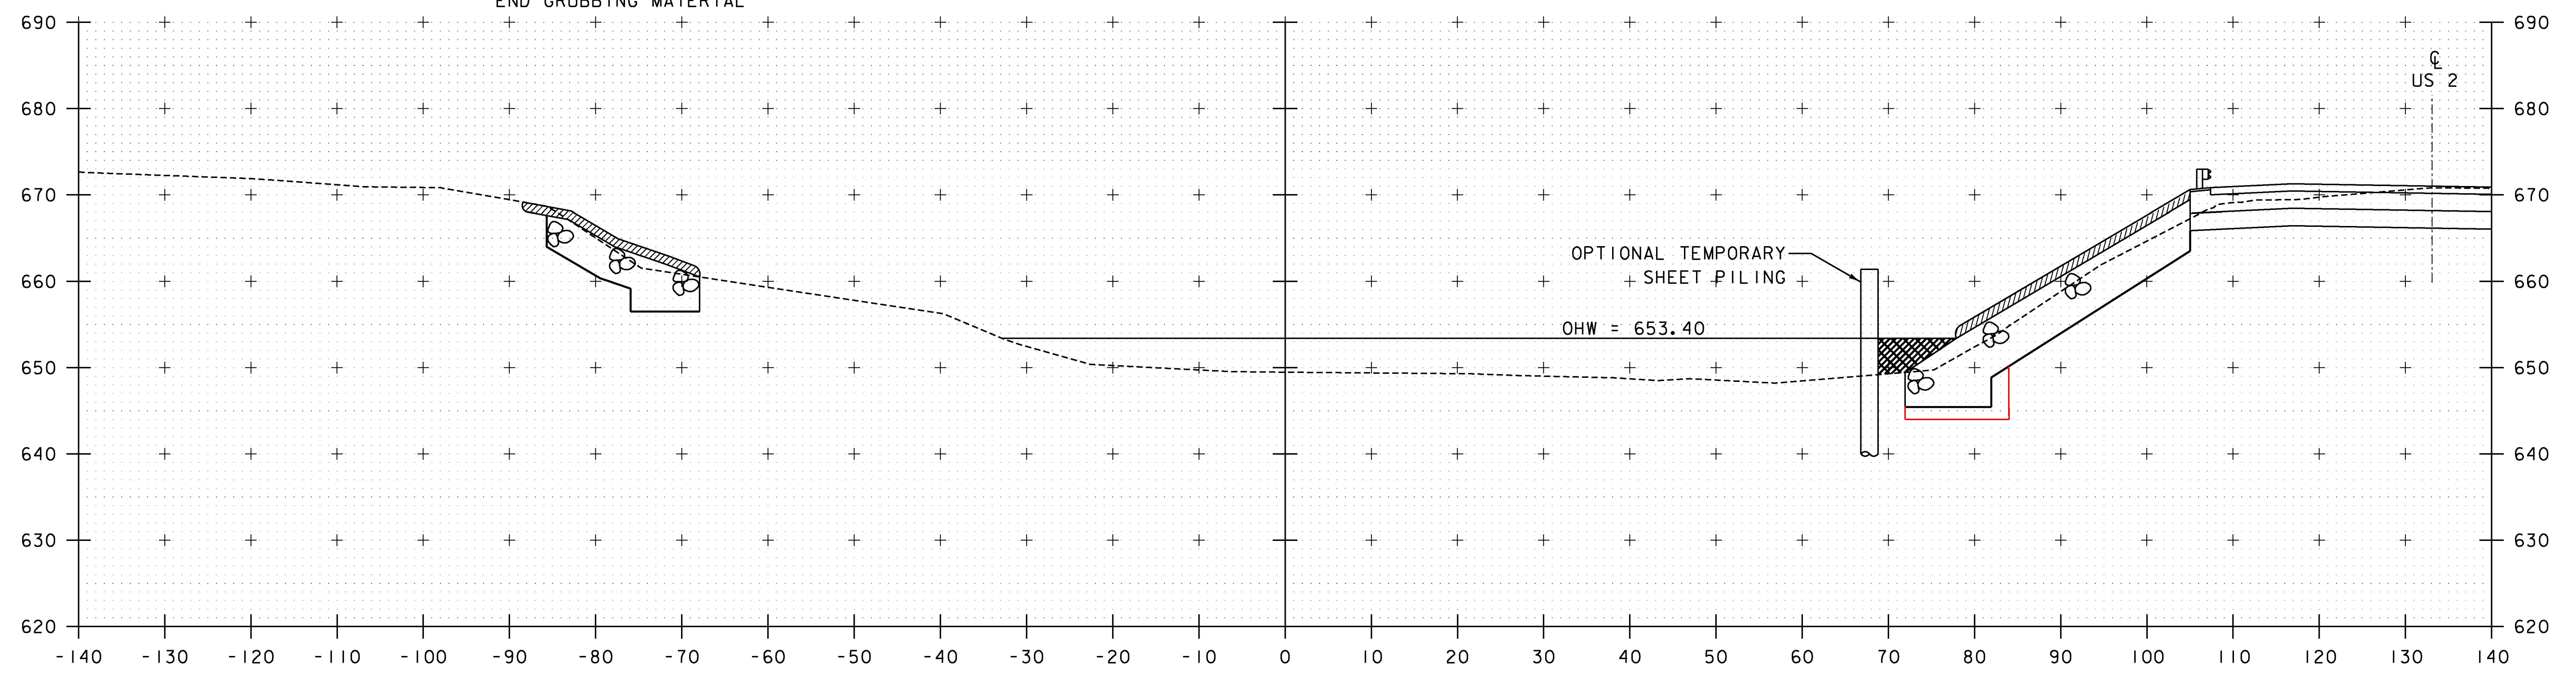

10+50

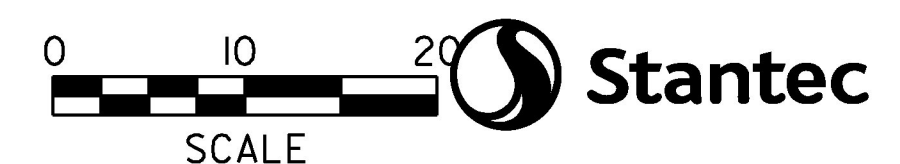

STA. 10+50 TO STA. 10+75

PROJECT NAME:	EAST MONTPELIER
PROJECT NUMBER:	BRF 037-I(7)
FILE NAME:	32_Cross Sections.dgn
PROJECT LEADER:	T. KNIGHT
DESIGNED BY:	C. GENDRON
CHANNEL CROSS SECTIONS:	CXS-4
PLOT DATE:	2/17/2017
DRAWN BY:	C. GENDRON
CHECKED BY:	K. RICHARDSON
SHEET:	120 OF 158