



11+25

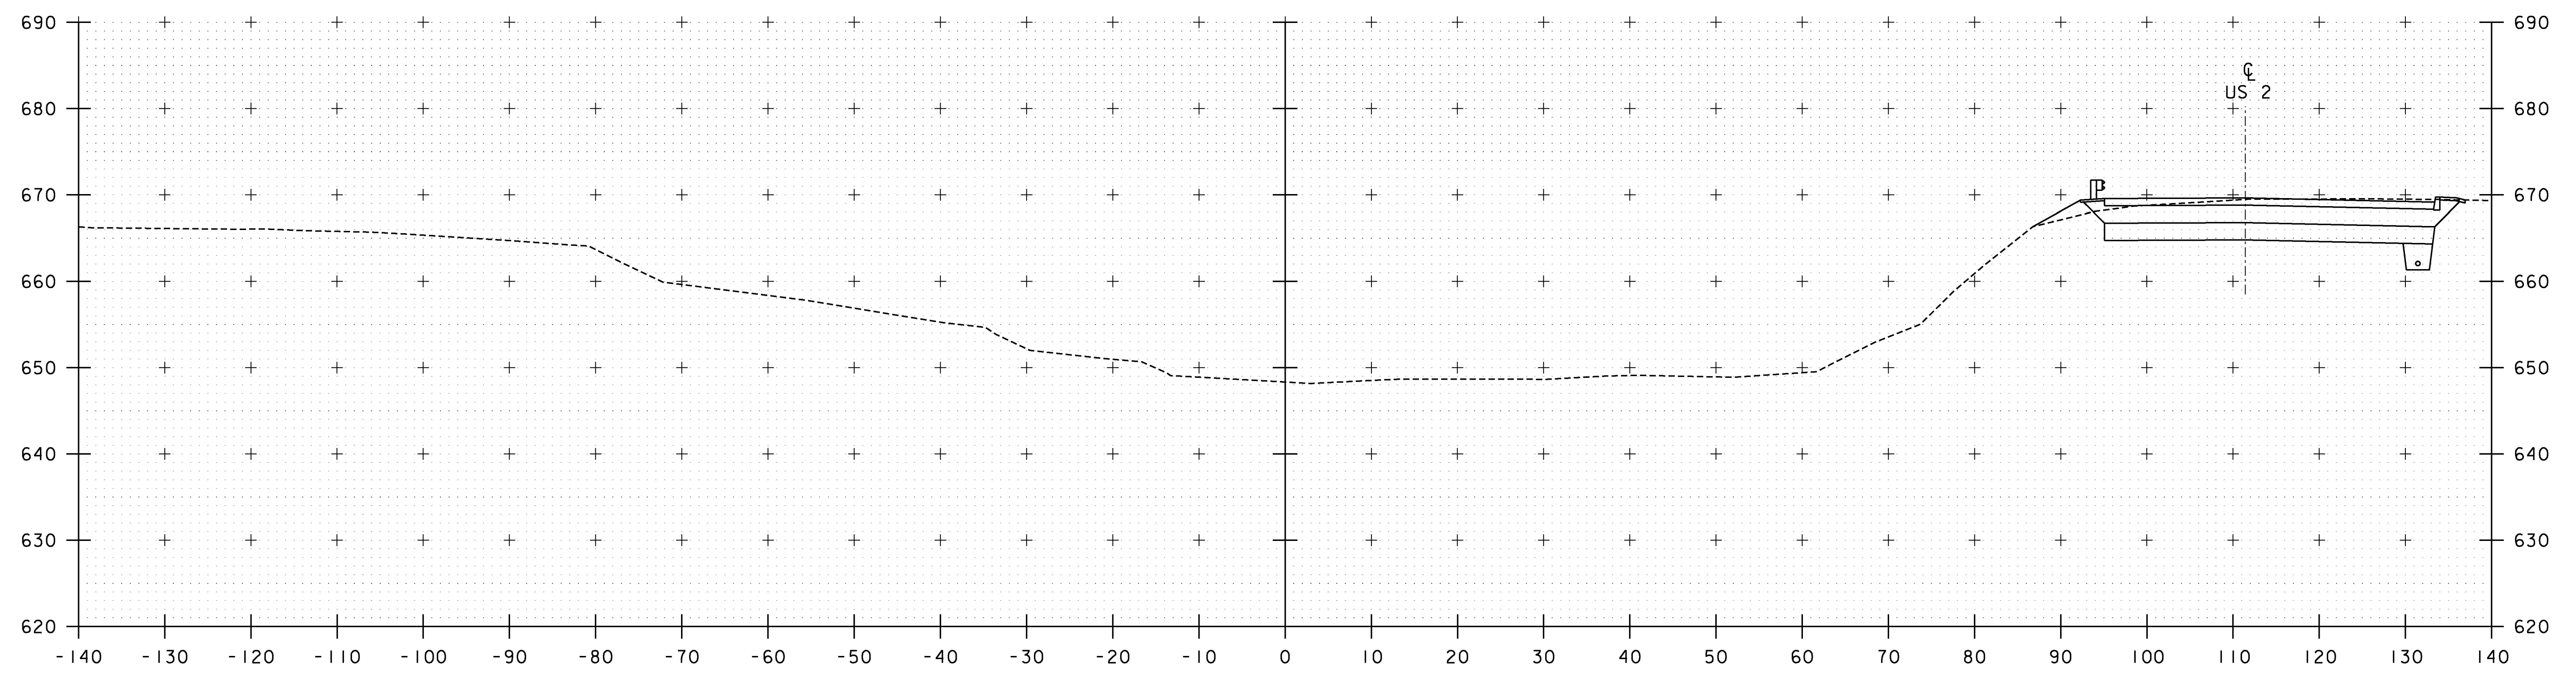

11+00

STA 10+93 RT
 END UNCLASSIFIED CHANNEL EXCAVATION
 END GEOTEXTILE UNDER STONE FILL
 END STONE FILL TYPE IV
 END GRUBBING MATERIAL

PROJECT NAME:	EAST MONTPELIER
PROJECT NUMBER:	BRF 037-1(7)
FILE NAME:	32_Cross Sections.dgn
DESIGNED BY:	C. GENDRON
CHANNEL CROSS SECTIONS:	CXS-5
PLOT DATE:	2/17/2017
DRAWN BY:	C. GENDRON
CHECKED BY:	K. RICHARDSON
SHEET:	121 OF 158

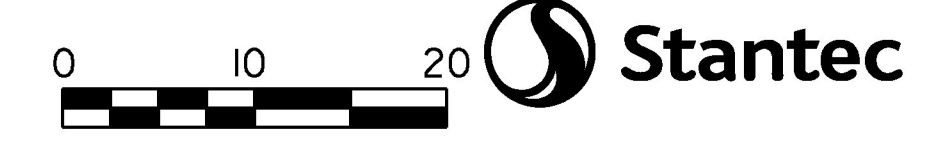

STA. 11+00 TO STA. 11+25