


SEE SHEET ECS 2  
MATCH LINE STA. 145+75

**NOTE:**  
1. SEE EPSC CONST. SITE PLAN ECS-1 FOR GENERAL NOTES AND LEGEND

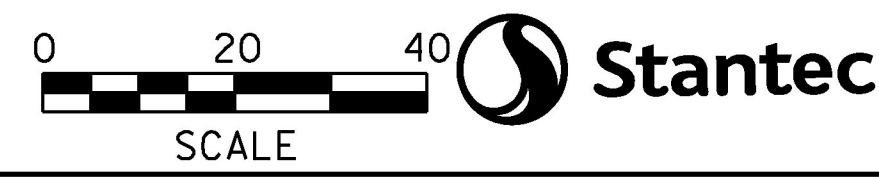

PROJECT NAME:	EAST MONTPELIER
PROJECT NUMBER:	BRF 037-(17)
FILE NAME: ... \plot_files\14a_EPSC-Const.dgn	PLOT DATE: 2/17/2017
PROJECT LEADER:	T. KNIGHT
DESIGNED BY:	K. RICHARDSON
EPSC CONST. SITE PLAN ECS 4	CHECKED BY: G. GOYETTE
	SHEET 131 OF 158