


LEGEND	
— AER E&T —	AERIAL ELECTRIC & TELEPHONE
⊕ — △ — ⊙	LIMITS OF SOIL DISTURBANCE
▒	DISTURBED AREAS REQUIRING RE-VEGETATION
⊕ - - - △ - - - ⊙	TEMPORARY CONSTRUCTION LIMITS

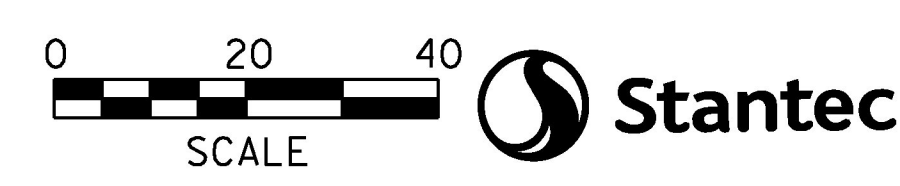

PROJECT NAME:	EAST MONTPELIER	PLOT DATE:	2/17/2017
PROJECT NUMBER:	BRF 037-(17)	DRAWN BY:	E. ALLING
FILE NAME:	... \14b_EPSC-Final Cond.dgn	CHECKED BY:	G. GOYETTE
PROJECT LEADER:	T. KNIGHT	DESIGNED BY:	K. RICHARDSON
EPSC FINAL COND. SITE PLAN EFC 1		SHEET	132 OF 158