


NOTES:
 1. FOR LEGEND SEE EPSC FINAL COND.
 SITE PLAN EFC-1

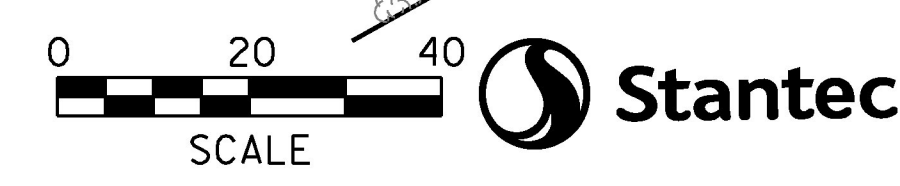

PROJECT NAME:	EAST MONTPELIER	PLOT DATE:	2/17/2017
PROJECT NUMBER:	BRF 037-1(7)	DRAWN BY:	E. ALLING
FILE NAME:	...14b_EPSC-Final Cond.dgn	DESIGNED BY:	K. RICHARDSON
PROJECT LEADER:	T. KNIGHT	CHECKED BY:	G. GOYETTE
EPSC FINAL COND. PLAN EFC 2		SHEET	133 OF 158