


NOTES:

1. FOR LEGEND SEE EPSC FINAL COND.
SITE PLAN EFC-1

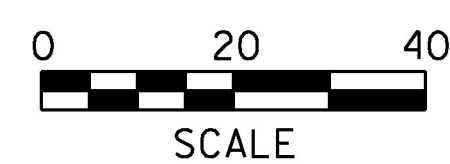

PROJECT NAME:	EAST MONTPELIER
PROJECT NUMBER:	BRF 037-1(7)
FILE NAME: ...14b_EPSC-Final Cond.dgn	PLOT DATE: 2/17/2017
PROJECT LEADER: T. KNIGHT	DRAWN BY: E. ALLING
DESIGNED BY: K. RICHARDSON	CHECKED BY: G. GOYETTE
EPSC FINAL COND. SITE PLAN EFC 3	SHEET 134 OF 158