


MATCH LINE STA. 145+75
SEE SHEET EFC 2

NOTES:
1. FOR LEGEND SEE EPSC FINAL COND.
SITE PLAN EFC-1

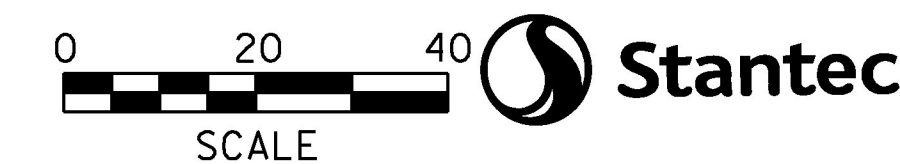

PROJECT NAME:	EAST MONTPELIER
PROJECT NUMBER:	BRF 037-(17)
FILE NAME: ...\\14b_EPSC-Final Cond.dgn	PLOT DATE: 2/17/2017
PROJECT LEADER: T. KNIGHT	DRAWN BY: E. ALLING
DESIGNED BY: K. RICHARDSON	CHECKED BY: G. GOYETTE
EPSC FINAL COND. SITE PLAN EFC 4	SHEET 135 OF 158