


BRF 037-1(7)
 2011 WATERLINE RELOCATION
 SHEET 154 OF 158
 FOR REFERENCE ONLY

LEGEND:

- | | |
|--------------------------------|----------------------------------|
| EXISTING FEATURES | PROPOSED IMPROVEMENTS |
| — ROAD RIGHT OF WAY LINE | — UTILITY POLE (BY OTHERS) |
| — PROPERTY LINE | — O.H. UTILITY LINE (BY OTHERS) |
| --- LIMIT OF EXISTING EASEMENT | — FIRE HYDRANT |
| --- EDGE OF PAVEMENT | — WATER GATE VALVE |
| --- EDGE OF GRAVEL | — CURB STOP/WATER SHUT-OFF |
| — UTILITY POLE | — WATER LINE |
| — EDGE OF WOODS | --- LIMIT OF WATERLINE EASEMENT |
| --- EXISTING 2-FOOT CONTOUR | --- EDGE OF PAVEMENT (BY OTHERS) |
| --- EXISTING 10' CONTOUR | |
| ⊕ STORMDRAIN MANHOLE | |
| ⊞ CATCHBASIN | |
| ⊞ FIRE HYDRANT | |
| ⊞ WATER GATE VALVE | |
| ⊞ CURB STOP/WATER SHUT-OFF | |
| — WATERLINE | |
| — STORMDRAIN LINE | |
| ⊞ CATCHBASIN | |

NOTE: THE ASBUILT DATA SHOWN HEREON IS BASED ON FIELD SURVEYED LOCATION OF VISIBLE IMPROVEMENTS AND ADDITIONAL INFORMATION AS SUPPLIED BY SYSTEM OWNER/OPERATOR DEAN HEDGES.

REVISED: 12/06/12 - 2012 CONSTRUCTION ASBUILT DATA ADDED; SEE NOTE - KKJ
 REVISED: 1/02/11 - HOUSE NUMBERING CORRECTED - KJ
 REVISED: 9/13/11 - PROJECT EXPANDED SOUTH ALONG ROUTE 14; SHEET 4A ADDED - KJ

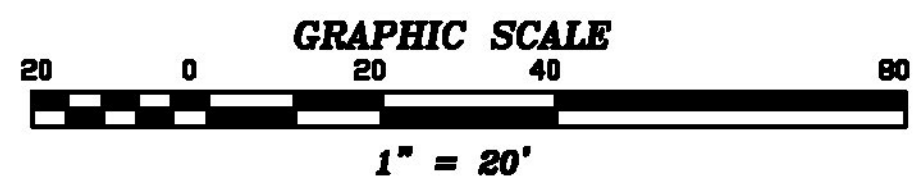

RECORD DRAWING



SITE PLAN
 PROPOSED IMPROVEMENTS
 CRYSTAL SPRINGS WATER CO.
 ROUTES 2 & 14 EAST MONTPELIER, VT

CHENETTE ASSOCIATES, P.C.
 BERNARD X. CHENETTE P.E.
 BERLIN, VERMONT

DRAWN BY: KKJ	SCALE: 1"=20'	DWG. NO. 11 016
CHECKED BY: BXC	DATE: 8/8/11	SHEET: SH 2 OF 5