




1 PLAN VIEW IN FORM
 PCI
 1/2" = 1'-0"

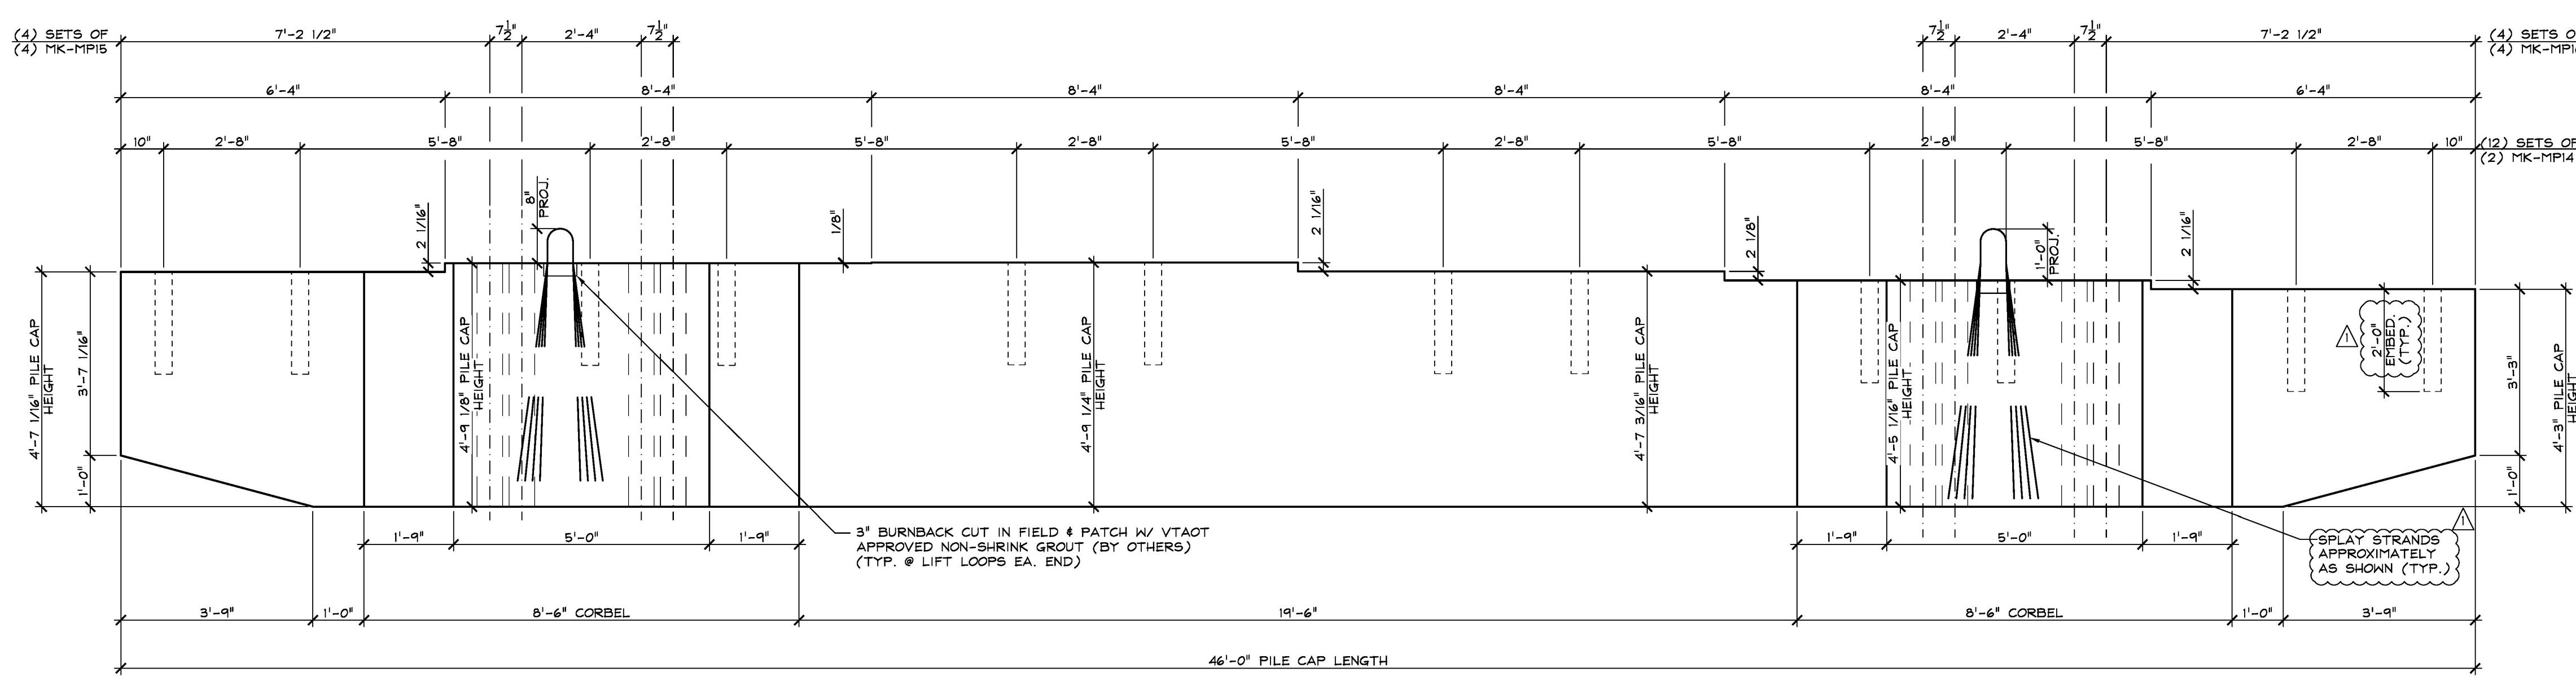

2 DIMENSIONAL ELEVATION
 PCI
 1/2" = 1'-0"

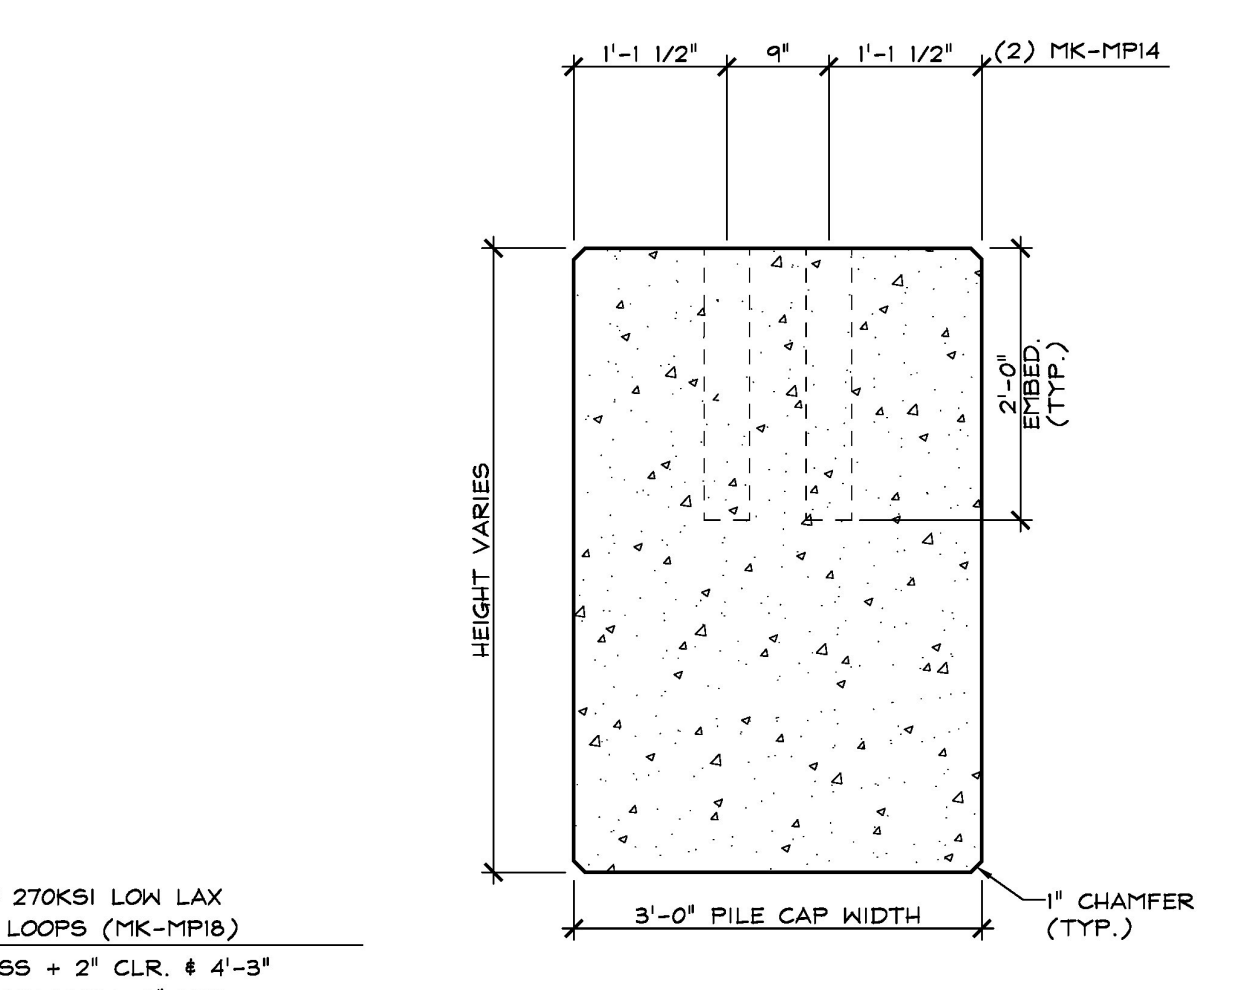

A DIMENSIONAL SECTION - 'A'
 PCI
 3/4" = 1'-0"

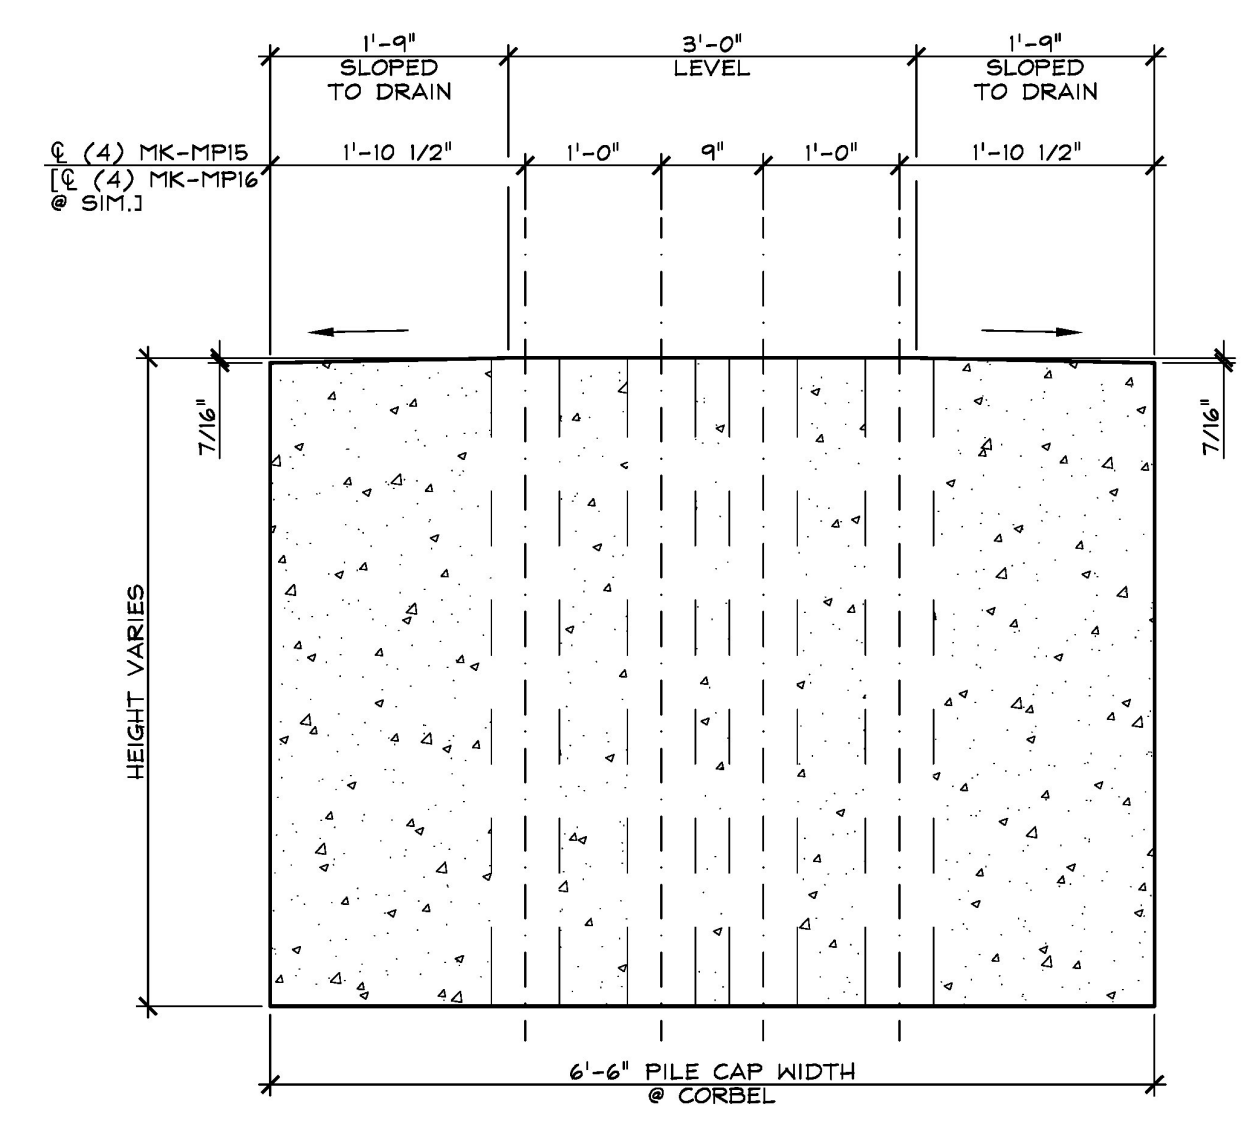

B DIMENSIONAL SECTION - 'B'
 PCI
 3/4" = 1'-0"

SHOP NOTE:
 f'c = 5,000 PSI
 f'ci = 4,000 PSI
 MIX # 426 LW (NO DCI)

10-11-17 REV. SUB. 4" GALV. SLEEVES FOR ANCHOR BOLTS & SUBMITTAL #1 COMMENTS

Vermont Agency of Transportation
RECEIVED
 CK'D BY Stantec OK'D BY Tom Knight
 October 13, 2017
 RESUBMIT No Approved
 BY Carolyn W. Carlson DATE 10/24/2017

MARK: MP-PCI QTY.: 1 WT.: 47.71 T VOL.: 29.45 cy			
MATERIAL LIST / PILE CAP			
ITEM	MARK	DESCRIPTION	QTY.
1			
2	MK-MPI4	4" GALV. SLEEVE X 2'-0"	24
3	MK-MPI8	6" HDPE CORRUGATED SLEEVE X 4'-9 1/8"	16
4	MK-MPI6	6" HDPE CORRUGATED SLEEVE X 4'-5 1/16"	16
5	MK-MPI8	(4) 0.600" Ø 270 KSI STRAND LIFT LOOPS	4
6			

APPROVAL STAMP:	J.P. CARRARA & SONS INC. Precast & Prestress Manufacturer 2644 GSE STR., WOODBURY, VERMONT 05753 Phone: (802)388-6361 Fax: (802)388-9010	CCS CONSTRUCTORS, INC. CONTRACTOR MORRISVILLE, VERMONT
STATE OF VERMONT AGENCY OF TRANSPORTATION COUNTY OF WASHINGTON		DATE: SEPT. 14, 2017 SCALE: NOTED
TOWN OF EAST MONTPELIER VT ROUTE 14, MINOR ARTERIAL BRIDGE NO.: 68 PROJECT NO.: BRF 037-1 (7)		CHKD: K.P. DFTM: A.S. JOB NO: 23515-017
PRECAST CONCRETE PILE CAP DIMENSIONAL DETAILS		DWG. NO: PCI