

MISCELLANEOUS MATERIALS

ITEM	MARK	QTY.	DESCRIPTION	REMARKS
1	MK-MP1	40	GTI 2 3/8" X 5'-0" 3/4" LONG CORRUGATED PT DUCT	(SUPPLIED BY OTHERS)
2	MK-MP2	40	GTI 1" X 3" TRANSITION PIECE	(SUPPLIED BY OTHERS)
3	MK-MP3	40	POST-TENSIONING TRUMPET (DSI 4 - 0.6" FLAT ANCHOR (GALV.) W/ HARDWARE	(SUPPLIED BY OTHERS)
4	MK-MP4	40	DSI POCKET FORMER	(SUPPLIED BY OTHERS)
5	MK-MP5	40	3/4" X 6" NPT PIPE NIPPLE	(SUPPLIED BY OTHERS)
6	MK-MP6	264	1" X 1'-2" LEVELING BOT (COIL THREAD)	
7	MK-MP7	264	1 3/8" O.D. 5 1/2" PVC PIPE SLEEVE	
8	MK-MP8	264	DAYTON 1" F-56 EXPANDED COIL INSERT (2-STRUT) (GALV.)	
9	MK-MP9	176	AT X 5 3/4" SWIFT LIFT LIFTER (GALV.) (DOMESTIC)	
10	MK-MP10	400	GTI 2 3/8" X 7'-11 3/16" LONG CORRUGATED PT DUCT	(SUPPLIED BY OTHERS)
11	MK-MP11	60	GTI 2 3/8" GROUT SADDLE	(SUPPLIED BY OTHERS)
12	MK-MP12	60	21 mm X 8' GTI GROUT TUBE	(SUPPLIED BY OTHERS)
13	MK-MP13	7	DAYTON #5 X 2'-6" DIA DOWEL BAR SPLICER (S.S.)	+3 FOR SAMPLING
14	MK-MP14	82	DAYTON C-24 TYPE 4-APR DECK FORM HANGER	GALVANIZED
15			AS REQ'D HEAT SHRINK	(SUPPLIED BY OTHERS)
16	EM-MP1	7	DAYTON #5 X 2'-6" DIA DOWEL-IN (S.S.)	+3 FOR SAMPLING
17				
18		160	#5 X 0'-5" (STAINLESS STEEL)	
19		(44)	#4 X 0'-5 1/2" (STAINLESS STEEL)	
20		(352)	#4 X 0'-11 1/2" (STAINLESS STEEL)	
21		42	#4 X 4'-0" (STAINLESS STEEL)	
22		62	#4 X 6'-2" (STAINLESS STEEL)	
23		400	#4 X 7'-1" (STAINLESS STEEL)	
24		528	#4 X 7'-7" (STAINLESS STEEL)	
25		39	#4 X 9'-9" (STAINLESS STEEL)	+1 FOR SAMPLING
26				
27		(44)	#5 X 0'-5 1/2" (STAINLESS STEEL)	
28		(356)	#5 X 0'-11 1/2" (STAINLESS STEEL)	
29		240	#5 X 2'-6" (STAINLESS STEEL)	
30		46	#5 X 4'-6" (STAINLESS STEEL)	
31		440	#5 X 7'-0" (STAINLESS STEEL)	
32		468	#5 X 7'-1" (STAINLESS STEEL)	
33		1060	#5 X 7'-7" (STAINLESS STEEL)	
34		71	#5 X 9'-9" (STAINLESS STEEL)	+1 FOR SAMPLING
35				
36		91	#6 X 3'-10 1/2" (STAINLESS STEEL)	+3 FOR SAMPLING
37		176	#6 X 4'-6 1/2" (STAINLESS STEEL)	
38		24	#6 X 5'-0" (STAINLESS STEEL)	
39		440	#6 X 7'-0" (STAINLESS STEEL)	
40				
41	MK-MP14	48	4" GALV. SLEEVE X 2'-0" LONG	
42	MK-MP15	32	6" HDPE CORRUGATED SLEEVE X 4'-9 1/8" LONG	
43	MK-MP16	16	6" HDPE CORRUGATED SLEEVE X 4'-5 1/16" LONG	
44	MK-MP17	16	6" HDPE CORRUGATED SLEEVE X 4'-5 3/16" LONG	
45	MK-MP18	8	SET OF (4) 0.600" STRAND LIFTING LOOPS X 5'-3" LONG	
46				
47		(5)	#4 X 30'-10" (BLACK)	+1 FOR SAMPLING
48		(16)	#4 X 45'-1" (BLACK)	
49		27	#5 X 3'-9" (BLACK)	+3 FOR SAMPLING
50		24	#5 X 4'-1" (BLACK)	
51		21	#10 X 30'-10" (BLACK)	
52				
53				
54				
55				

DECK SLABS

PIER CAPS

12-15-17 REVISIONS DECK SLAB SUBMITTAL #2 COMMENTS

11-2-17 REVISIONS DECK SLAB SUBMITTAL #1 COMMENTS

10-11-17 REV. PER JPC RFI RESPONSE # SUB. 4" GALV. SLEEVES FOR ANCHOR BOLTS

APPROVED: [Signature] APPROVAL STAMP: [Stamp]

REVISION AND RESUBMIT [] NOT REVIEWED []

Date: 2/14/17

By: [Signature]

This review by Stantec Consulting Services Inc. is for the sole purpose of ascertaining conformance with the general design concept. This review shall not mean that Stantec is responsible for which shall remain with the Contractor. Submitting same, and such review shall not relieve the Contractor of his responsibility for errors or omissions in the shop drawing or of his responsibility for meeting all requirements of the Contract Documents. The contractor is responsible for dimensions to be confirmed and correlated at the job site, for information that pertains solely to the fabrication process or to techniques of construction and installation and for coordination of the work of all subcontractors.

J.P. CARRARA & SONS INC.
Precast & Prestress Manufacturer
264 OISE ST., WOODBURY, VERMONT 05753 Phone: (802)388-6361 Fax: (802)388-8010

CCS CONSTRUCTORS, INC.
CONTRACTOR
MORRISVILLE, VERMONT


STATE OF VERMONT AGENCY OF TRANSPORTATION
COUNTY OF WASHINGTON

DATE: SEPT. 14, 2017
SCALE: NOTED
CHKD: K.P. DFTM: A.S.
JOB NO: 23515-017
PROJECT NO.: BRF 037-1 (7)



MATERIALS SHEET

DWG. NO: M1

PRECAST DECK SLABS

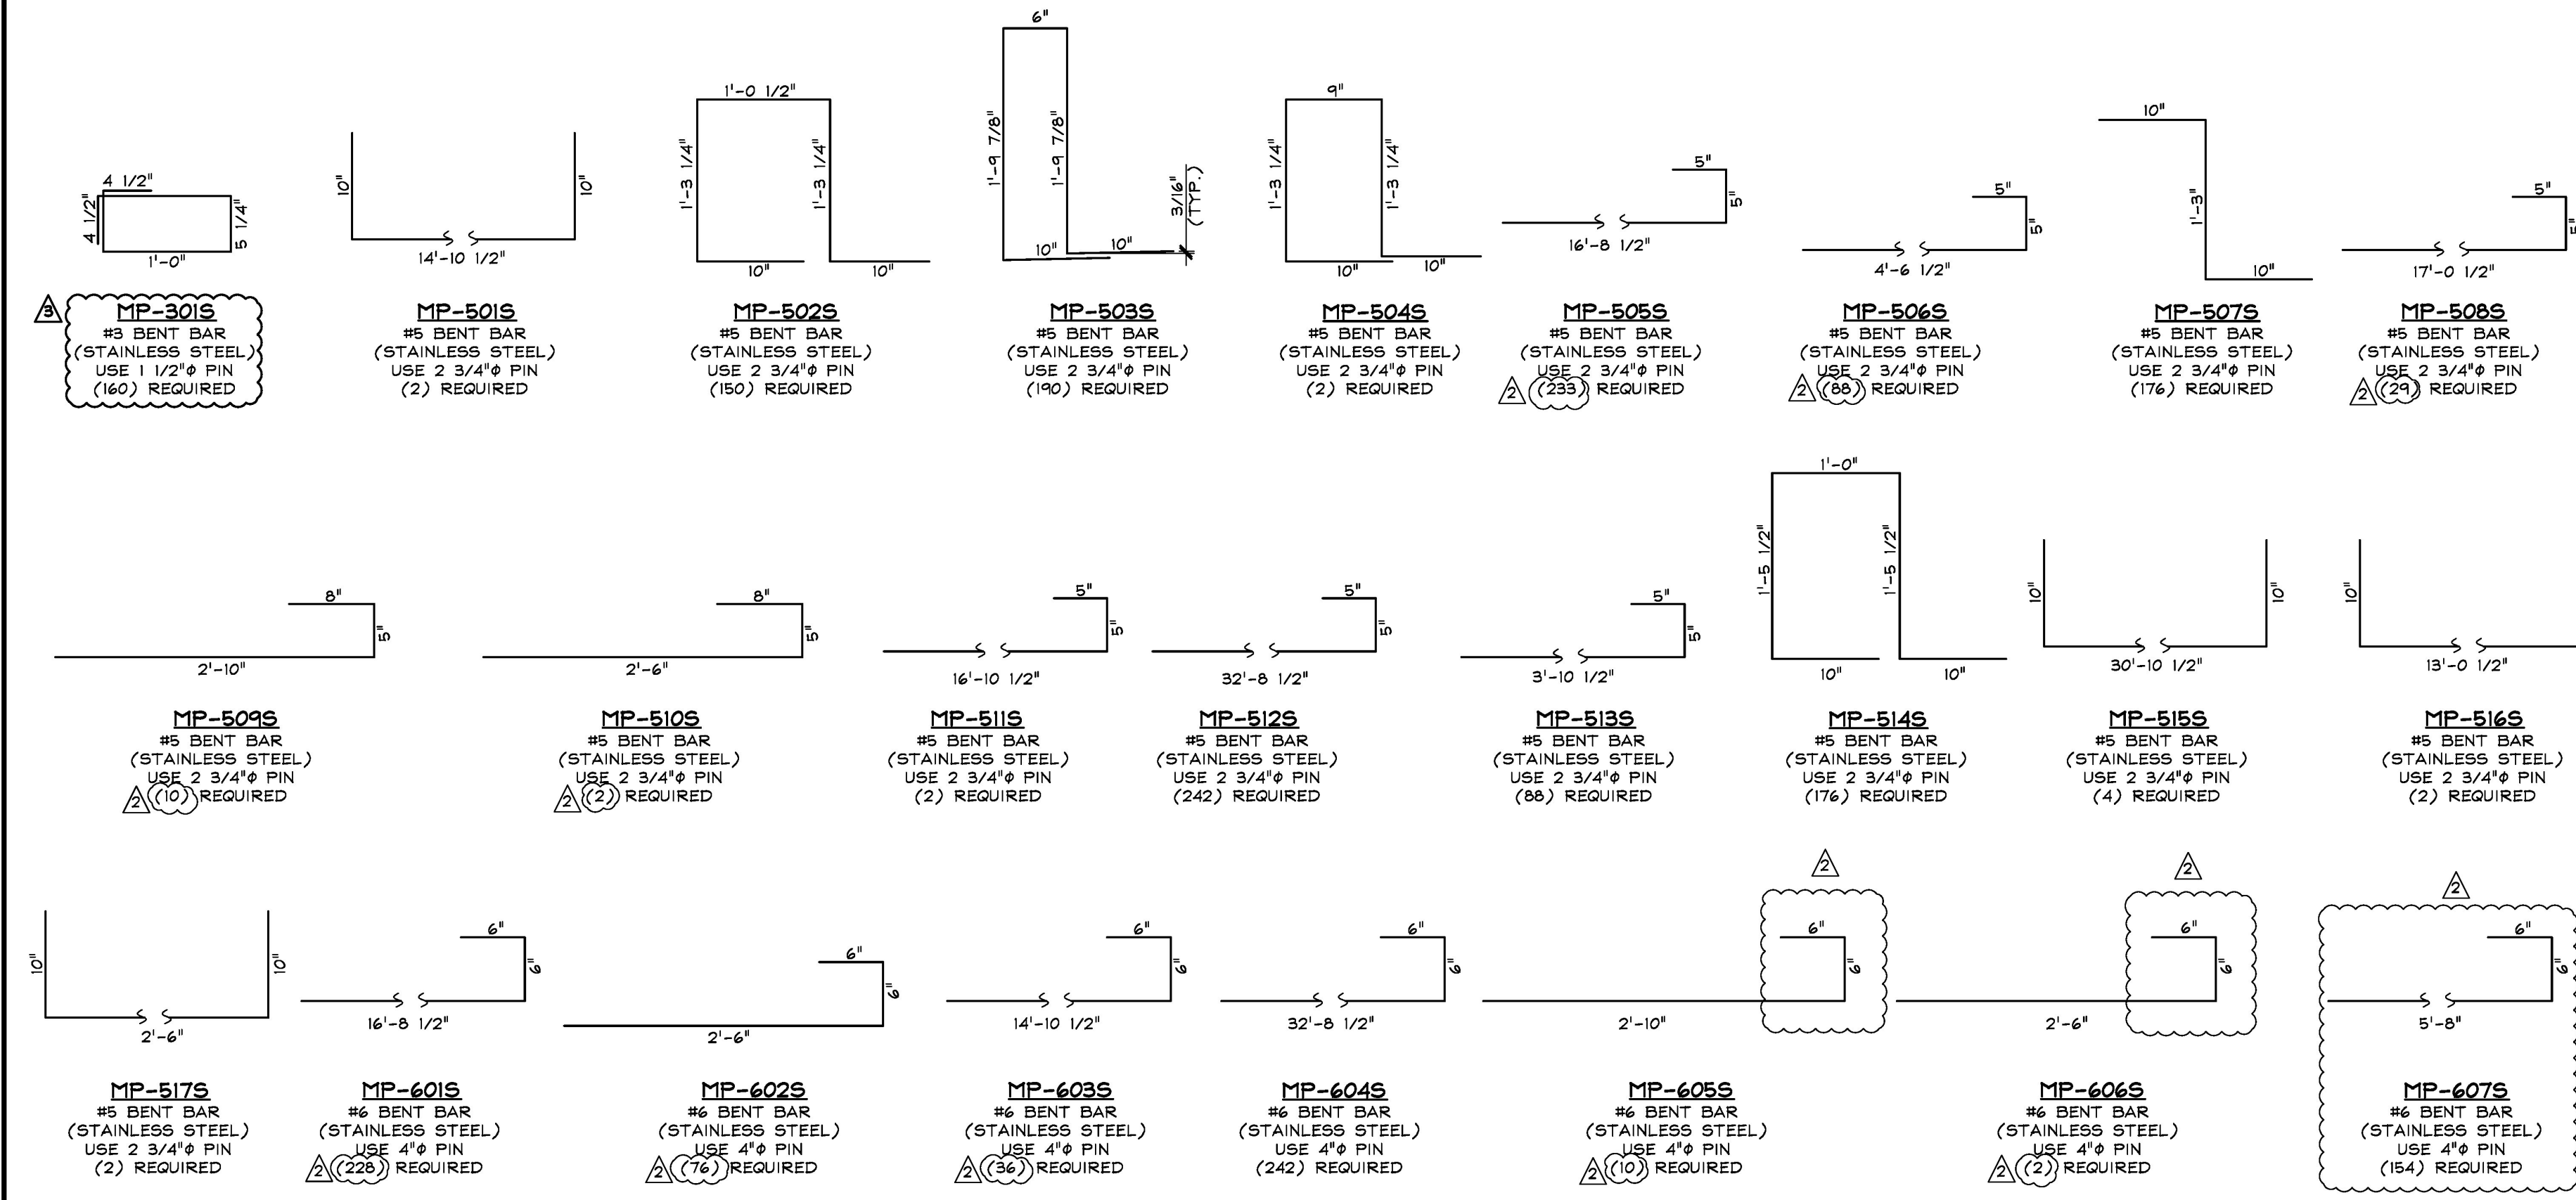

PRECAST PIER CAPS

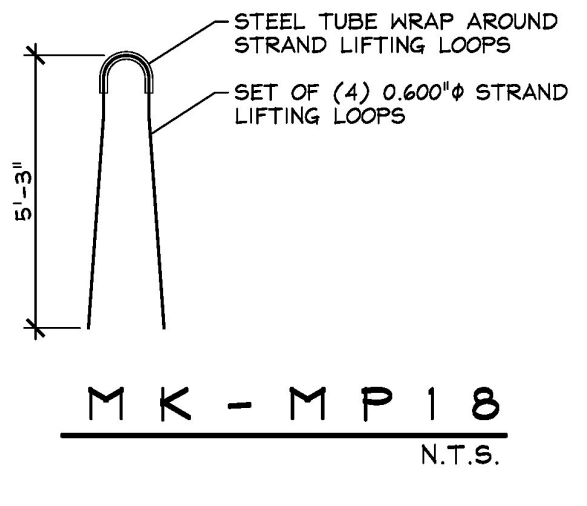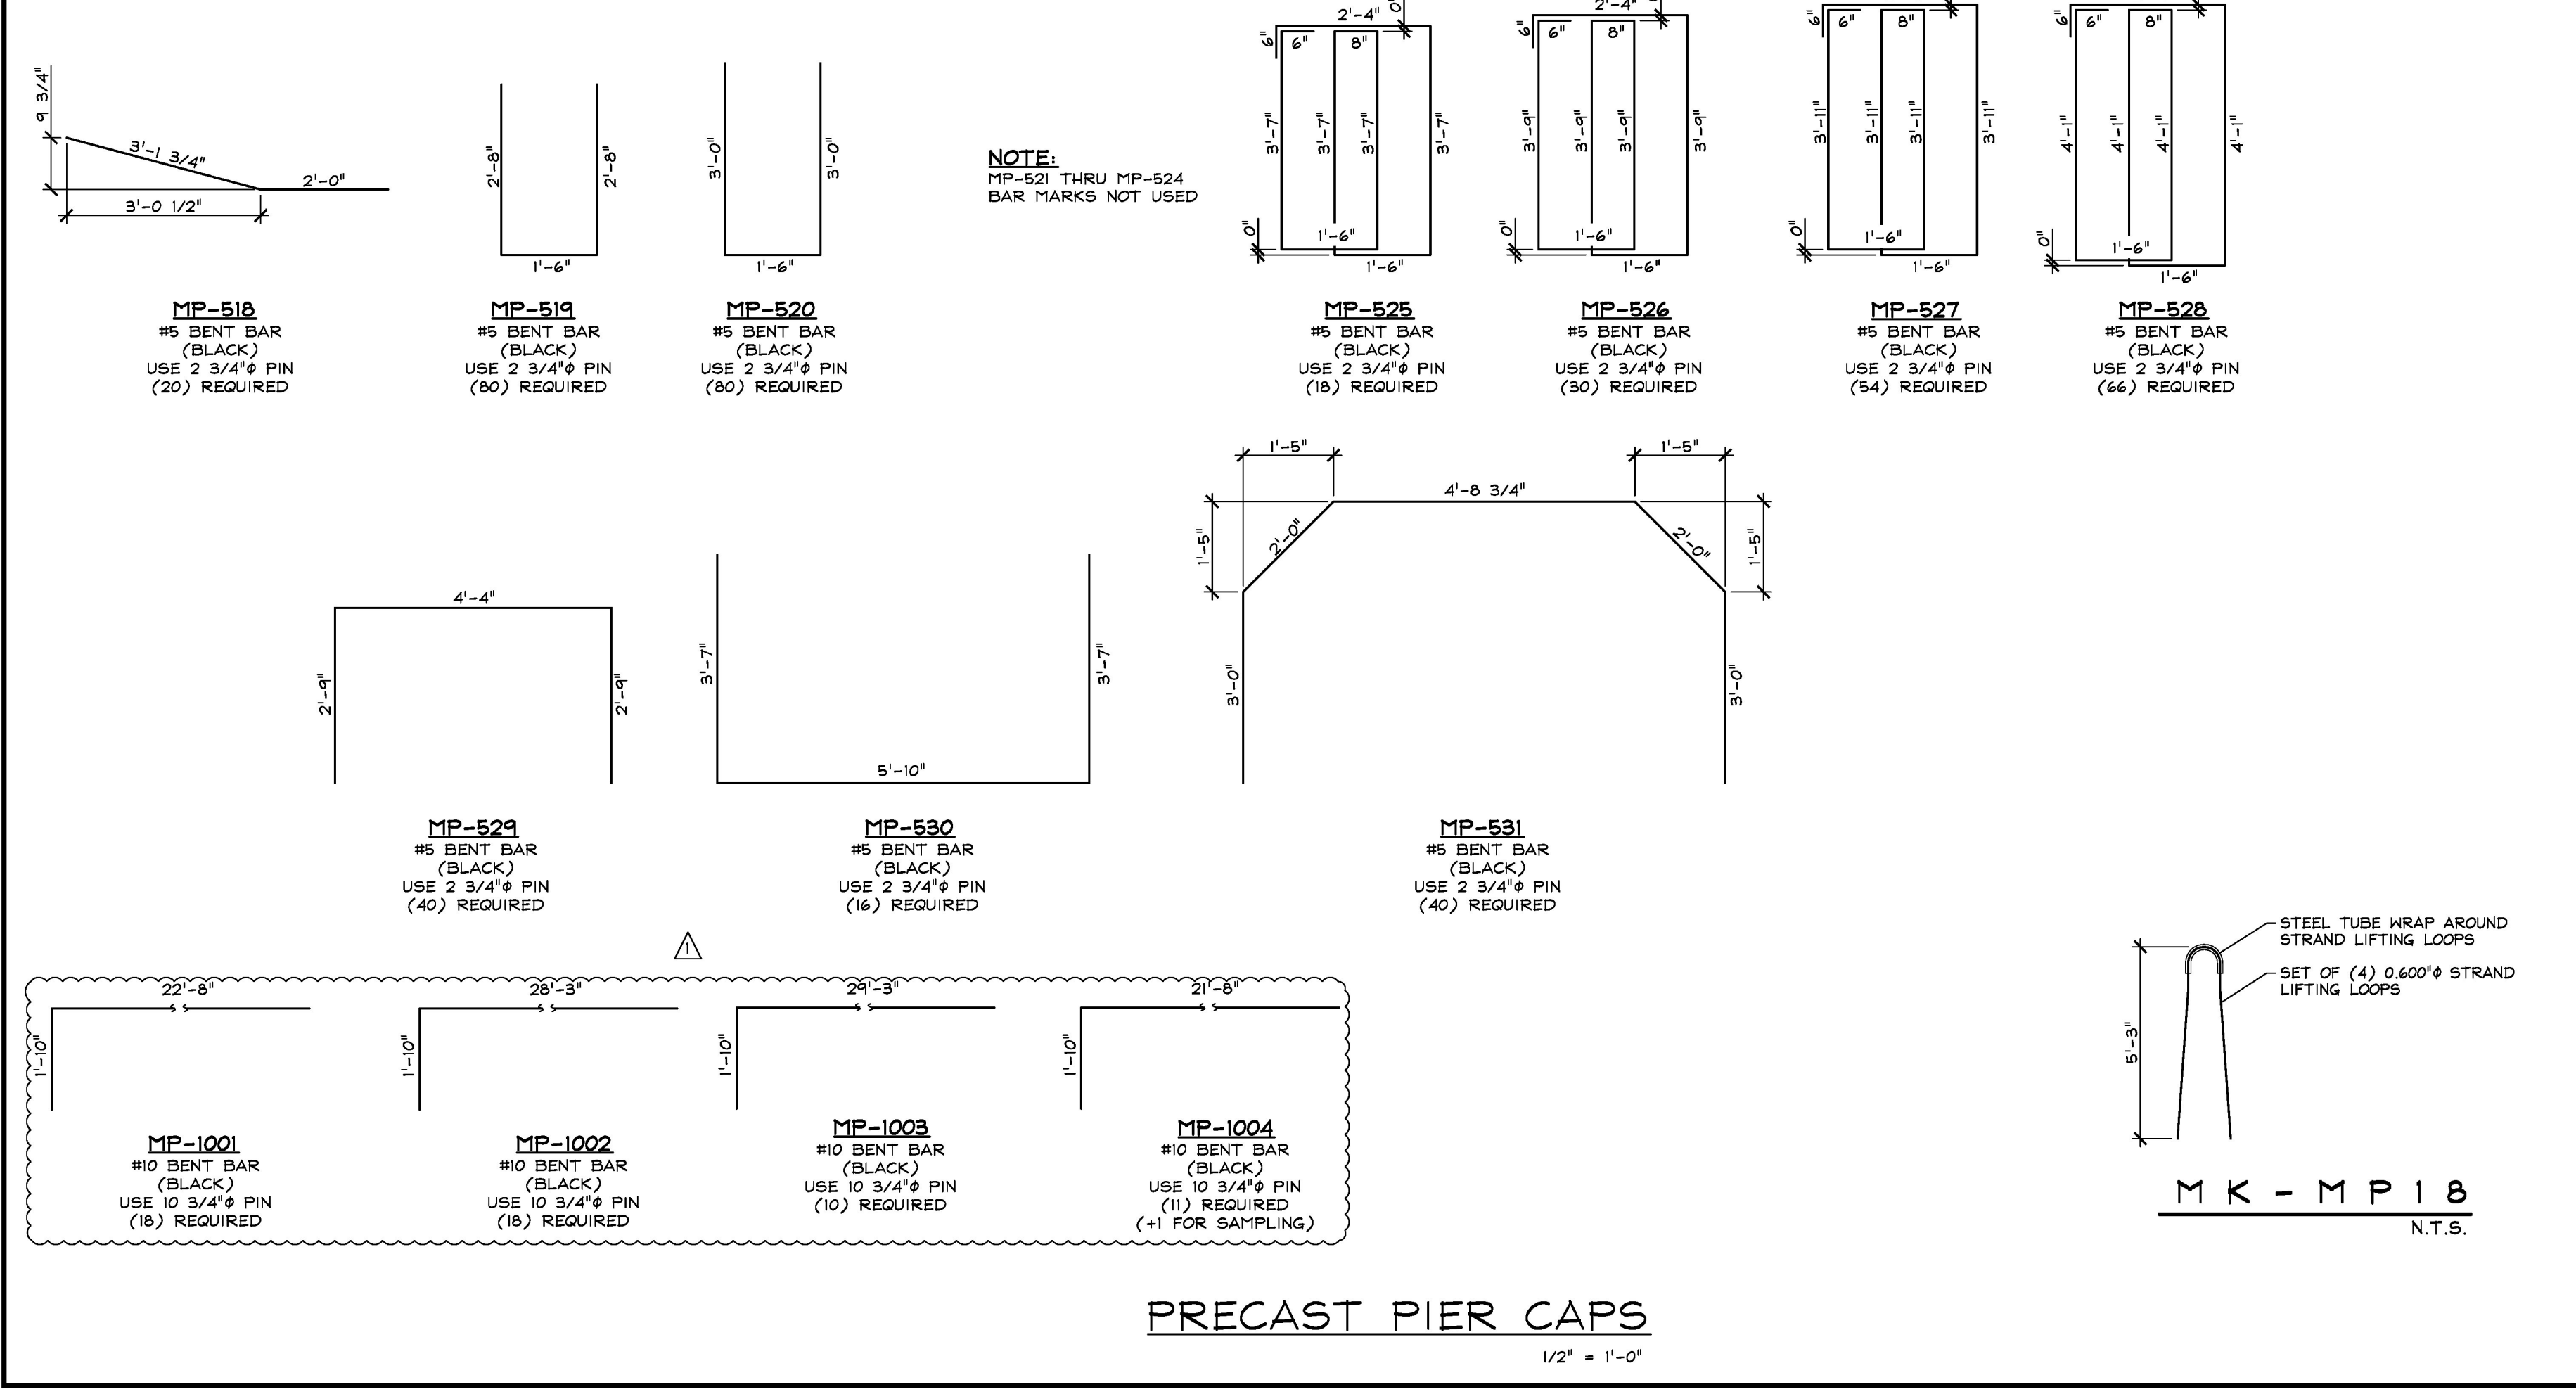

PRECAST PIER CAPS

1/2" = 1'-0"